

PREPARED FOR:
RAULAND AGENCY INC
118 KENOSHA ST.
P.O. BOX 159
WALWORTH, WI
53184

PLAT OF SURVEY

- OF -

J.K. SURVEYING INC.
N3705 WILLOWBEND LANE
LAKE GENEVA, WI, 53147
262-248-3697

CL GLENWOOD ROAD

(33' WIDE)

DESCRIPTION: ALL OF LOTS 909 - 913 AND
ALL OF LOTS 934 - 938, BLOCK 11, OF
PELL LAKE HIGHLANDS, A SUBDIVISION
OF THE SE1/4 OF SECTION 16, T1N, R18E,
BLOOMFIELD TOWNSHIP, WALWORTH
COUNTY, WISCONSIN.



PLEASE NOTE ; BEARINGS ARE ASSUMED
AS SHOWN ON THE RECORDED SUBDIVISION PLAT

CROSS IN
CONCRETE DRIVE

CONCRETE IS
OVER THE LINE
BY 1.49'

NEIGHBORS
GARAGE IS WEST
OF THE LINE 1.34'

NEIGHBORS
GARAGE IS WEST
OF THE LINE 2.47'

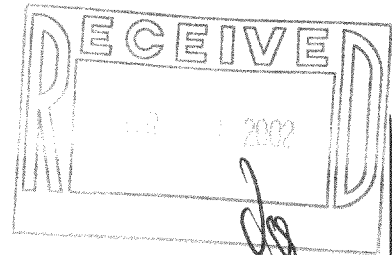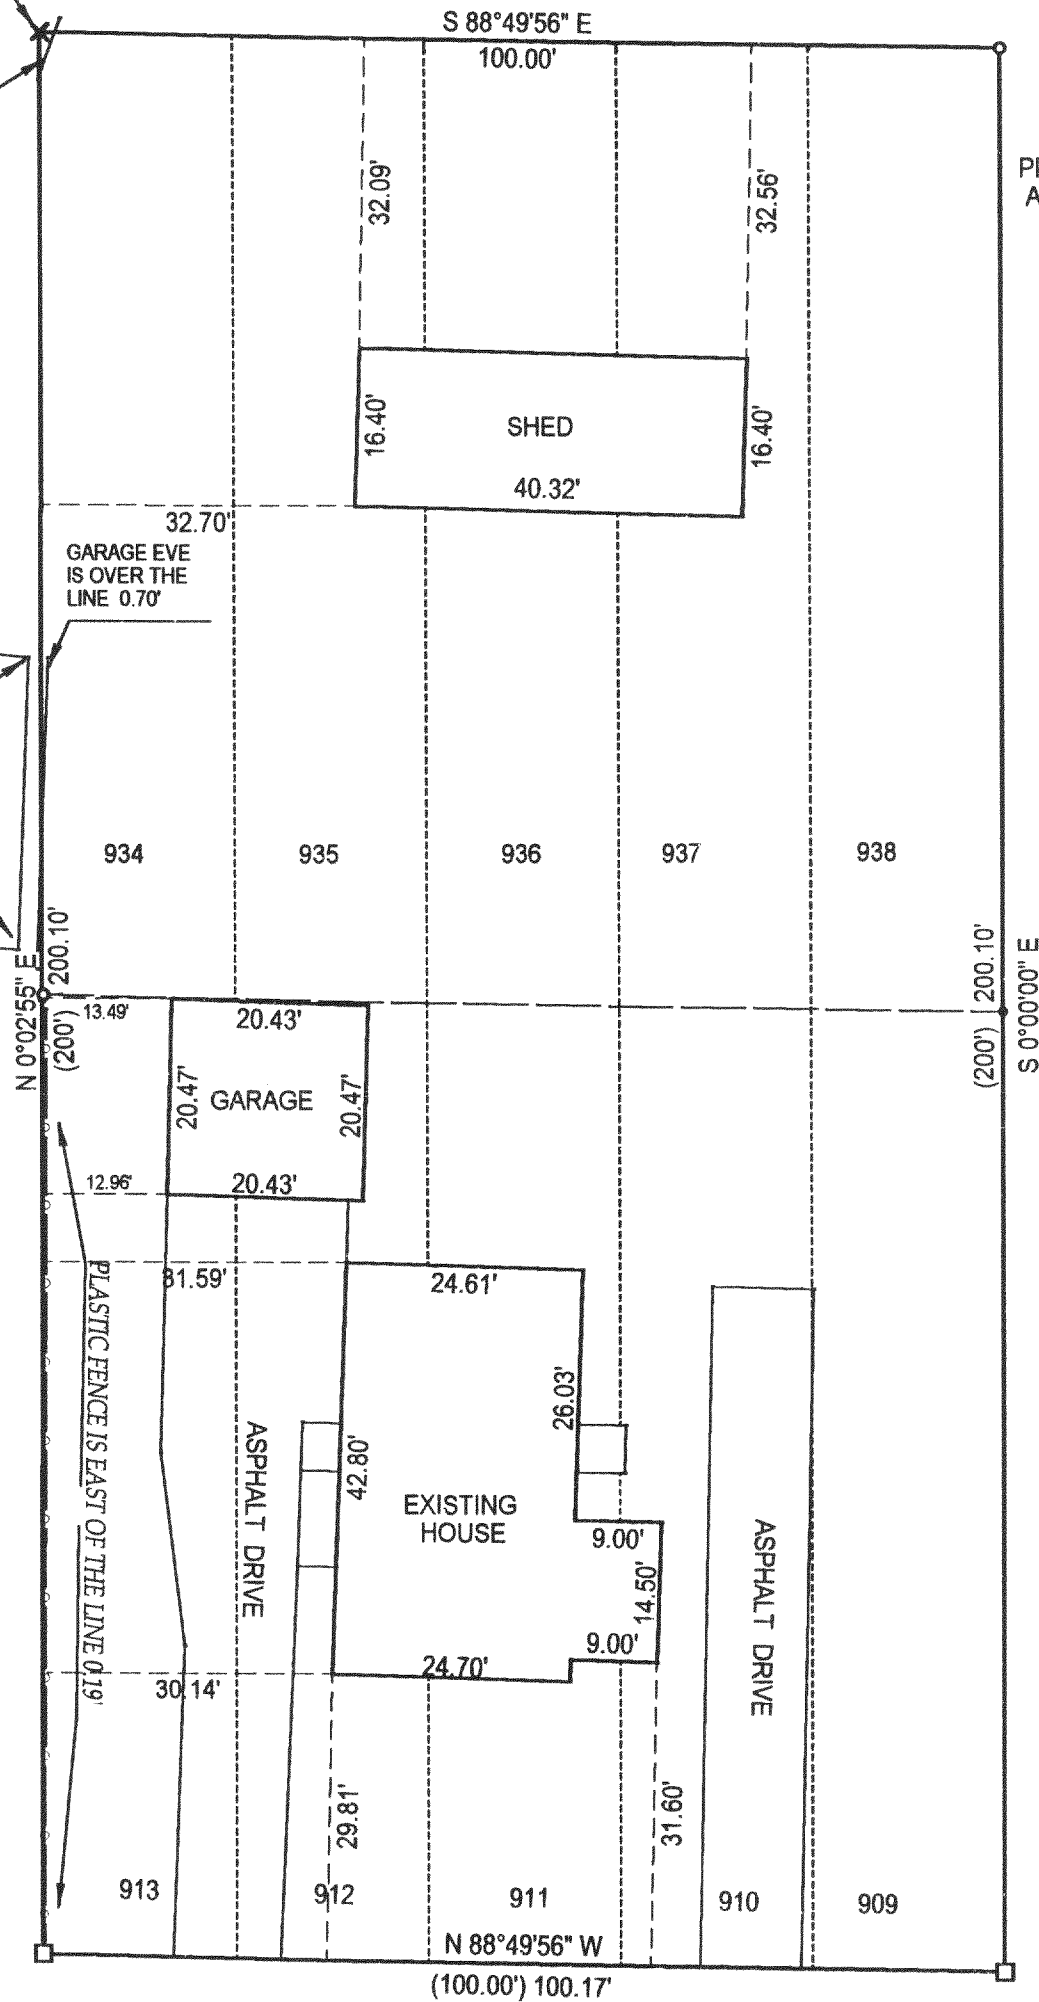

NORTH

() = recorded as

□ = found iron bar

○ = found iron pipe

● = set iron pipe

■ = set iron bar

SCALE 1" = 20'

JOB # 01-476

TAX ID # MPLH - 192A

CL OAK WOOD ROAD


(33' WIDE)

COMPARE LEGAL DESCRIPTION ABOVE AND DRAWING WITH DEED. FOR BUILDING RESTRICTIONS AND
EASEMENTS NOT SHOWN, REFER TO DEED, ABSTRACT SOURCES AND LOCAL MUNICIPAL CODES. NOTIFY
THE SURVEYOR IMMEDIATELY OF ANY DISCREPANCY.

"I hereby certify that I have surveyed the above described property and that
the above map is a true representation thereof and shows the size and
location of all visible structures, apparent easements and encroachments
if any."

This survey is made for the present owners of the property, and those who
purchase, mortgage, or guarantee the title thereto, within one year from
the date hereof.

DATED THIS 5TH, DAY OF NOVEMBER, 2001.

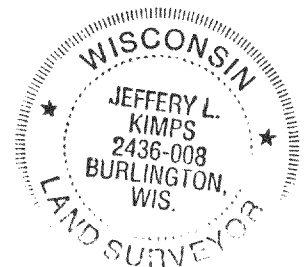

JEFFREY L. KIMPS S - 2436
Wisconsin Registered Land Surveyor
(original if signed in red)

118-2102