


PLAT OF SURVEY OF


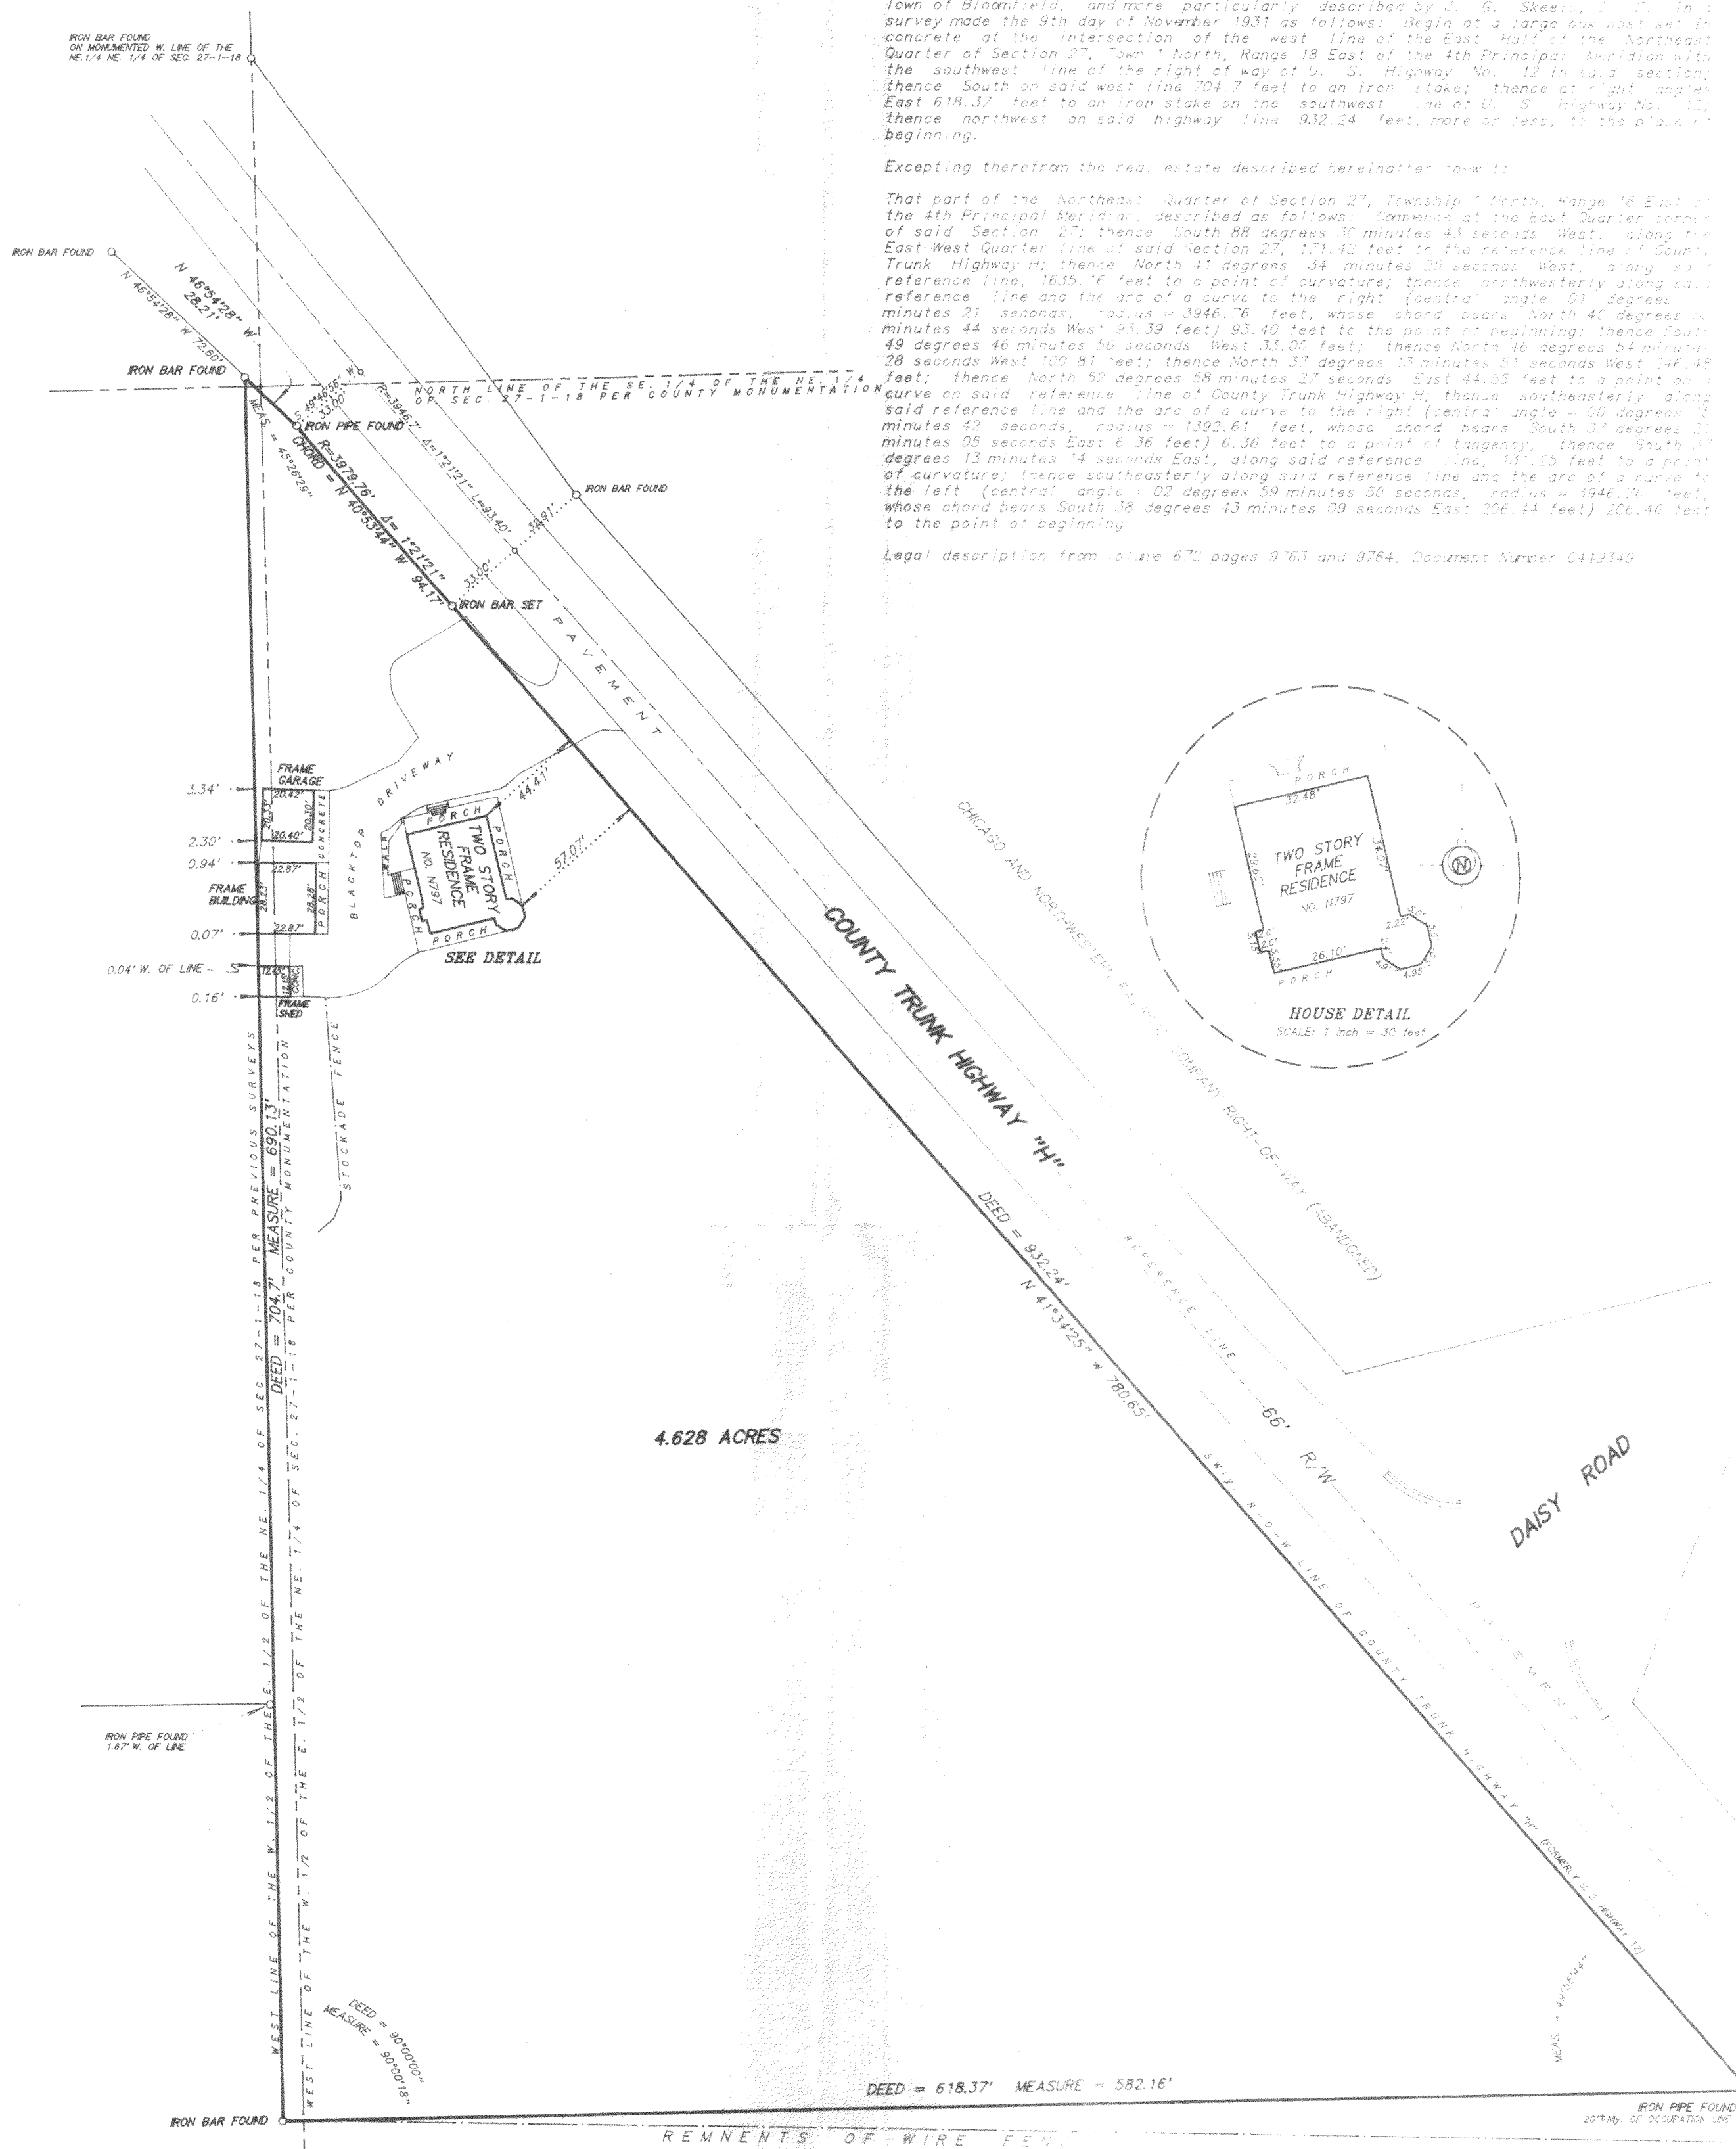


The North 5 acres of the West Half of the East Half of the Northeast Quarter that lies west and south of the Chicago and Northwestern Railroad Company tracks in Section 27, Town of Bloomfield, and more particularly described by J. G. Skeels, Jr. E. in a survey made the 9th day of November 1931 as follows: Begin at a large oak post set in concrete at the intersection of the west line of the East Half of the Northeast Quarter of Section 27, Town 1 North, Range 18 East of the 4th Principal Meridian with the southwest line of the right of way of U. S. Highway No. 12 in said section; thence South on said west line 704.7 feet to an iron stake; thence at right angles East 618.37 feet to an iron stake on the southwest line of U. S. Highway No. 12; thence northwest on said highway line 932.24 feet, more or less, to the place of beginning.

Excepting therefrom the real estate described hereinafter to-wit:

That part of the Northeast Quarter of Section 27, Township 1 North, Range 18 East of the 4th Principal Meridian, described as follows: Commence at the East Quarter corner of said Section 27; thence South 88 degrees 36 minutes 43 seconds West, along the East-West Quarter line of said Section 27, 171.42 feet to the reference line of County Trunk Highway H; thence North 41 degrees 34 minutes 20 seconds West, along said reference line, 1635.77 feet to a point of curvature; thence northwesterly along said reference line and the arc of a curve to the right (central angle = 01 degrees 21 minutes 44 seconds West 93.40 feet) 93.40 feet to the point of beginning; thence South 49 degrees 46 minutes 56 seconds West 33.00 feet; thence North 46 degrees 54 minutes 28 seconds West 100.81 feet; thence North 37 degrees 13 minutes 51 seconds West 246.48 feet; thence North 52 degrees 38 minutes 27 seconds East 44.55 feet to a point on a curve on said reference line of County Trunk Highway H; thence southeasterly along said reference line and the arc of a curve to the right (central angle = 02 degrees 15 minutes 42 seconds, radius = 1392.61 feet, whose chord bears South 37 degrees 37 minutes 05 seconds East 6.36 feet) 6.36 feet to a point of tangency; thence South 37 degrees 13 minutes 14 seconds East, along said reference line, 131.28 feet to a point of curvature; thence southeasterly along said reference line and the arc of a curve to the left (central angle = 02 degrees 59 minutes 50 seconds, radius = 3946.76 feet, whose chord bears South 38 degrees 43 minutes 09 seconds East 206.44 feet) 206.44 feet to the point of beginning.

Legal description from Volume 672 pages 9763 and 9764, Document Number 0449349

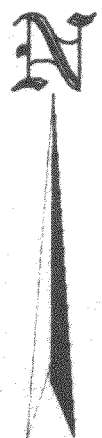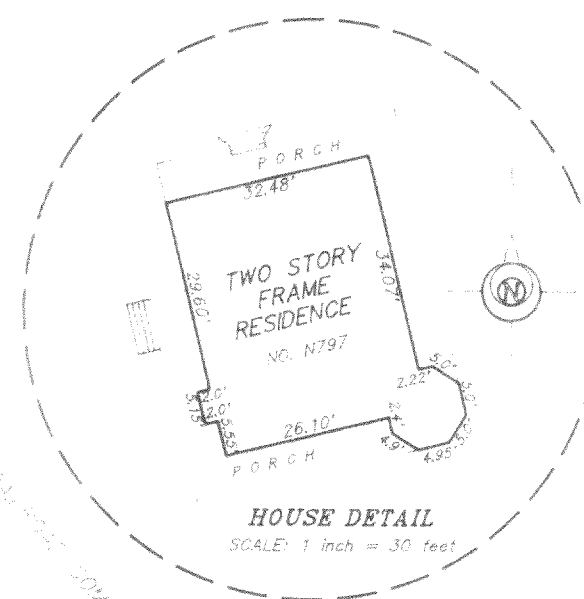

SCALE 1 inch = 50 feet

ORDERED BY A. Pierce / A. R. Pierce & Associates

JOB NO. 01308

PIN: MB 27 00003

NOTE: This survey is a retracement of a survey by Robert M. Baerwald, dated April 26, 2000. R.L.S. No. S - 1508
The recorded deed, Doc. No. 0449349, does not describe the present parcel accurately.

I hereby certify that I have surveyed the above described property and the above plat is a true representation thereof and shows the size and location of the property, its exterior boundaries, the location and dimensions of all visible structures thereon, boundary fences, apparent easements and roadways and visible encroachments, if any.

This survey is made for the exclusive use of the present owners of the property, and also those who purchase, mortgage, or guarantee the title thereto within one year from the date hereof.

Dated at Bassett, Wisconsin this 11 day of May, 2001.

Mark A. Bolender
Wisconsin Registered Land Surveyor S - 1784

