

39 Request for survey of ⁴⁰ ~~lots~~ ^{at} ~~5816-17-18-19-20~~ ^{Pell Lake}
 of old Gronfur 969 Hill Road
 Le. Metka Ill.
 then one + Orchid ^{at} ~~Pell Lake~~
 Road + Drive
 45.06 on Anemone Road
 Stks. at Cor. on Lot 58 21. 100 apart
 Front of lots 20.65' 5 lots 103, 25'
 Back of lots 20' each, 100'

4 Fronts on Orchid Drive and
 Anemone Road
 Anemone Road runs East + West
 Made the survey on
 May 16.

First checked Gronfur's
 home lot an already
 staked, found iron stks
 at at all Cor's OK

Measured West on Anemone
 South line 95.06 from
 Gronfur's N.W. Cor. 95.06'
 and found iron sta set
 by some one in 12. 4500 ft
 West + North about 10'


Corrected and reset
 iron sta on Orchid
 Drive at 95.06' from
 Gronfur's N.W. Cor.
 Measured ~~East~~ West
 from Gronfur's
 Northwest Cor. 95.06'

and checked the square ⁴⁰

then laid out 103.7'
 Extended the S. line
 of this square
 to the given distance
 103.7' on South line
 121.7' from Gronfur's S.W.
 Cor. for the N.W. Cor.
 of this survey on Orchid
 Drive and found a
 small pile of small
 stones set apparently
 for this Cor. with
 measured from end
 pile of small stones
 to N.E. Cor. of tract
 surveyed 103.7' OK
 Land surveyed is
 100' 100' East line
 103.7' West line West
 95.06' N. line
 103.7' W. or orchid
 line

7

May 16-1833
Request for survey
Orchid Grove
Orchid Grove
Orchid Grove

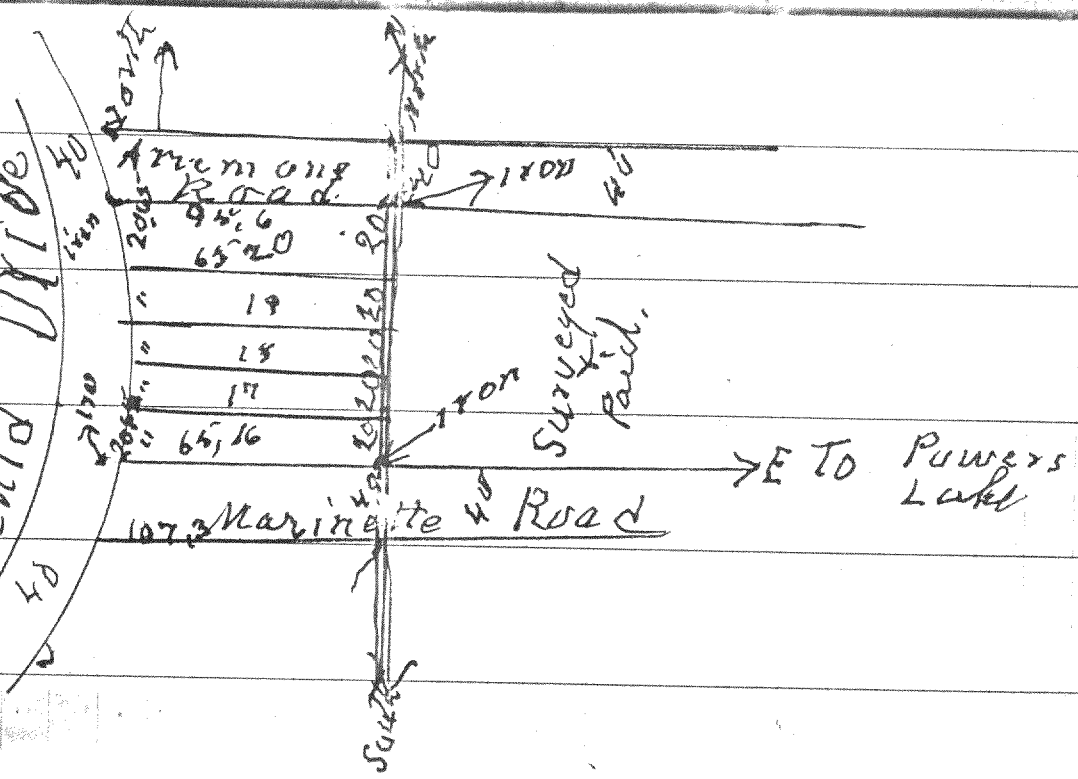

718-210 Sk