

120.00'

112.23'

89°17'55"

7.77'

IRON PIPE 0.84' SOUTH & 0.40' EAST OF CORNER

199.82' (200')

89°42'05"

08.84'

0.85'

199.83' (200')

DOG PEN

34

35

36

37

38

39

23.9'

2.1'

24.0'

21.1'

28.1'

27.8'

57.8'

57.8'

FOUNDATION

32.0'

98.17'

21.5'

46'

5'

90°14'55"

GRAVEL DRIVEWAY


120.00'

89°18'05"

IRON PIPE 2.10' SOUTH & 0.70' WEST OF CORNER

IRON PIPE 3.98' SOUTH OF CORNER

Ø-IRON PIPE FOUND
 Ø-IRON ROD FOUND
 ■-CONCRETE MONUMENT FOUND
 O-IRON PIPE PLACED
 ()-RECORDED AS

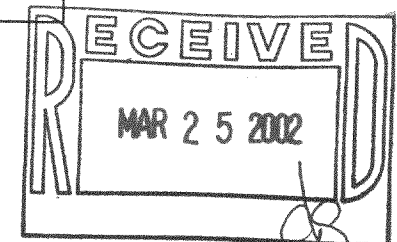

NOTE: THIS IS NOT A CERTIFIED COPY UNLESS SEALED.

PELL LAKE DRIVE

MPFA-WF

118-2110