

116 E. CHESTNUT STREET
BURLINGTON, WISCONSIN 53105
PHONE: 414-763-2652

ROBERS & BOYD, INC.
CONSULTING ENGINEERS
LAND SURVEYORS

809 - 43RD STREET
KENOSHA, WISCONSIN 53140
PHONE: 414-658-4488


PLAT OF SURVEY & HOUSE LOCATION

for
CENTURY 21
of

Lots 5811 to 5815 inclusively, Section 4, Pell Lake Subdivision, T 1 N.,
R 18 E., Township of Bloomfield, County of Walworth, State of Wisconsin.

NOTE:

There is an apparent 20 foot
error in the recorded plat
for lots 5811 to 5815
which results in less width
in the East-West direction.

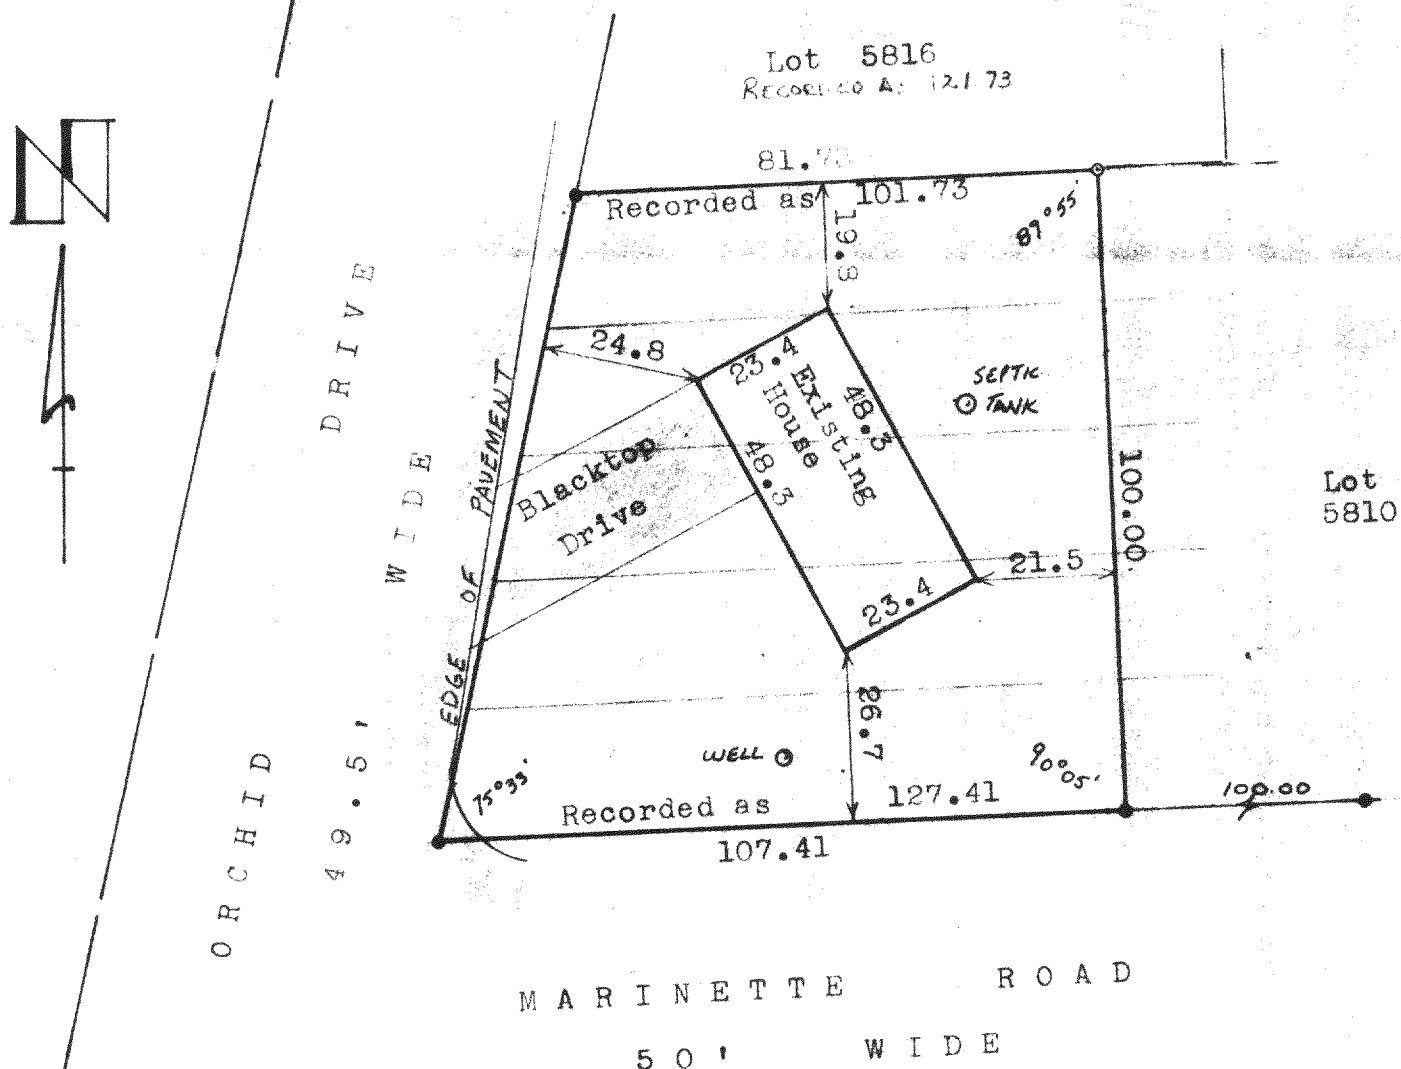

* L E G E N D *
● Found Iron Pipe
○ Set 1" Iron Pipe

SCALE 1" = 30'
DATE Aug. 31, 1978
JOB NO. 78218

"I have surveyed the above-described property, and the above map is a true representation thereof and shows the size and location of the property, its exterior boundaries, the location and dimensions of all visible structures thereon, fences, apparent easements and roadways and visible encroachments, if any.

This survey is made for the exclusive use of the present owners of the property, and also those who purchase, mortgage, or guarantee the title thereto, within one year from date hereof.

Dated at BURLINGTON, this 31st day
of August, 1978.

Kenneth R. Reesman
Surveyor

