



PLAT OF SURVEY

OF

J.K. SURVEYING INC.
N3705 WILLOWBEND LANE
LAKE GENEVA, WI, 53147
262-248-3697

LOTS 1093, 1094, 1095, 1096, AND 1097 BLOCK 25 PELL LAKE SUBDIVISION,
RECORDED IN THE OFFICE OF THE REGISTER OF DEEDS IN AND FOR THE COUNTY
OF WALWORTH AND THE STATE OF WISCONSIN ON THE 16TH DAY OF JULY 1924.

PREPARED FOR: MARK VALANGO

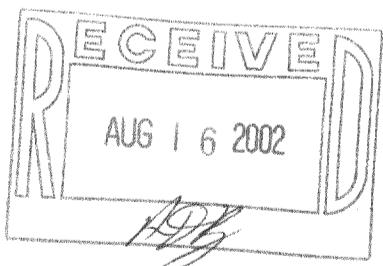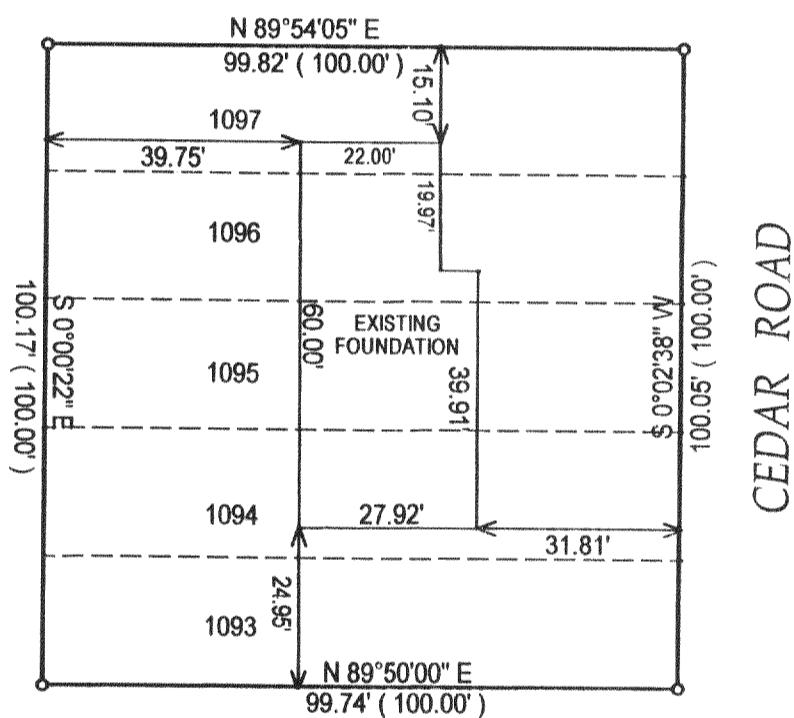

- () = recorded as
- = set iron bar
- = found iron bar
- = found iron pipe
- = set iron pipe

Direction is Assumed

COMPARE LEGAL DESCRIPTION ABOVE AND DRAWING WITH DEED. FOR BUILDING RESTRICTIONS AND EASEMENTS NOT SHOWN, REFER TO DEED, ABSTRACT SOURCES AND LOCAL MUNICIPAL CODES. NOTIFY THE SURVEYOR IMMEDIATELY OF ANY DISCREPANCY.

JOB# 00-243B

SCALE: 1"=30'

TAX KEY #

DATE OF LAST REVISION 8-02-02

DATED THIS 5 TH DAY OF JUNE 2000



JEFFREY L. KIMPS S-2436-008

MPL-238B

118-2144