


LOTS 8443, 8444, 8445, 8446, 8447, 8448, AND 8449, BLOCK 178, SECTION 5 OF PELL LAKE, A SUBDIVISION OF PART OF THE WEST 1/2 OF SECTION 22, T.1N., R.18E., OF THE FOURTH PRINCIPAL MERIDIAN, TOWN OF BLOOMFIELD, COUNTY OF WALWORTH, STATE OF WISCONSIN.

SURVEYOR'S CERTIFICATE: I HEREBY CERTIFY THAT THE LANDS DEPICTED HEREON HAVE BEEN SURVEYED UNDER MY DIRECTION AND THAT THE PLAT HEREON DRAWN IS A CORRECT REPRESENTATION OF SAID SURVEY.

GREGORY A. REESMAN
LAND SURVEYOR S-1019
KANSASVILLE, WISCONSIN

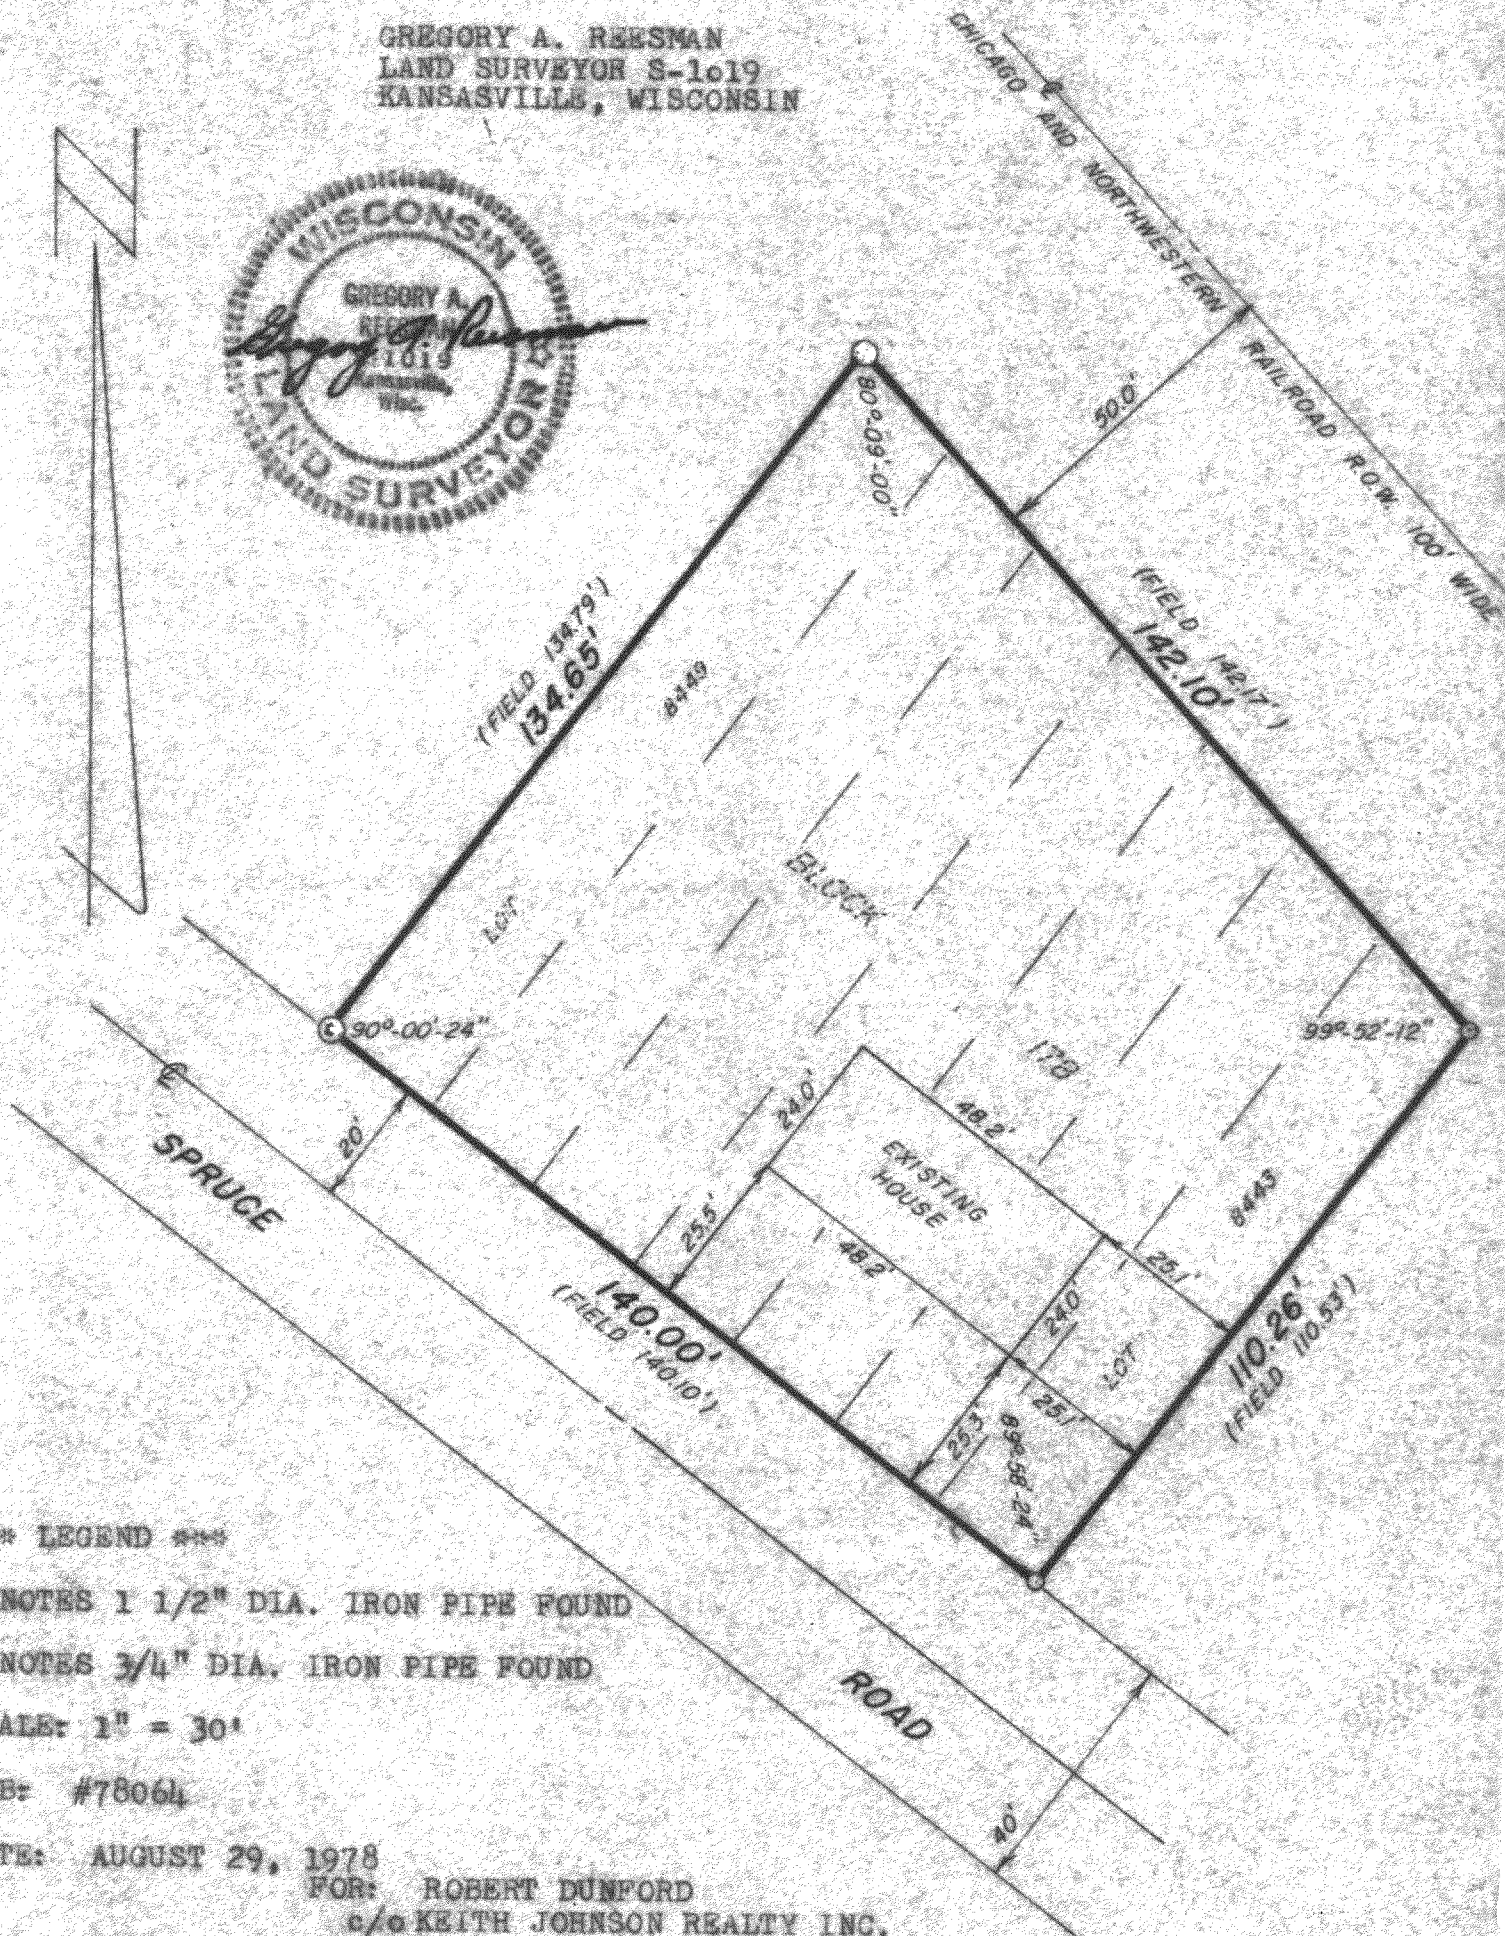

*** LEGEND ***

- DENOTES 1 1/2" DIA. IRON PIPE FOUND
- DENOTES 3/4" DIA. IRON PIPE FOUND

SCALE: 1" = 30'

JOB: #78064

DATE: AUGUST 29, 1978

FOR: ROBERT DUNFORD
c/o KEITH JOHNSON REALTY INC.
ROUTE 50 & 83
(BRASS BALL CORNERS)
PADDOCK LAKE, WISCONSIN 53168