


PLAT OF SURVEY

-OF-

LOTS 676, 677, 678, 679, AND 680, BLOCK 15, PELL LAKE HIGHLANDS, LOCATED IN THE NORTH 1/2 OF THE SOUTHEAST 1/4, THE SOUTHWEST 1/4 OF THE SOUTHEAST 1/4, AND THE SOUTHEAST 1/4 ALL IN SECTION 16, TOWN 1 NORTH, RANGE 18 EAST, TOWN OF BLOOMFIELD, WALWORTH COUNTY, WISCONSIN.

SURVEY FOR: RE/MAX SOUTHERN LAKES
SURVEY LOCATION: W1363 HIGHLAND BOULEVARD

HIGHLAND BOULEVARD

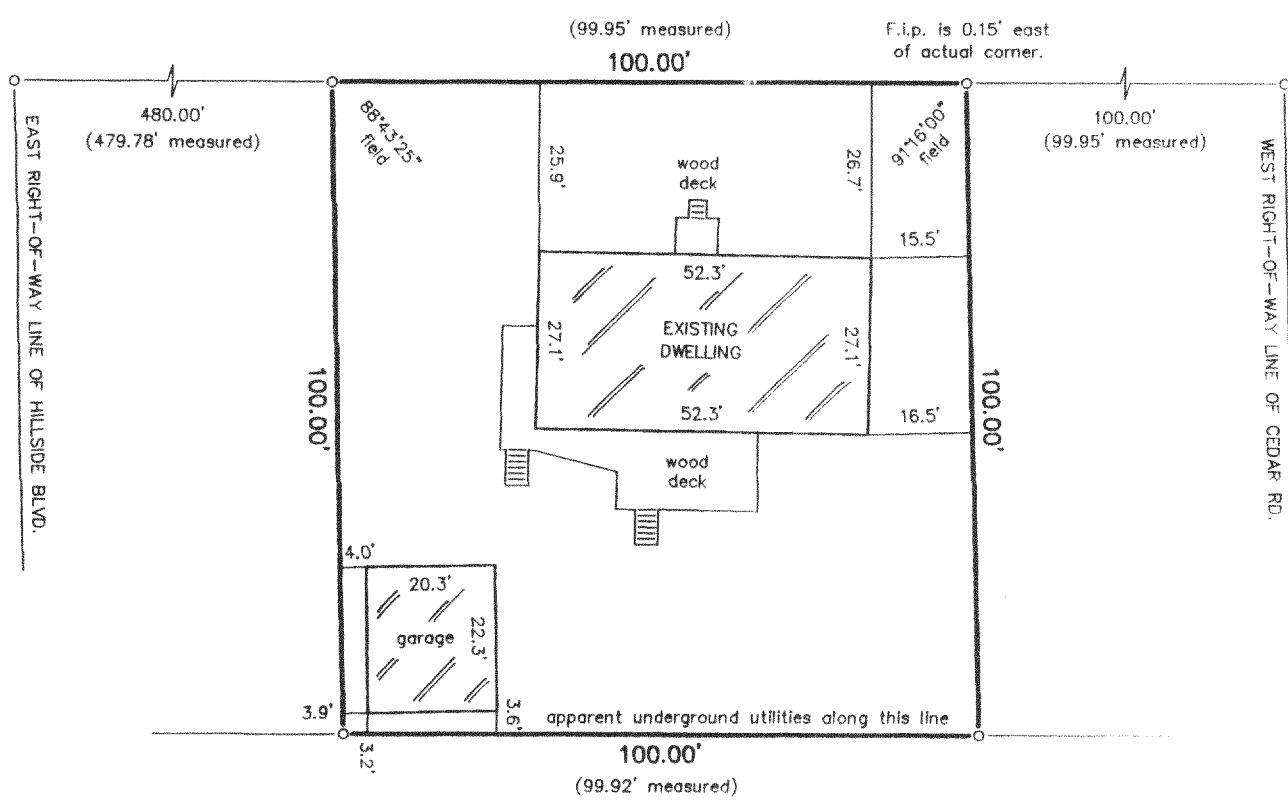


LEGEND

O FOUND IRON PIPE


SCALE:

$$1'' = 30'$$

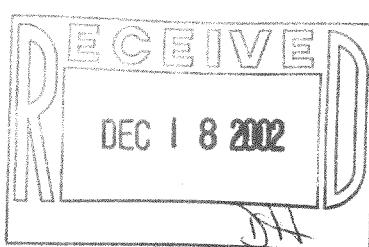

"I hereby certify that I have surveyed the above described property and that the above map is a correct representation thereof and shows the size and location of the property, its exterior boundaries, the location of all visible structures and dimensions of all principal buildings thereon, boundary fences, apparent easements, roadways and encroachments, if any."

"This survey is made for the use of the present owners of the property, and those who purchase, mortgage, or guarantee the title thereto within one year from date hereof."

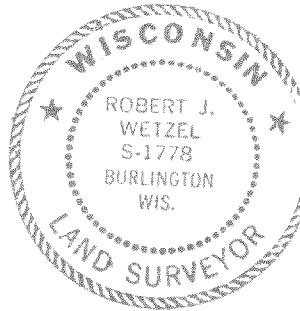

THIS IS NOT AN ORIGINAL PRINT
UNLESS THIS SEAL IS RED.

Robert J.
ROBERT J. WETZEL


S-1778

OCTOBER 30, 2002

DATE

5636

JOB NUMBER

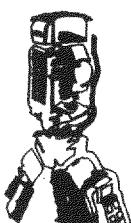

B.W. SURVEYING, INC.

412 N. PINE STREET
BURLINGTON, WI 53105
(262)-767-0225

mpCH = 146

118-2175