


PLAT OF SURVEY

OF

Lots 1042 thru 1046, Block 17 of PELL LAKE ADDITION, being a subdivision located in the West Half of the Southeast Quarter of Section 14 and in the North Half of the North Half of the Northwest Quarter of Section 23, Township 1 North, Range 18 East of the 4th Principal Meridian, Town of Bloomfield, County of Walworth and State of Wisconsin.

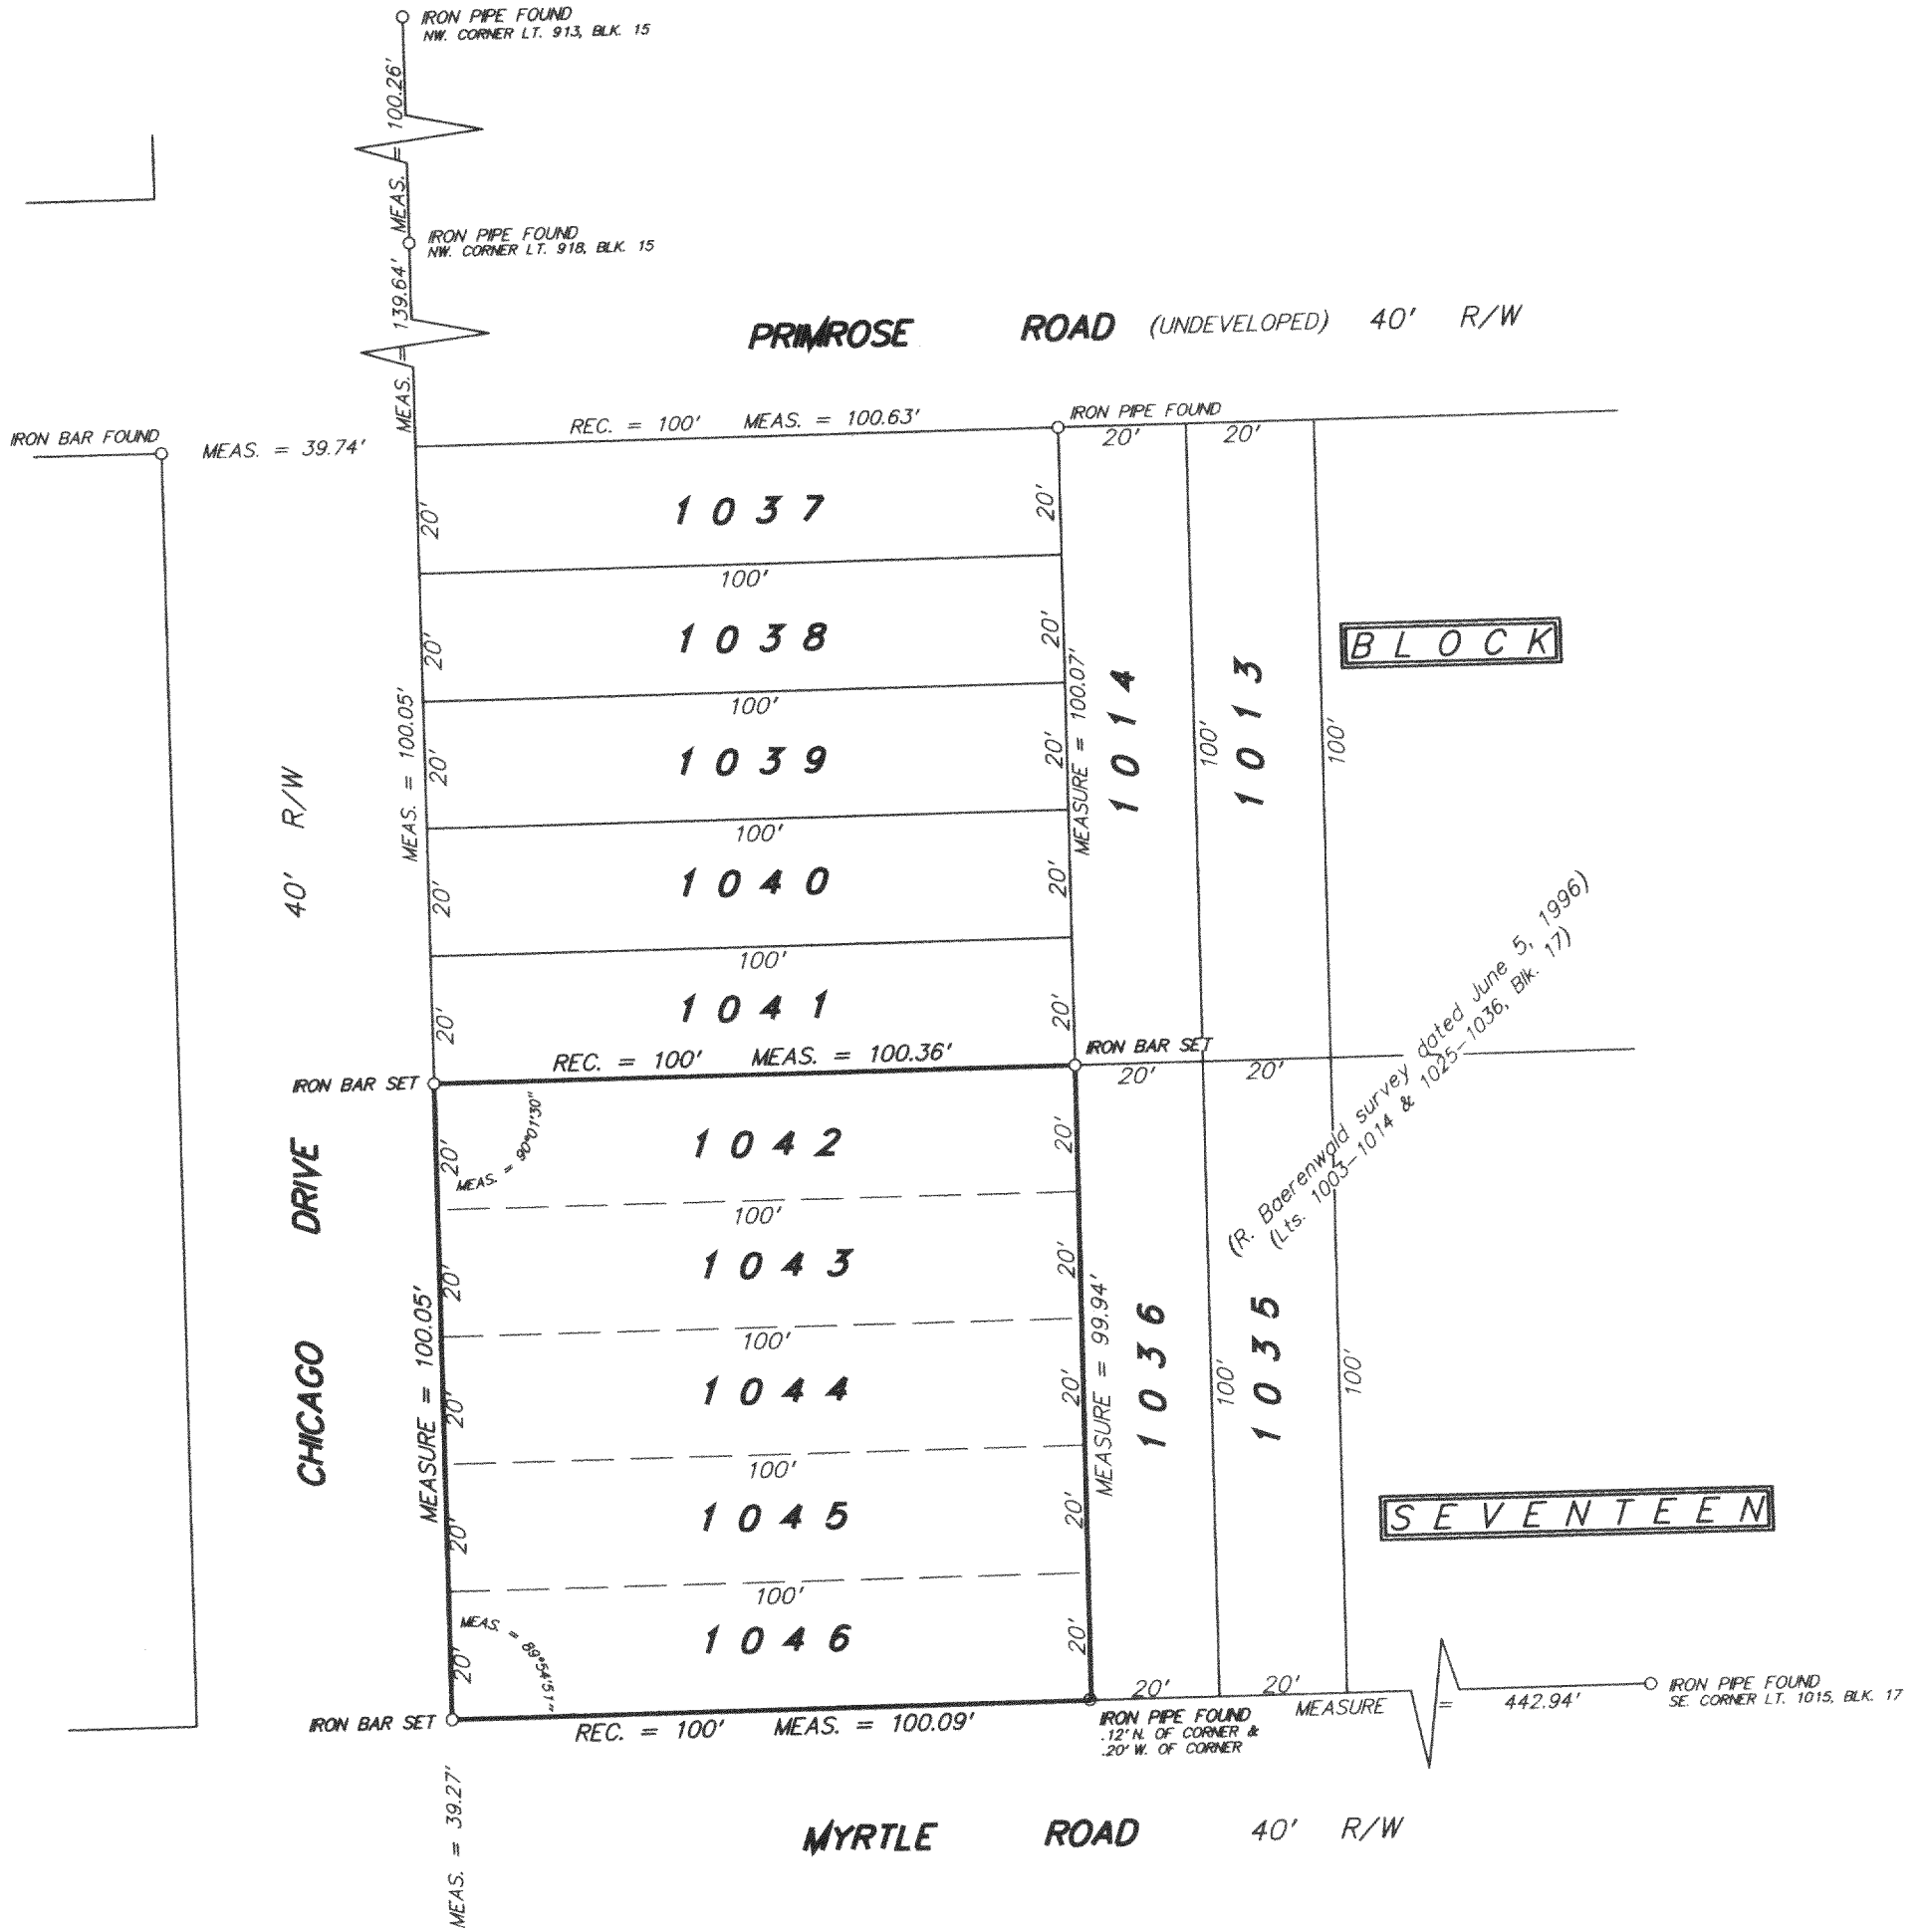


TAX KEY NO.: MPLA 214

SCALE 1 inch = 30 feet
ORDERED BY M. Reese
JOB NO. 0 2 1 6 2

I hereby certify that I have surveyed the above described property and the above plat is a true representation thereof and shows the size and location of the property, its exterior boundaries, the location and dimensions of all visible structures thereon, boundary fences, apparent easements and roadways and visible encroachments, if any.

This survey is made for the exclusive use of the present owners of the property, and also those who purchase, mortgage, or guarantee the title thereto within one year from the date hereof.

Dated at Bassett, Wisconsin this _____ day of _____ 2002.

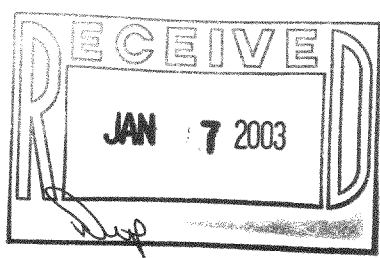

Mark A. Bolender
Wisconsin Registered Land Surveyor S - 1784