


PREPARED FOR:
LARRY HODGES REALTY
CENTURY 21
C/O VAL SCHNEIDER
P.O. BOX 939
TWIN LAKES, WI 53181

PLAT OF SURVEY

- OF -

J.K. SURVEYING INC.
N3705 WILLOWBEND LANE
LAKE GENEVA, WI, 53147
262-248-3697

LOT 12 WM ELLIOTT'S POWERS LAKE SUBDIVISION BEING A SUBDIVISION OF A PART OF THE NORTHEAST
FRACTIONAL 1/4 OF SECTION 13 TOWN 1 NORTH RANGE 18 EAST IN THE TOWN OF BLOOMFIELD WALWORTH
COUNTY WISCONSIN

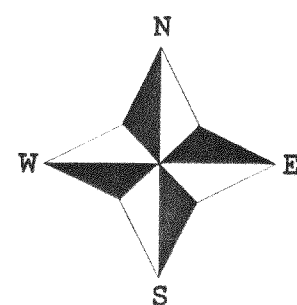

- () = recorded as
□ = found iron bar
○ = found iron pipe
● = set iron pipe
■ = set iron bar
SCALE 1" = 20'



JOB # 02-627

TAX ID # ME00012

COMPARE LEGAL DESCRIPTION ABOVE AND DRAWING WITH DEED FOR BUILDING RESTRICTIONS AND
EASEMENTS NOT SHOWN REFER TO DEED, ABSTRACT SOURCES AND LOCAL MUNICIPAL CODES. NOTIFY
THE SURVEYOR IMMEDIATELY OF ANY DISCREPANCY.

"I hereby certify that I have surveyed the above described property and that
the above map is a true representation thereof and shows the size and
location of all visible structures, apparent easements and encroachments
if any."

This survey is made for the present owners of the property, and those who
purchase, mortgage, or guarantee the title thereto, within one year from
the date hereof.

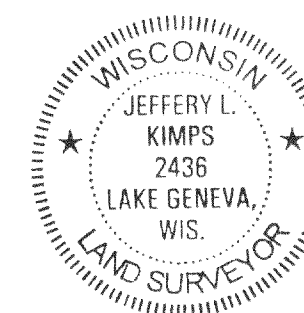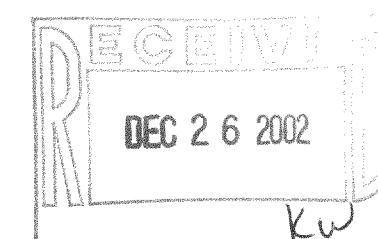

Jeffery L. Kimps
JEFFERY L. KIMPS S-2436
Wisconsin Registered Land Surveyor
(original if signed in red)

DATED THIS THE 10th DAY OF DECEMBER 2002.

ME-12

118-2203