


DUNHAM SURVEYING, S.C.
SURVEYING & SUBDIVIDING
DELAVER, WISCONSIN 53115

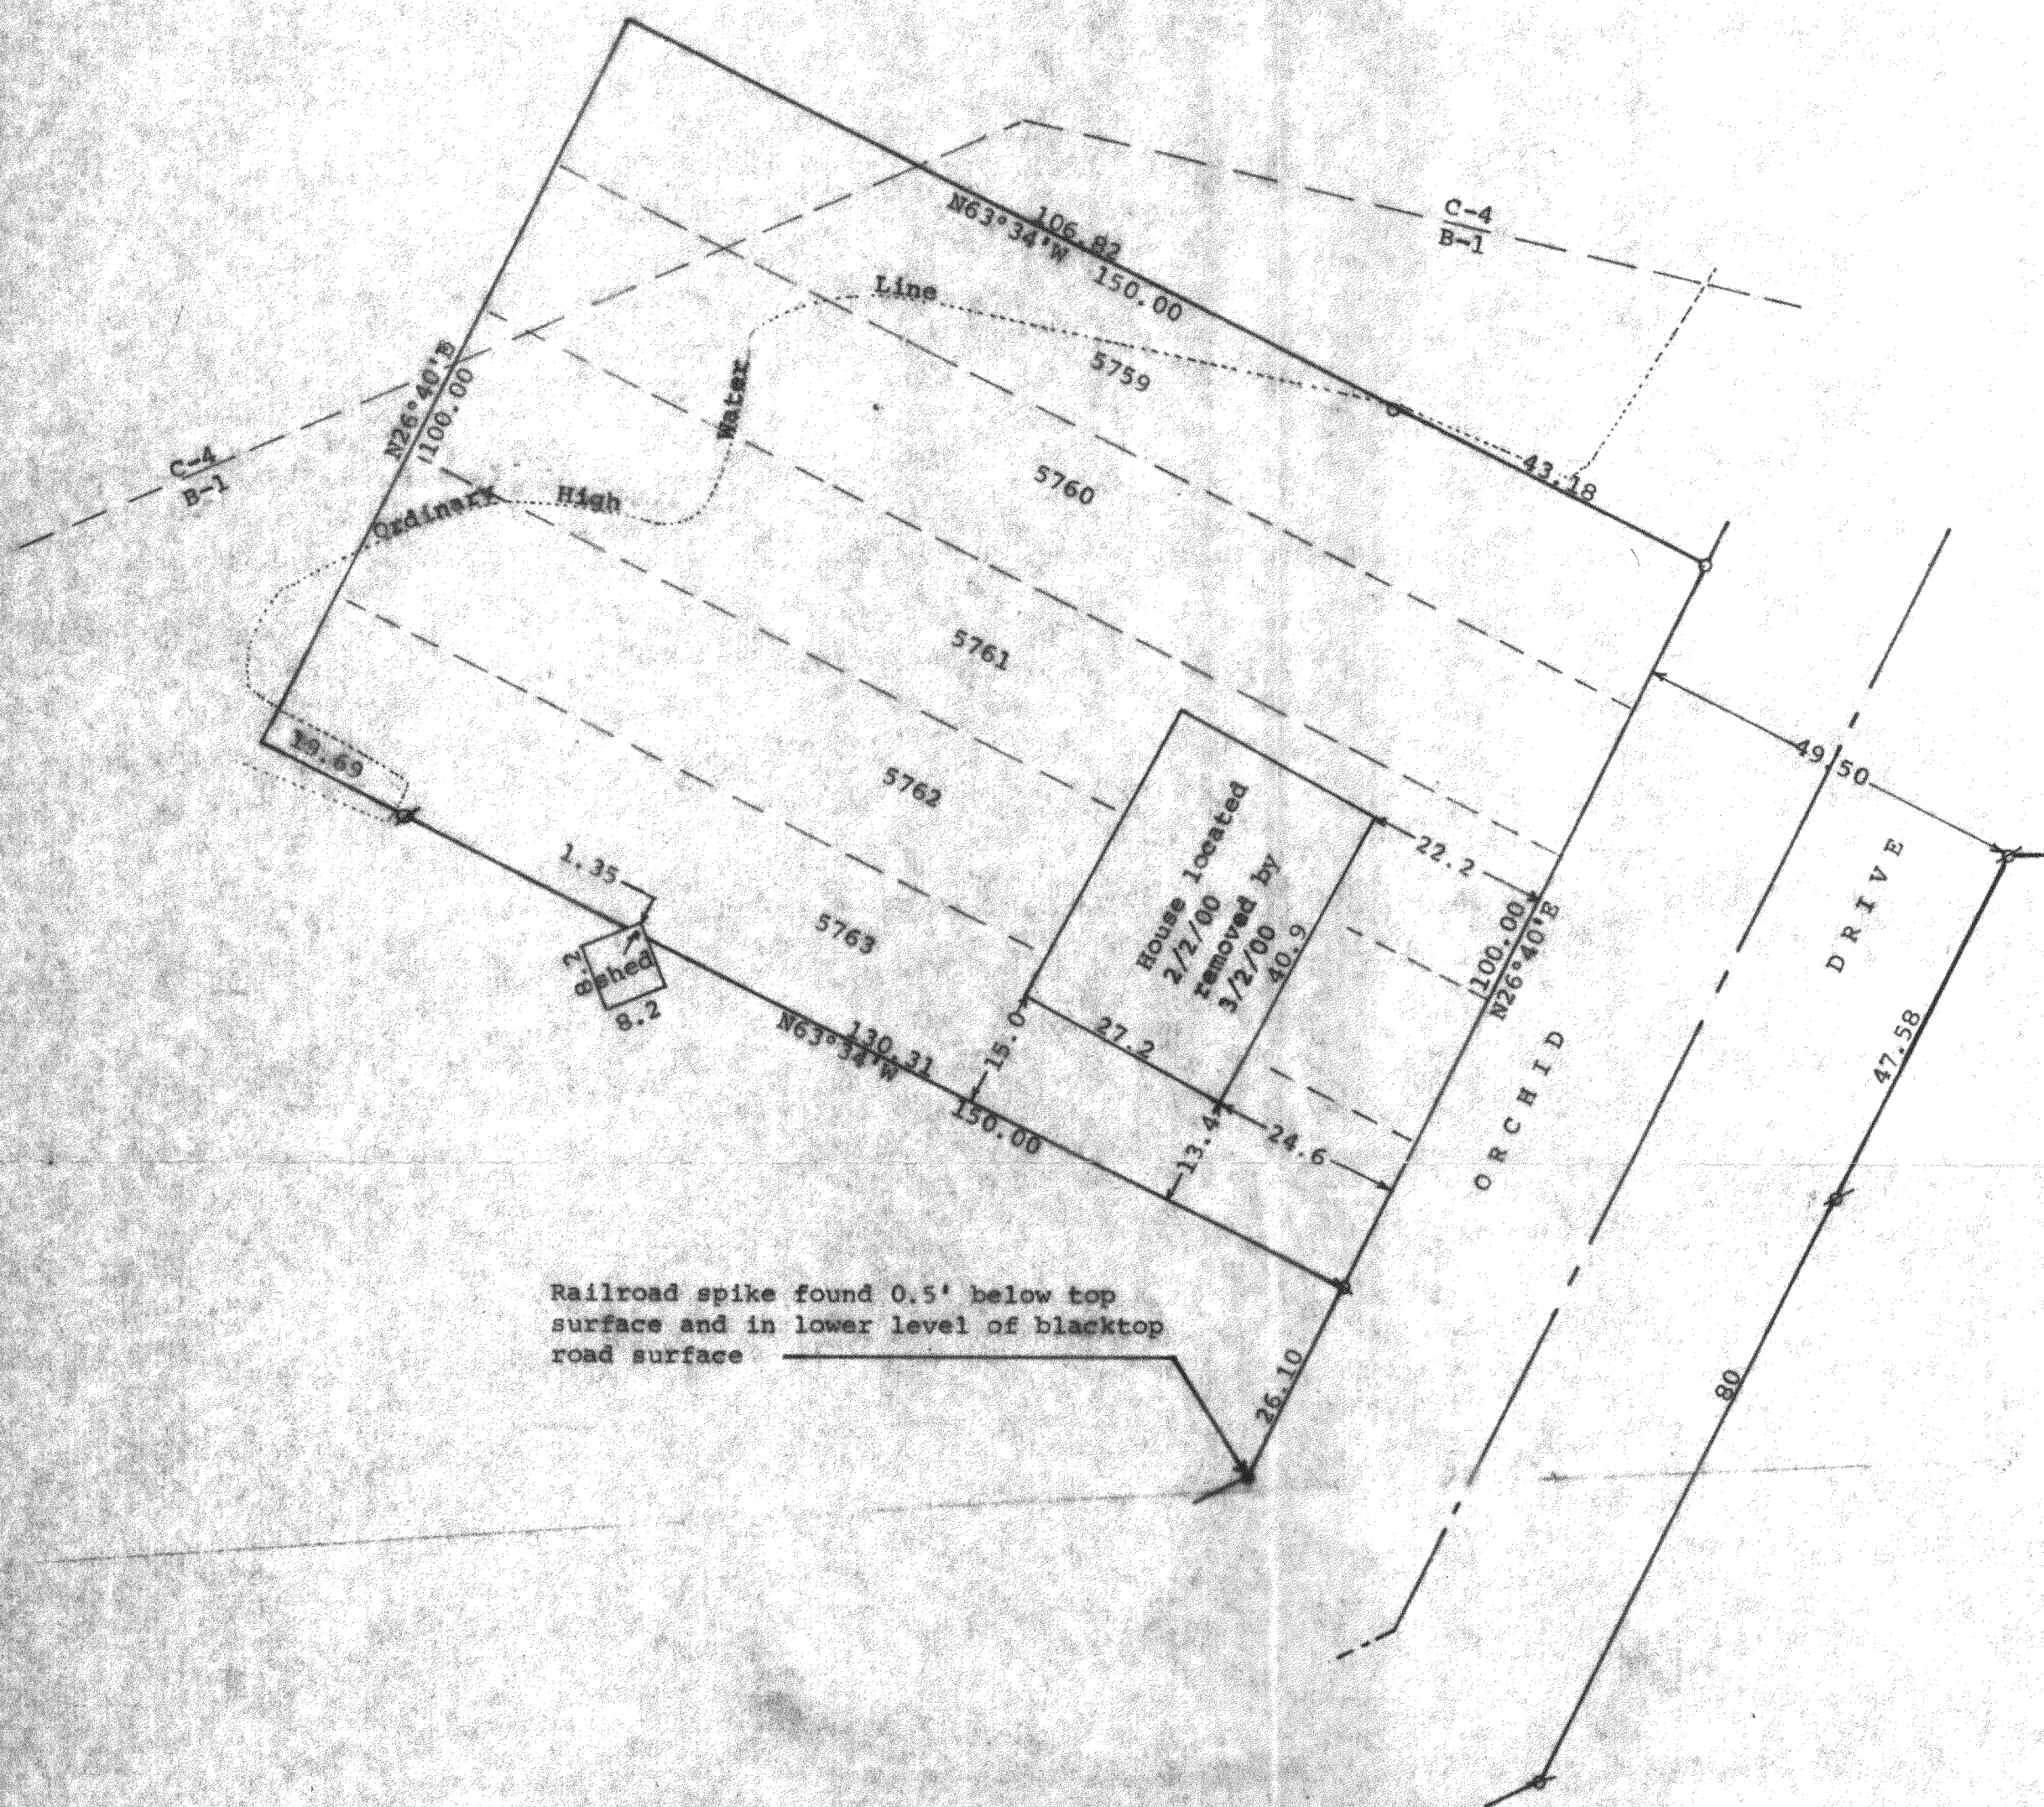

Railroad spike found 0.5' below top surface and in lower level of blacktop road surface

Scale - 1" = 20'
 Ø = Iron Pipe Found
 ● = Railroad spike Found
 α = 1/4" Iron Pipe set in blacktop
 o = 3/4" Iron Pipe Set
 Survey ordered by:
 Larry Morris
 9204 Creek Road
 Box 108
 Clinton, WI 53525
 Bearings referenced to the recorded bearing of N26°40'E along Orchard Dr.

STATE OF WISCONSIN) ss
 COUNTY OF WALWORTH)

I, George T. Dunham, Surveyor, certify that I have surveyed the property described as follows:

Lots 5759-5763 in Block 101 of Section 3 of Pell Lake Subdivision located in Section 15, T 1 N, R 18 E, Walworth County, Wisconsin,

and that the above map is a true representation thereof and shows the size and location of the property, its exterior boundaries, the location of all visible structures and dimensions of all principal buildings thereon, boundary fences, apparent easements, roadways and visible encroachments, if any, and that I have surveyed the property hereon described, according to the official records, to the best of my knowledge and belief.

March 2, 2000

Updated April 5, 2000 to show Zoning designation and Ordinary High Water Line

George T. Dunham
 George T. Dunham, Surveyor

