


026115  
026115S1.DWG

PLAT OF SURVEY

SURVEY ORDERED BY: BARBARA PAGLIARINI  
CENTURY 21 - PAGLIARINI GROUP, LLC.  
252 CENTER STREET  
LAKE GENEVA, WI 53147

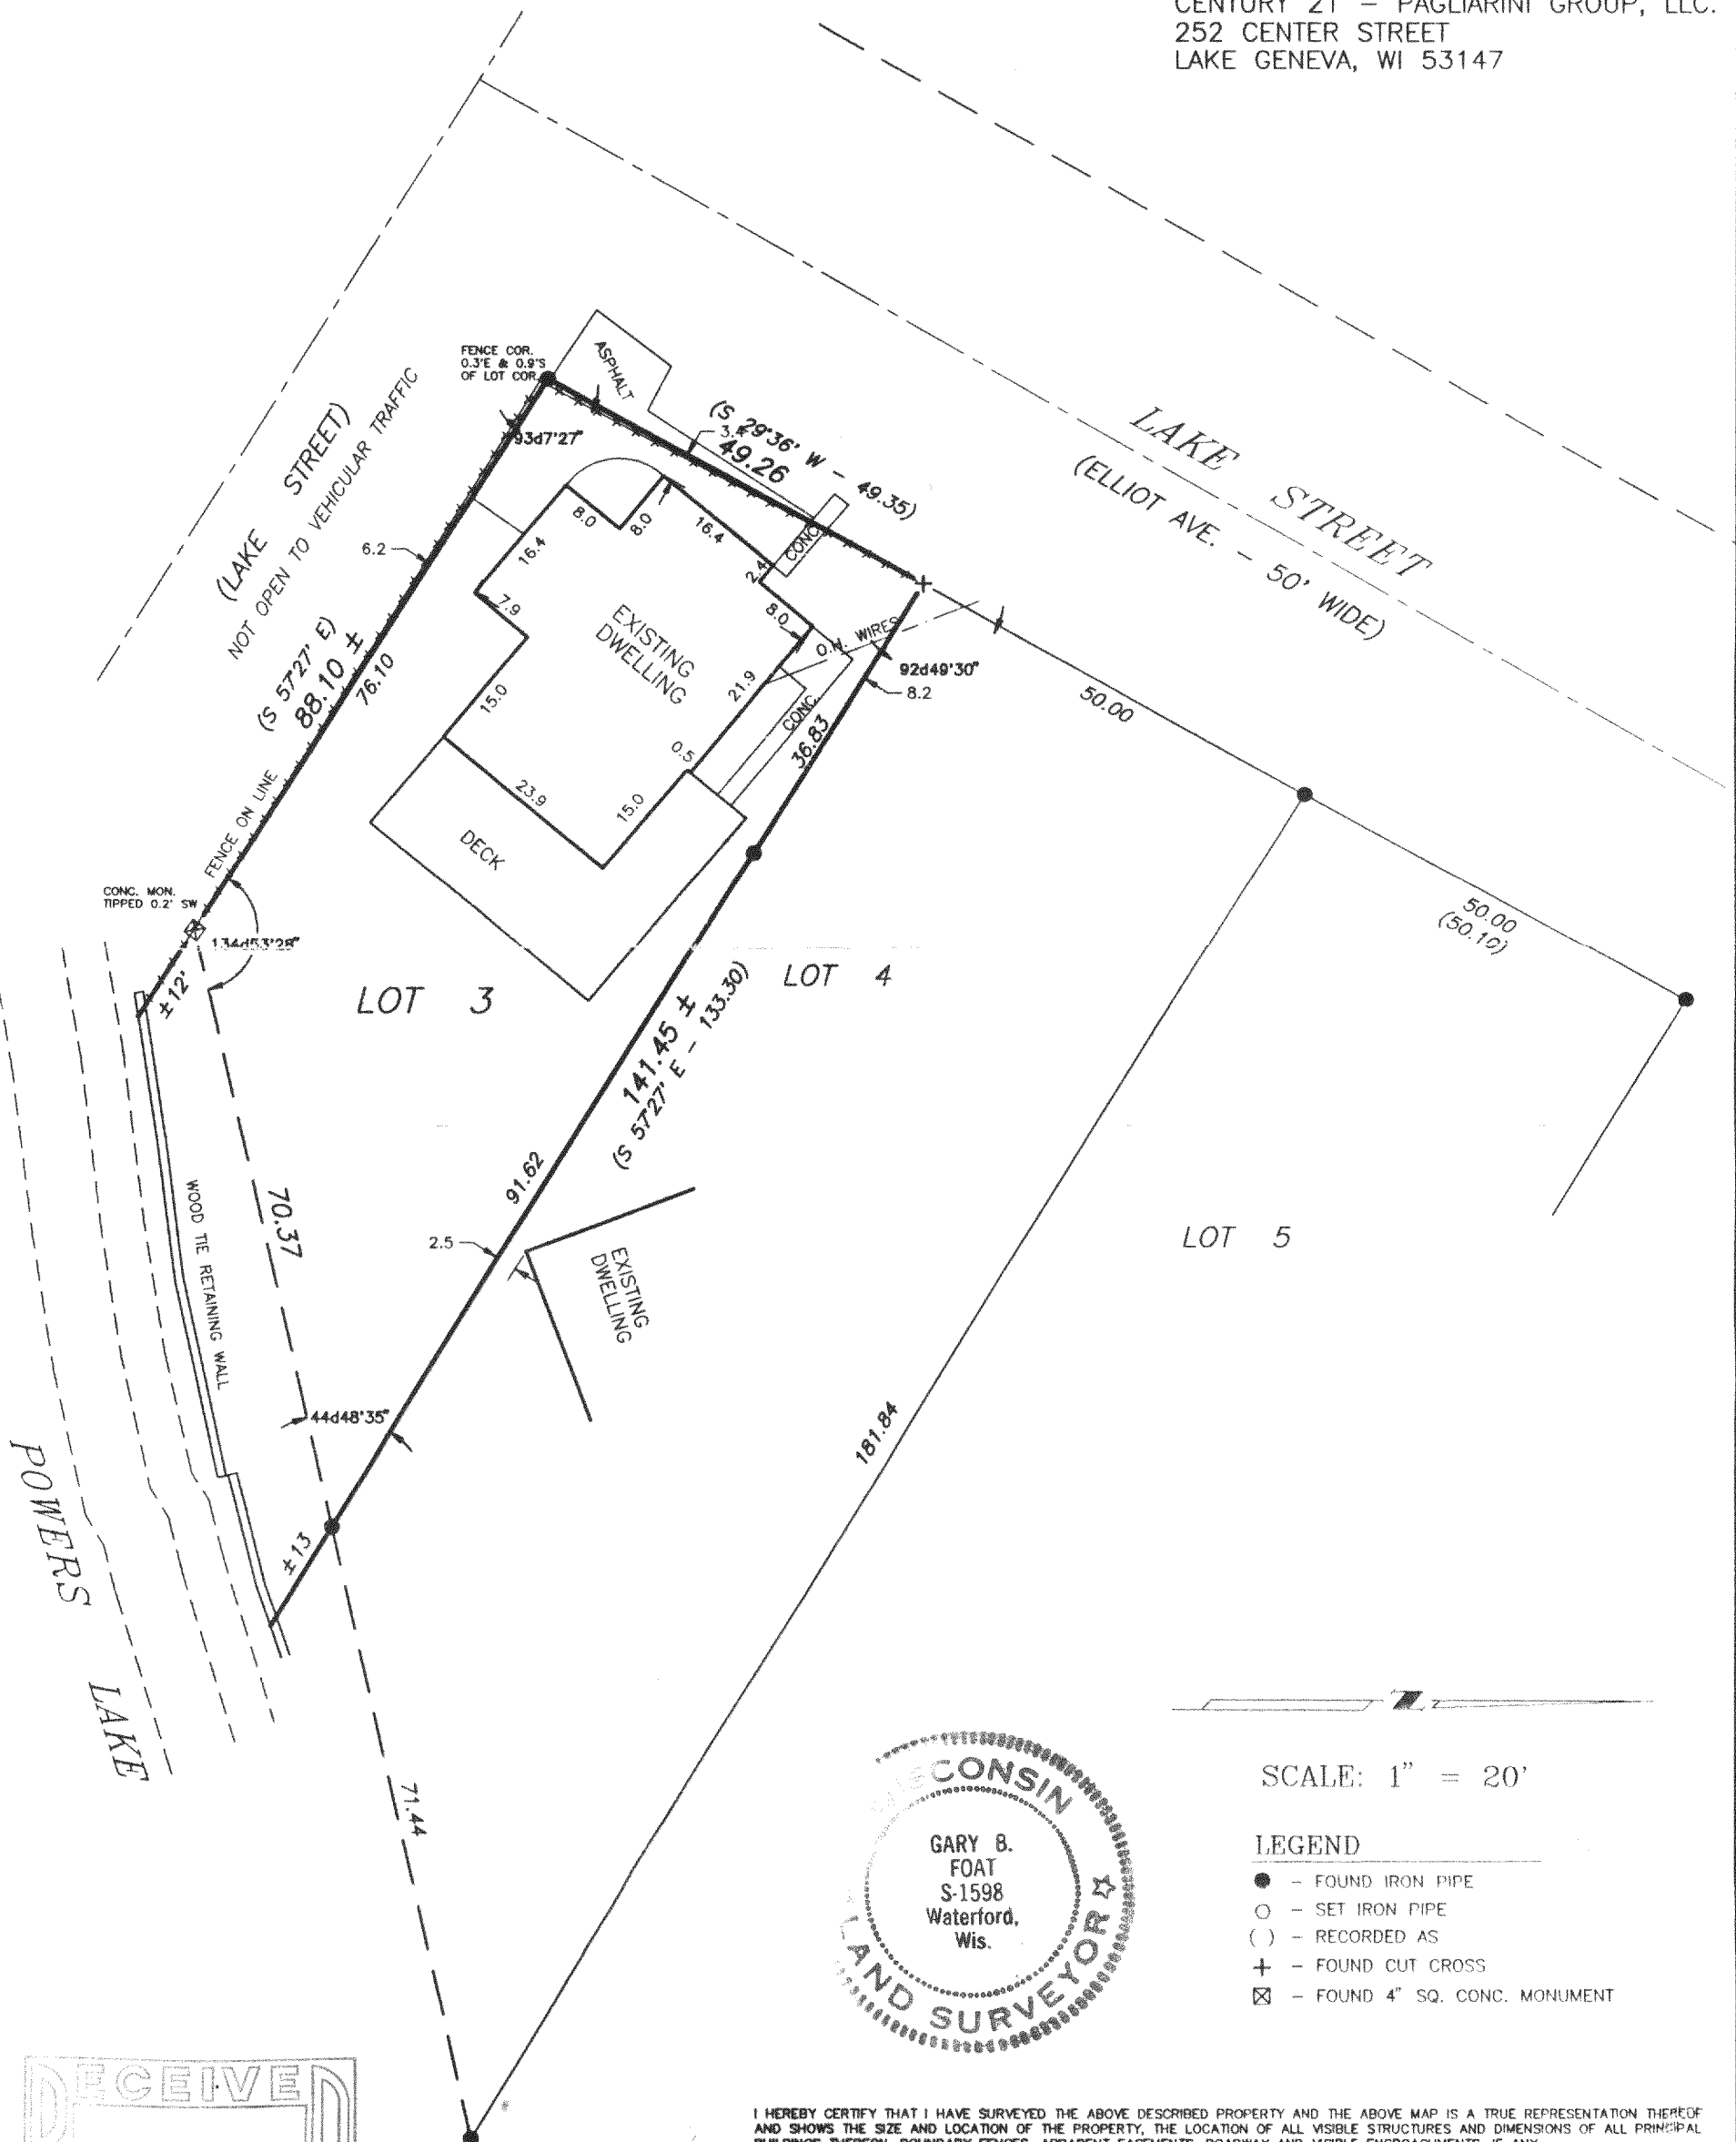

### LEGEND

- - FOUND IRON PIPE
- - SET IRON PIPE
- ( ) - RECORDED AS
- ⊕ - FOUND CUT CROSS
- ⊠ - FOUND 4" SQ. CONC. MONUMENT

I HEREBY CERTIFY THAT I HAVE SURVEYED THE ABOVE DESCRIBED PROPERTY AND THE ABOVE MAP IS A TRUE REPRESENTATION THEREOF AND SHOWS THE SIZE AND LOCATION OF THE PROPERTY, THE LOCATION OF ALL VISIBLE STRUCTURES AND DIMENSIONS OF ALL PRINCIPAL BUILDINGS THEREON, BOUNDARY FENCES, APPARENT EASEMENTS, ROADWAY AND VISIBLE ENCROACHMENTS, IF ANY.

THIS SURVEY IS MADE FOR THE PRESENT OWNERS OF THE PROPERTY, AND ALSO THOSE WHO PURCHASE, OR GUARANTEE THE TITLE THERETO WITHIN (1) YEAR FROM THE DATE HEREOF.

DATE AT WATERFORD, WI THIS 19th DAY OF APRIL 20 02

RECERTIFIED

RECEIVED  
JUN 18 2003

ME-3

118-2268