

DEGEN- FOAT SURVEYING LLC



100 SOUTH SECOND STREET
WATERFORD, WISCONSIN
(262)534-5404 (FAX)534-2022

PLAT OF SURVEY

026385
026385S1.DWG


LOTS 236 THRU 241 AND LOTS 263 THRU 265, BLOCK 6 OF SECTION 1
OF PELL LAKE SUBDIVISION, LOCATED IN TOWN 1 NORTH, RANGE 18 EAST,
TOWN OF BLOOMFIELD, WALWORTH COUNTY, WISCONSIN.

SURVEYED FOR: DEBBIE SARNA
RE/MAX SOUTHERN LAKES
112 ELIZABETH LANE
GENOA CITY, WI 53128

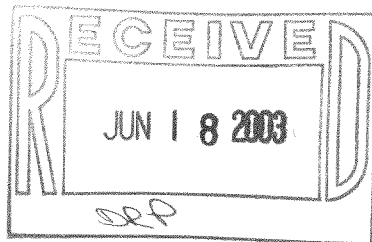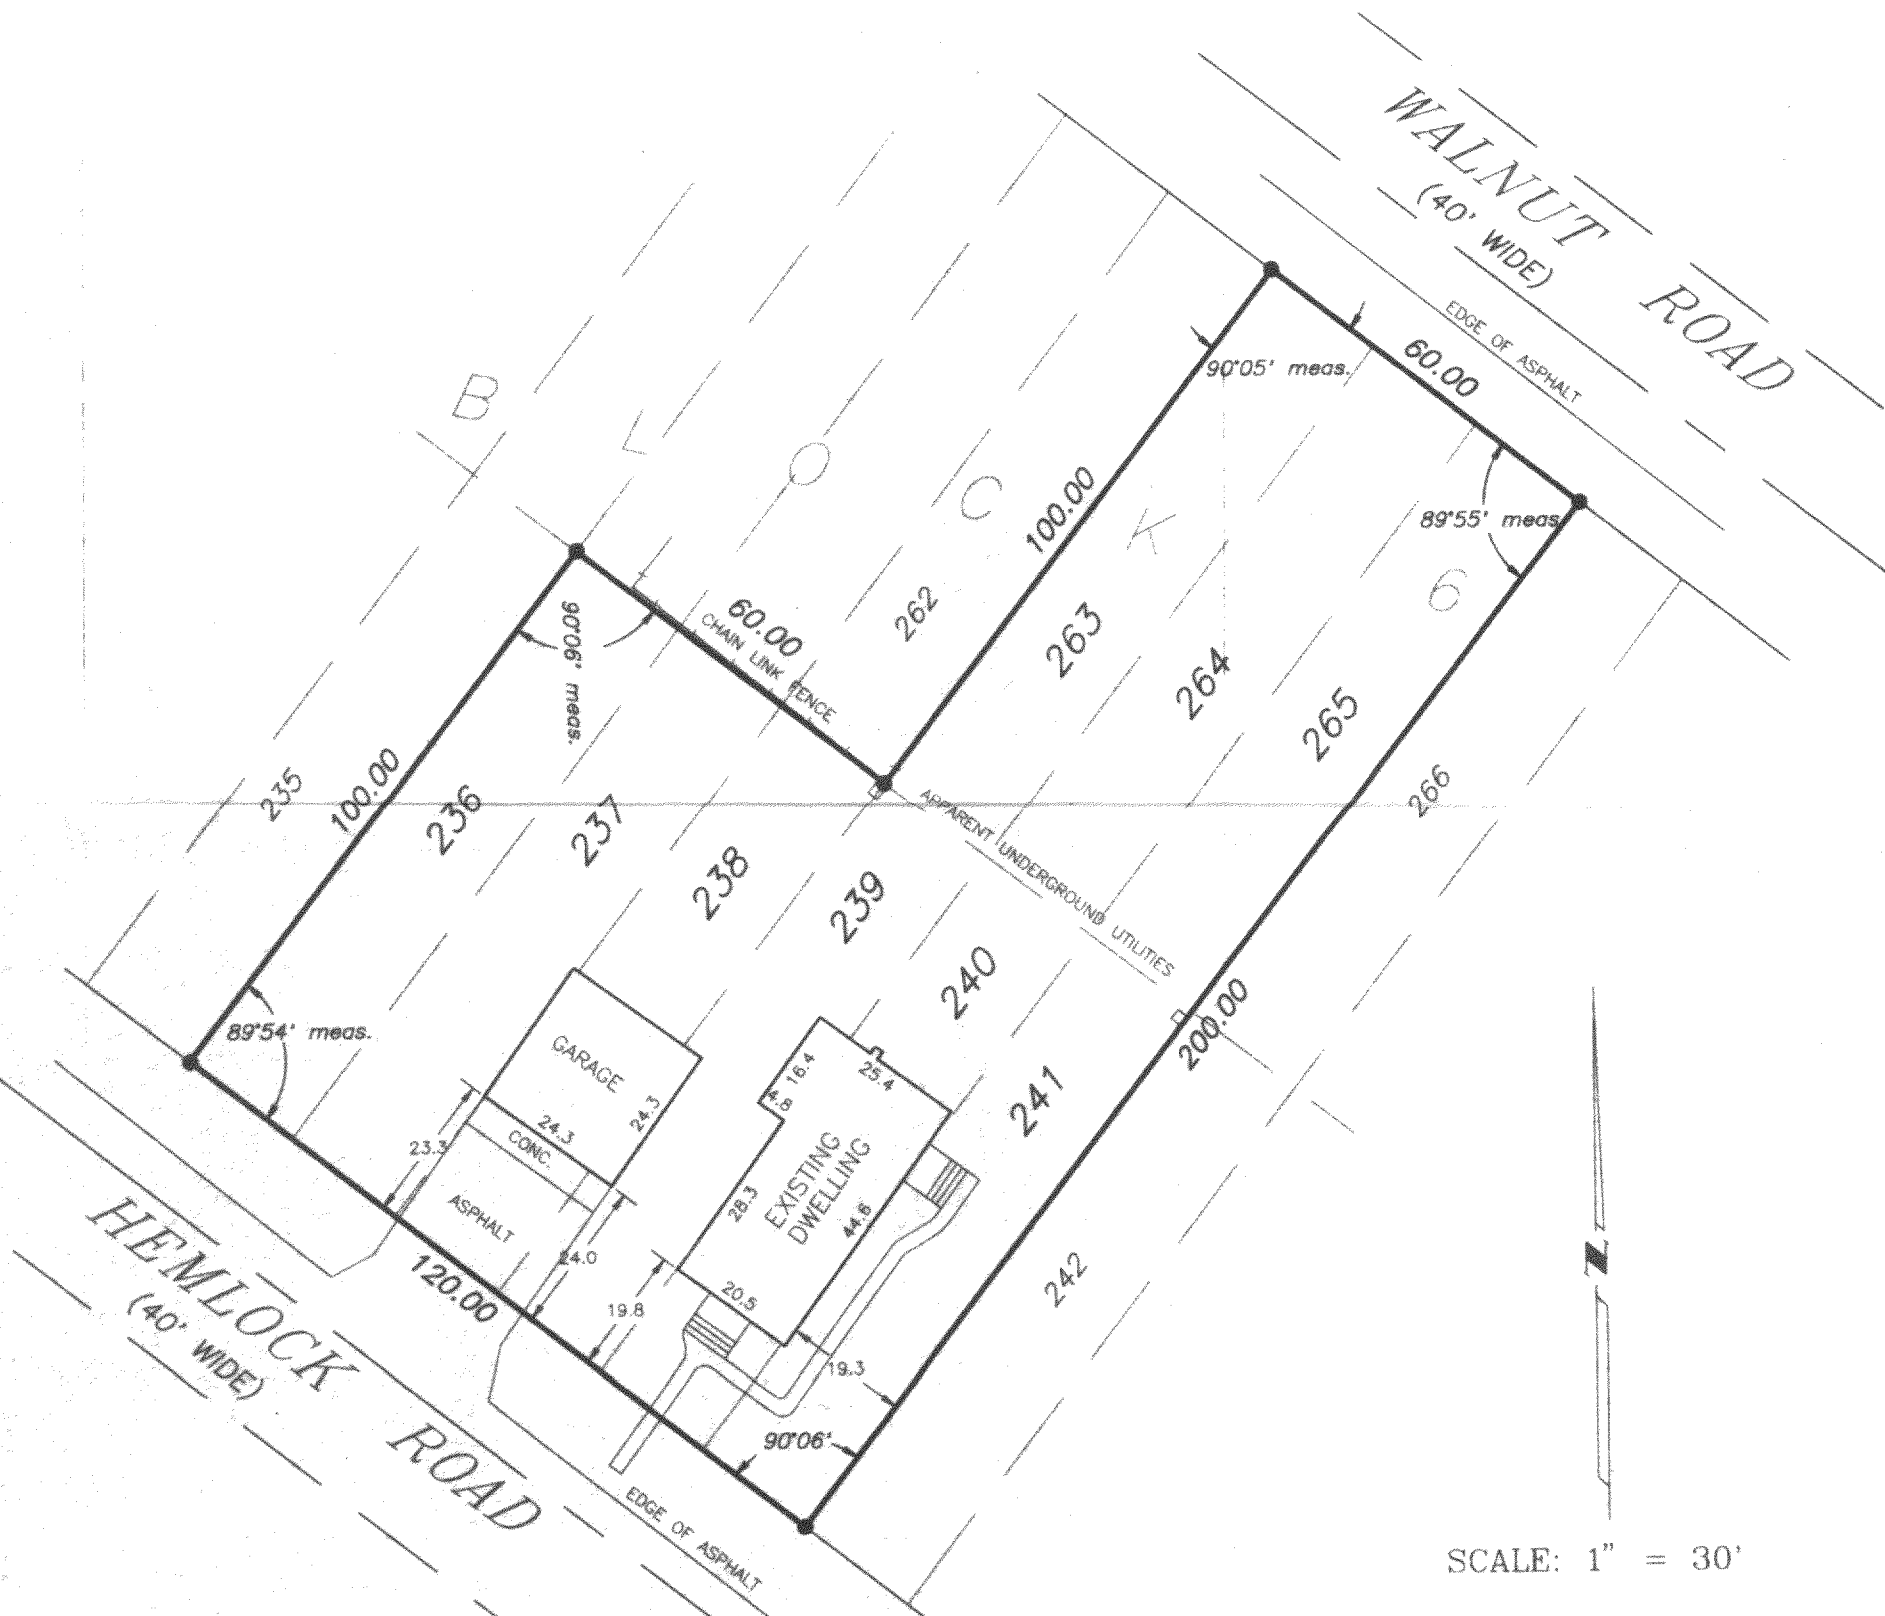

LEGEND

- - FOUND IRON PIPE
- - PEDESTAL
- () - RECORDED AS

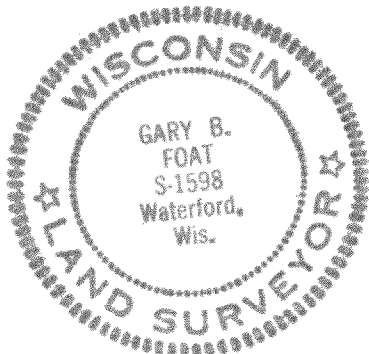

I HEREBY CERTIFY THAT I HAVE SURVEYED THE ABOVE DESCRIBED PROPERTY AND THE ABOVE MAP IS A TRUE REPRESENTATION THEREOF AND SHOWS THE SIZE AND LOCATION OF THE PROPERTY, THE LOCATION OF ALL VISIBLE STRUCTURES AND DIMENSIONS OF ALL PRINCIPAL BUILDINGS THEREON, BOUNDARY FENCES, APPARENT EASEMENTS, ROADWAY AND VISIBLE ENCROACHMENTS, IF ANY.

THIS SURVEY IS MADE FOR THE PRESENT OWNERS OF THE PROPERTY, AND ALSO THOSE WHO PURCHASE, OR GUARANTEE THE TITLE THERETO WITHIN (1) YEAR FROM THE DATE HEREOF.

DATED AT WATERFORD THIS 17TH DAY OF DECEMBER 2002

RECEIVED

Gary B. Foat