


DEGEN, FOAT SURVEYING ASSOCIATES

100 SOUTH SECOND STREET
WATERFORD, WISCONSIN
(262)534-5404 (FAX)534-2022

026126
026126S1.DWG

PLAT OF SURVEY

LOTS 1681 THRU 1686, BLOCK 24, PELL LAKE HIGHLANDS, A SUBDIVISION
LOCATED IN SECTION 16, TOWN 1 NORTH, RANGE 18 EAST OF THE FOURTH
PRINCIPAL MERIDIAN, TOWN OF BLOOMFIELD, WALWORTH COUNTY, WISCONSIN.

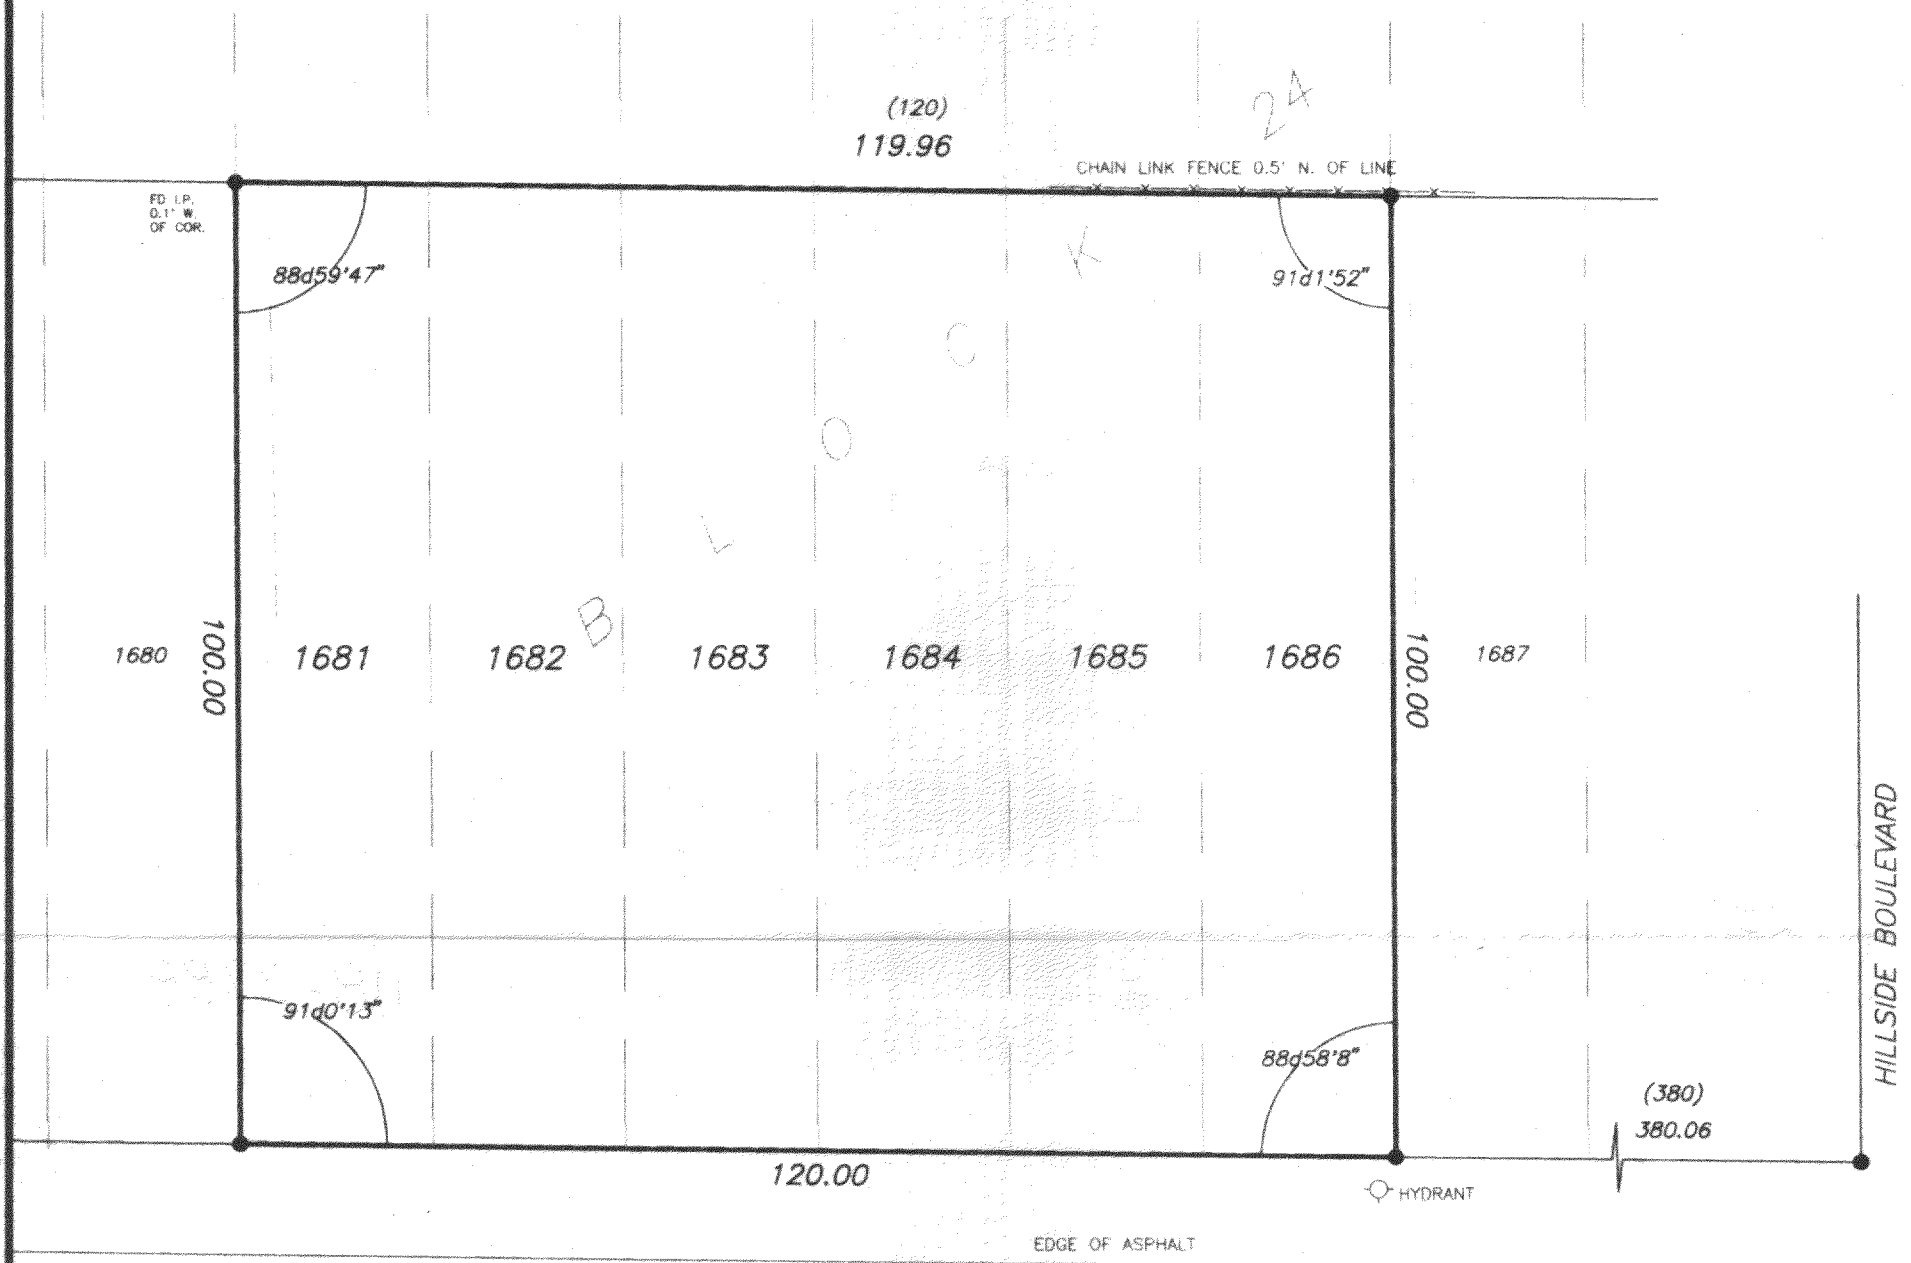

EASTWOOD ROAD
(40' WIDE)


LEGEND

- - FOUND IRON ROD
- - SET IRON PIPE
- - FENCE
- () - RECORDED AS

SURVEYED FOR: MICKEY HORGAN
RE/MAX - SOUTHERN LAKES
112 ELIZABETH LANE
GENOA CITY, WI 53128



SCALE: 1" = 20'

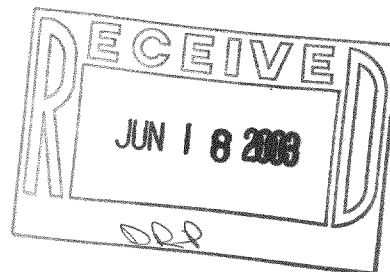

I HEREBY CERTIFY THAT I HAVE SURVEYED THE ABOVE DESCRIBED PROPERTY AND THE ABOVE MAP IS A TRUE REPRESENTATION THEREOF AND SHOWS THE SIZE AND LOCATION OF THE PROPERTY, THE LOCATION OF ALL VISIBLE STRUCTURES AND DIMENSIONS OF ALL PRINCIPAL BUILDINGS THEREON, BOUNDARY FENCES, APPARENT EASEMENTS, ROADWAY AND VISIBLE ENCROACHMENTS, IF ANY.

THIS SURVEY IS MADE FOR THE PRESENT OWNERS OF THE PROPERTY, AND ALSO THOSE WHO PURCHASE, OR GUARANTEE THE TITLE THERETO WITHIN (1) YEAR FROM THE DATE HEREOF.

DATED AT WATERFORD THIS 8TH DAY OF MAY 20 02

RECEIVED

Gary B. Foat

MPLH-294

118-2288