

PLAT OF SURVEY
-OF-

LOT 9, BLOCK 5 ROSE NIPPERSINK GARDENS
SUBDIVISION, ACCORDING TO THE RECORDED PLAT
THEREOF. SAID LAND BEING IN THE TOWN OF
BLOOMFIELD, COUNTY OF WALWORTH, AND STATE
OF WISCONSIN.

SURVEY FOR: STUMPF REALTY
SURVEY LOCATION: TULIP DRIVE

LEGEND

- FOUND IRON PIPE
- FOUND IRON ROD
- () MEASURED AS

NOTE: LOT AS PLATTED DOES NOT CLOSE
0.10' N/S, & 0.45' E/W.



"I hereby certify that I have surveyed the above described
property and that the above map is a correct representation thereof
and shows the size and location of the property, its exterior
boundaries, the location of all visible structures and dimensions
of all principal buildings thereon, boundary fences, apparent
easements, roadways and encroachments, if any."

"This survey is made for the use of the present owners of the
property, and those who purchase, mortgage, or guarantee the
title thereto within one year from date hereof."




B.W. SURVEYING, INC.

412 N. PINE STREET
BURLINGTON, WI 53105
(262)-767-0225

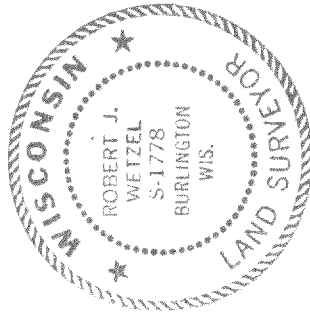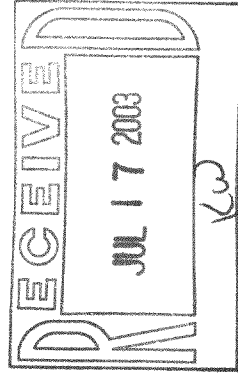

THIS IS NOT AN ORIGINAL PRINT
UNLESS THIS SEAL IS RED.

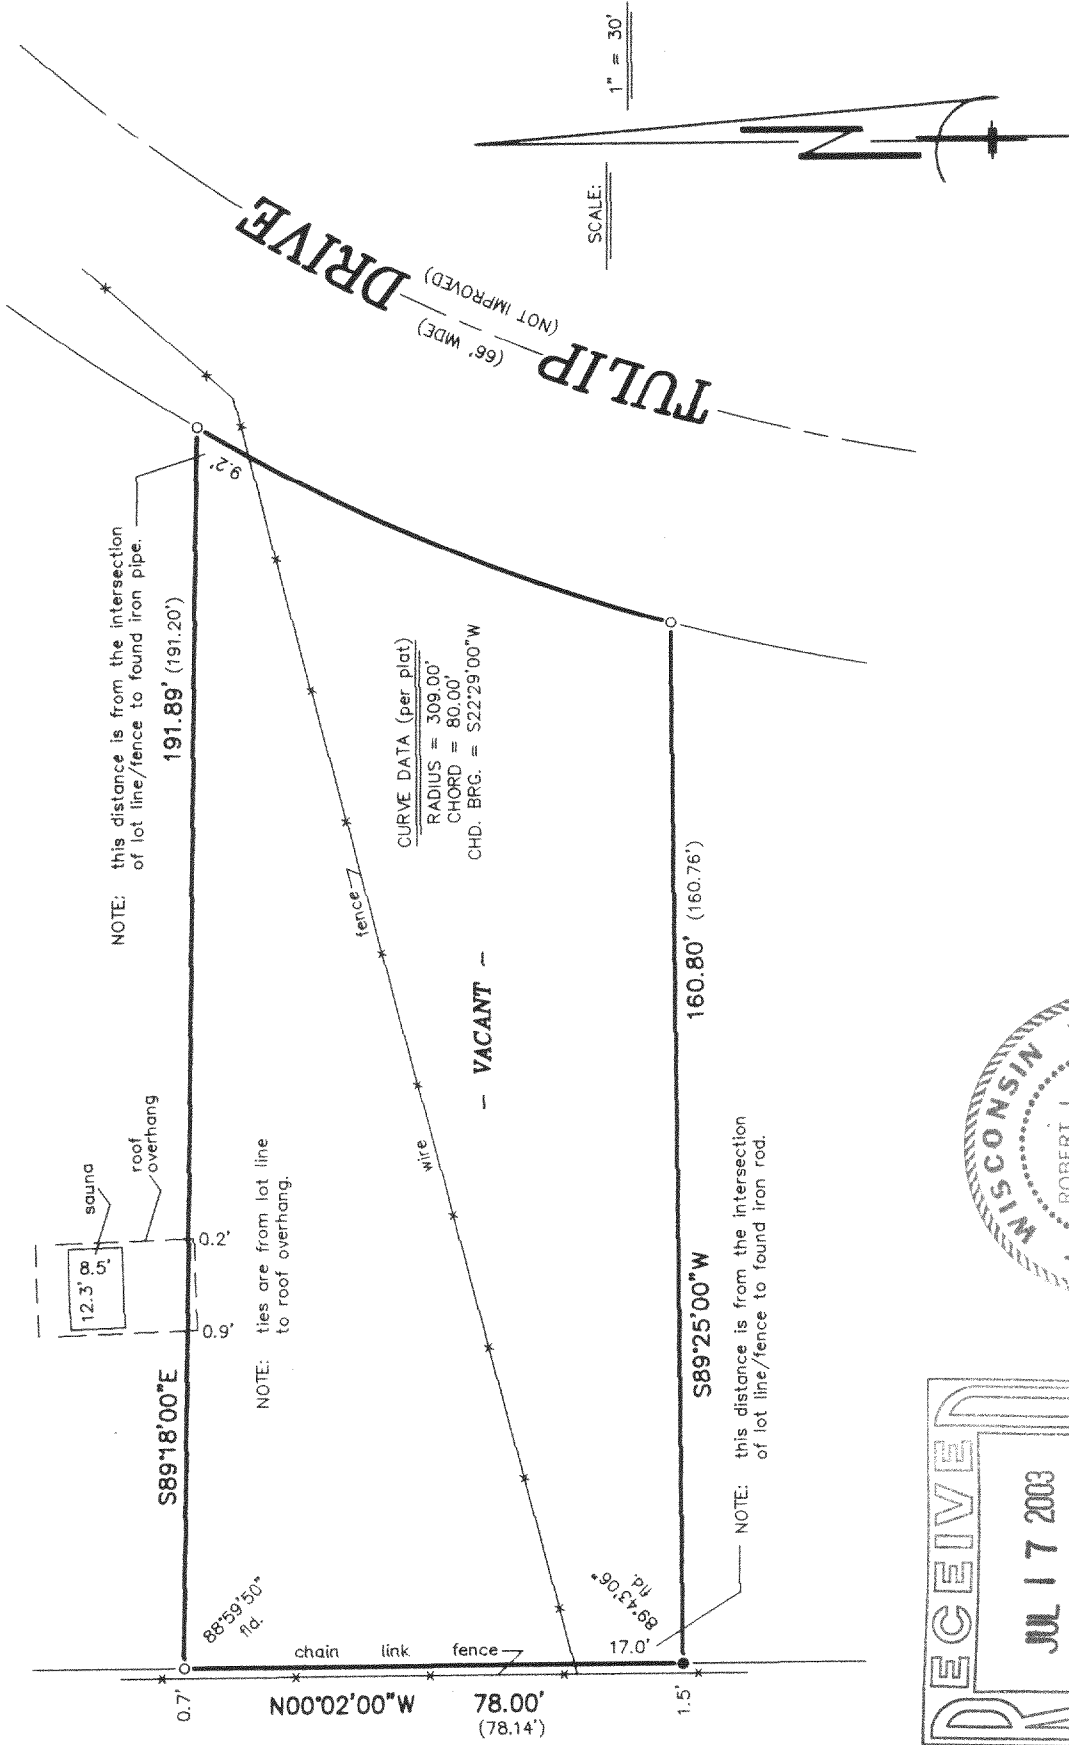

Robert J. Wetzel
ROBERT J. WETZEL
S-1778

6/30/03
DATE
5930
JOB NUMBER

MRNG-44

118-2290