


PLAT OF SURVEY


-OF-

LOTS 839, 840, 841, 842, 843, 844, 845 AND 846, BLOCK 12, PELL LAKE HIGHLANDS, ACCORDING TO THE RECORDED PLAT THEREOF. SAID LAND BEING IN THE TOWN OF BLOOMFIELD, COUNTY OF WALWORTH AND STATE OF WISCONSIN.

SURVEY FOR: RE/MAX SOUTHERN LAKES REALTY
SURVEY LOCATION: W1386 HOLLYWOOD ROAD

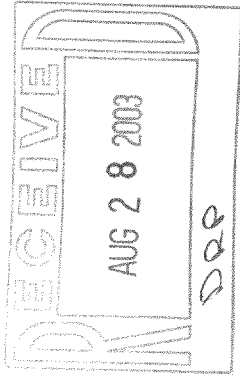

EAST LINE OF HILLSIDE BLVD.

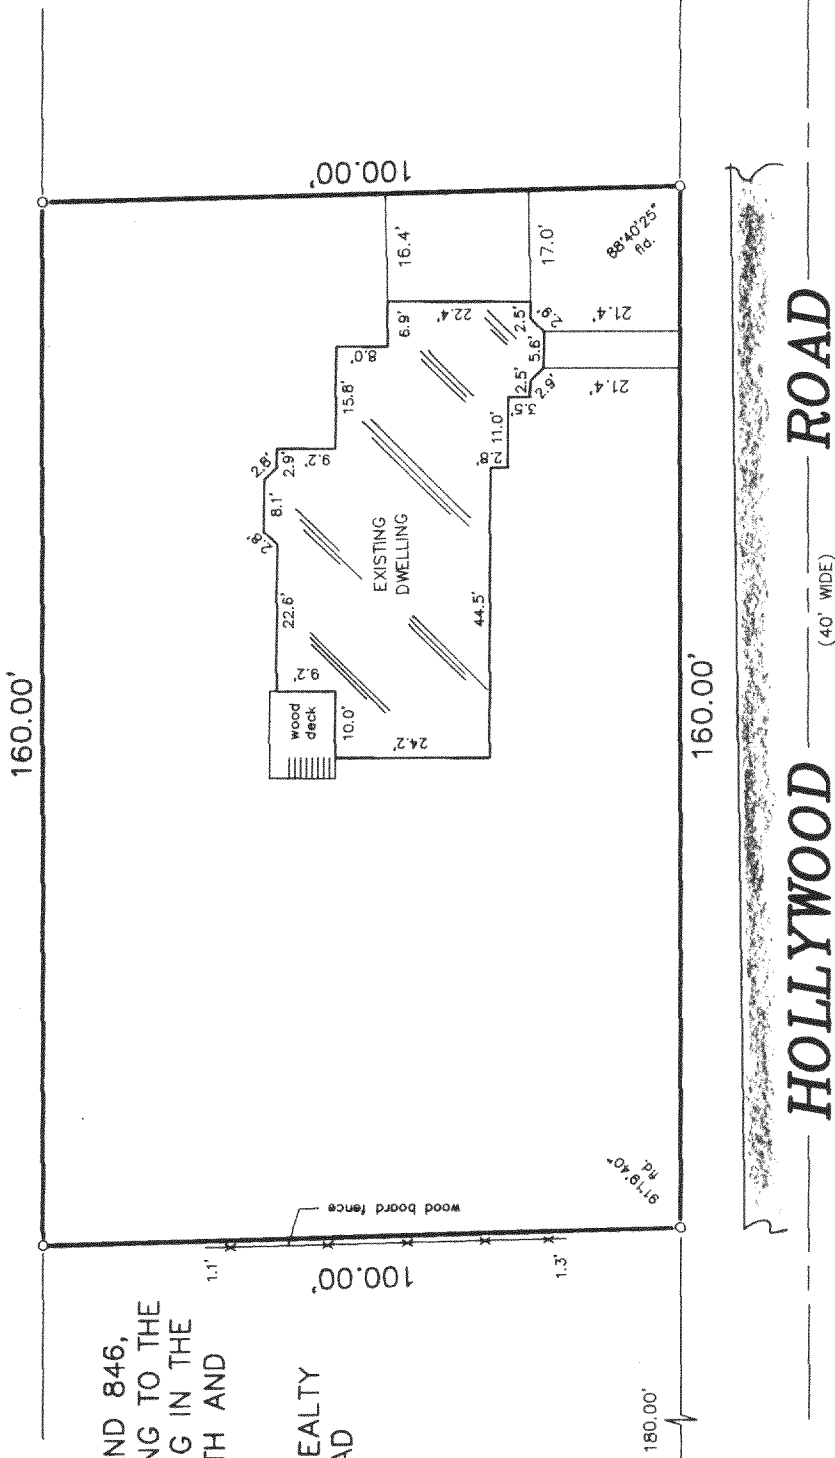

HOLLYWOOD ROAD
(40' WIDE)

"I hereby certify that I have surveyed the above described property and that the above map is a correct representation thereof and shows the size and location of the property, its exterior boundaries, the location of all visible structures and dimensions of all principal buildings thereon, boundary fences, apparent easements, roadways and encroachments, if any."

"This survey is made for the use of the present owners of the property, and those who purchase, mortgage, or guarantee the title thereto within one year from date hereof."




B.W. SURVEYING, INC.

412 N. PINE STREET
BURLINGTON, WI 53105
(262)-767-0225

LEGEND

- FOUND IRON PIPE
- SET IRON PIPE

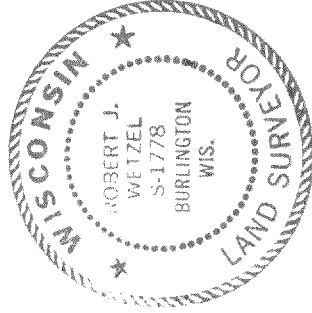

THIS IS NOT AN ORIGINAL PRINT
UNLESS THIS SEAL IS RED.

Robert J. Wetzel
ROBERT J. WETZEL S-1778

JULY 12, 2003
DATE

5976
JOB NUMBER

MPLH-179

118-2310