


# PLAT OF SURVEY

OF

LOTS 1184, 1185, 1186, 1187 AND 1188, ALL IN BLOCK 20 OF PELL LAKE ADDITION,  
TOWN OF BLOOMFIELD, WALWORTH COUNTY, WISCONSIN.



J.K. SURVEYING INC.  
N3705 WILLOWBEND LANE  
LAKE GENEVA, WI, 53147  
262-248-3697

ORDERED BY : RHYNER CONSTRUCTION  
P.O. BOX 432  
POWERS LAKE, WI  
53159

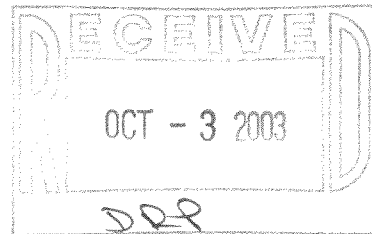

FENCE IS  
.5' SOUTH AND  
.15' EAST OF  
CORNER

## MYRTLE ROAD

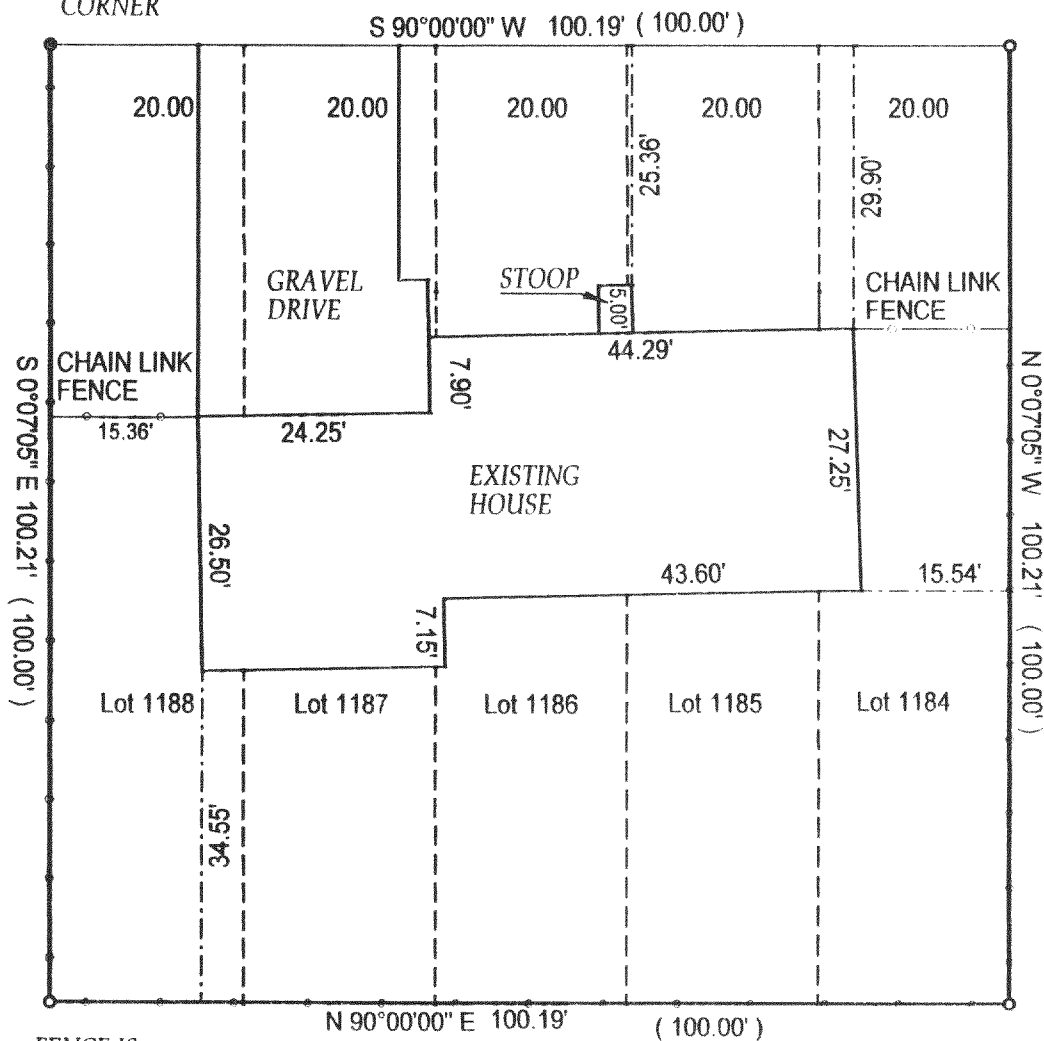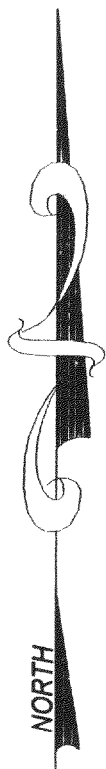

FENCE IS  
.4' NORTH AND  
.25' EAST OF  
CORNER

FENCE IS  
.07' NORTH AND  
.05' WEST OF  
CORNER

( ) = recorded as

○ = 1" iron pipe  
found

● = 1' iron pipe  
set


JOB# 00-126

SCALE: 1"=20'

TAX KEY #

DATE OF LAST REVISION 04 / 03 / 03  
REVISED AS OF 11-1-2000 J.L.K

"I hereby certify that I have surveyed the above described property and that  
the above map is a true representation thereof and shows the size and  
location of all visible structures, apparent easements and encroachments  
if any."  
This survey is made for the present owners of the property, and those who  
purchase, mortgage, or guarantee the title thereto, within one year from  
the date hereof.

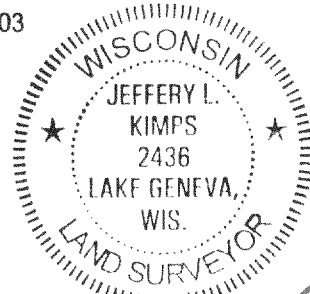

JEFFREY L. KIMPS S-2436-008

DATED THIS 25 TH DAY OF FEB 20 00

MPLA-241

118-2321