


HAROLD H. KOLB

REGISTERED PROFESSIONAL LAND SURVEYOR
LAKE GENEVA, WISCONSIN

PEACH ROAD

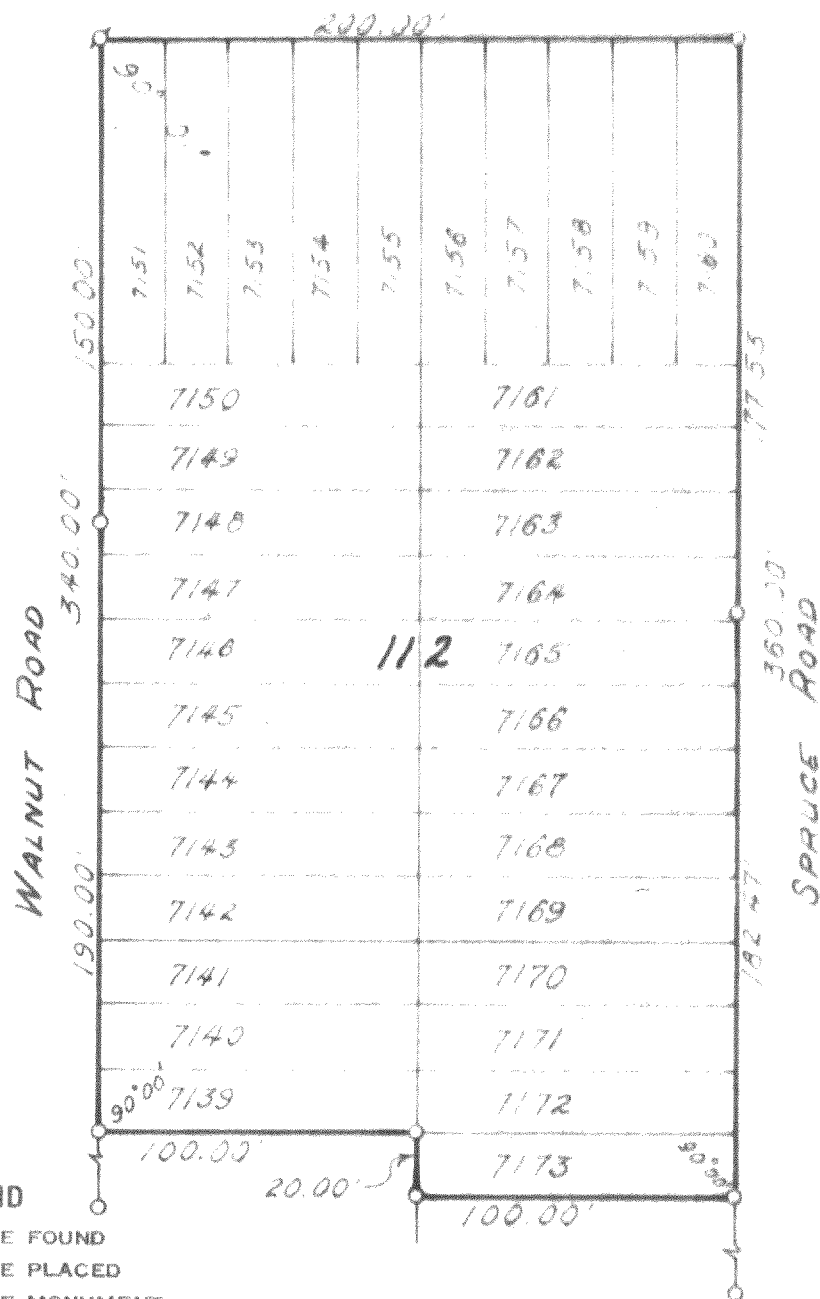

I, HAROLD H. KOLB, DO HEREBY CERTIFY THAT I HAVE
SURVEYED THE PROPERTY HEREON DESCRIBED ACCORDING
TO THE OFFICIAL RECORDS, AND THAT THE PLAT HEREON
IS A CORRECT REPRESENTATION OF THE LOT LINES.

Harold H. Kolb
HAROLD H. KOLB

WISCONSIN REGISTERED LAND SURVEYOR, S-187
DATE June 20, 1968

PLAT OF SURVEY OF
Lots 7139 - 7173, Block 112,
Pell Lake, a subdivision loc-
ated in T 1 N, R 18 E, Walworth
County, Wisconsin.

MPL-1519
1519 A
1521
1522

118-234