

PREPARED FOR:
ALBERT KACZMAREK
P.O. BOX 639
PELL LAKE, WI. 53157

PLAT OF SURVEY


J.K. SURVEYING INC.
N3705 WILLOWBEND LANE
LAKE GENEVA, WI, 53147
262-248-3697

- OF -

LOTS 1209 THROUGH 1215, BLOCK 20 OF PELL LAKE ADDITION, LOCATED IN T1N, R18E,
WALWORTH COUNTY, WISCONSIN.



NOTE: BEARINGS ARE ASSUMED

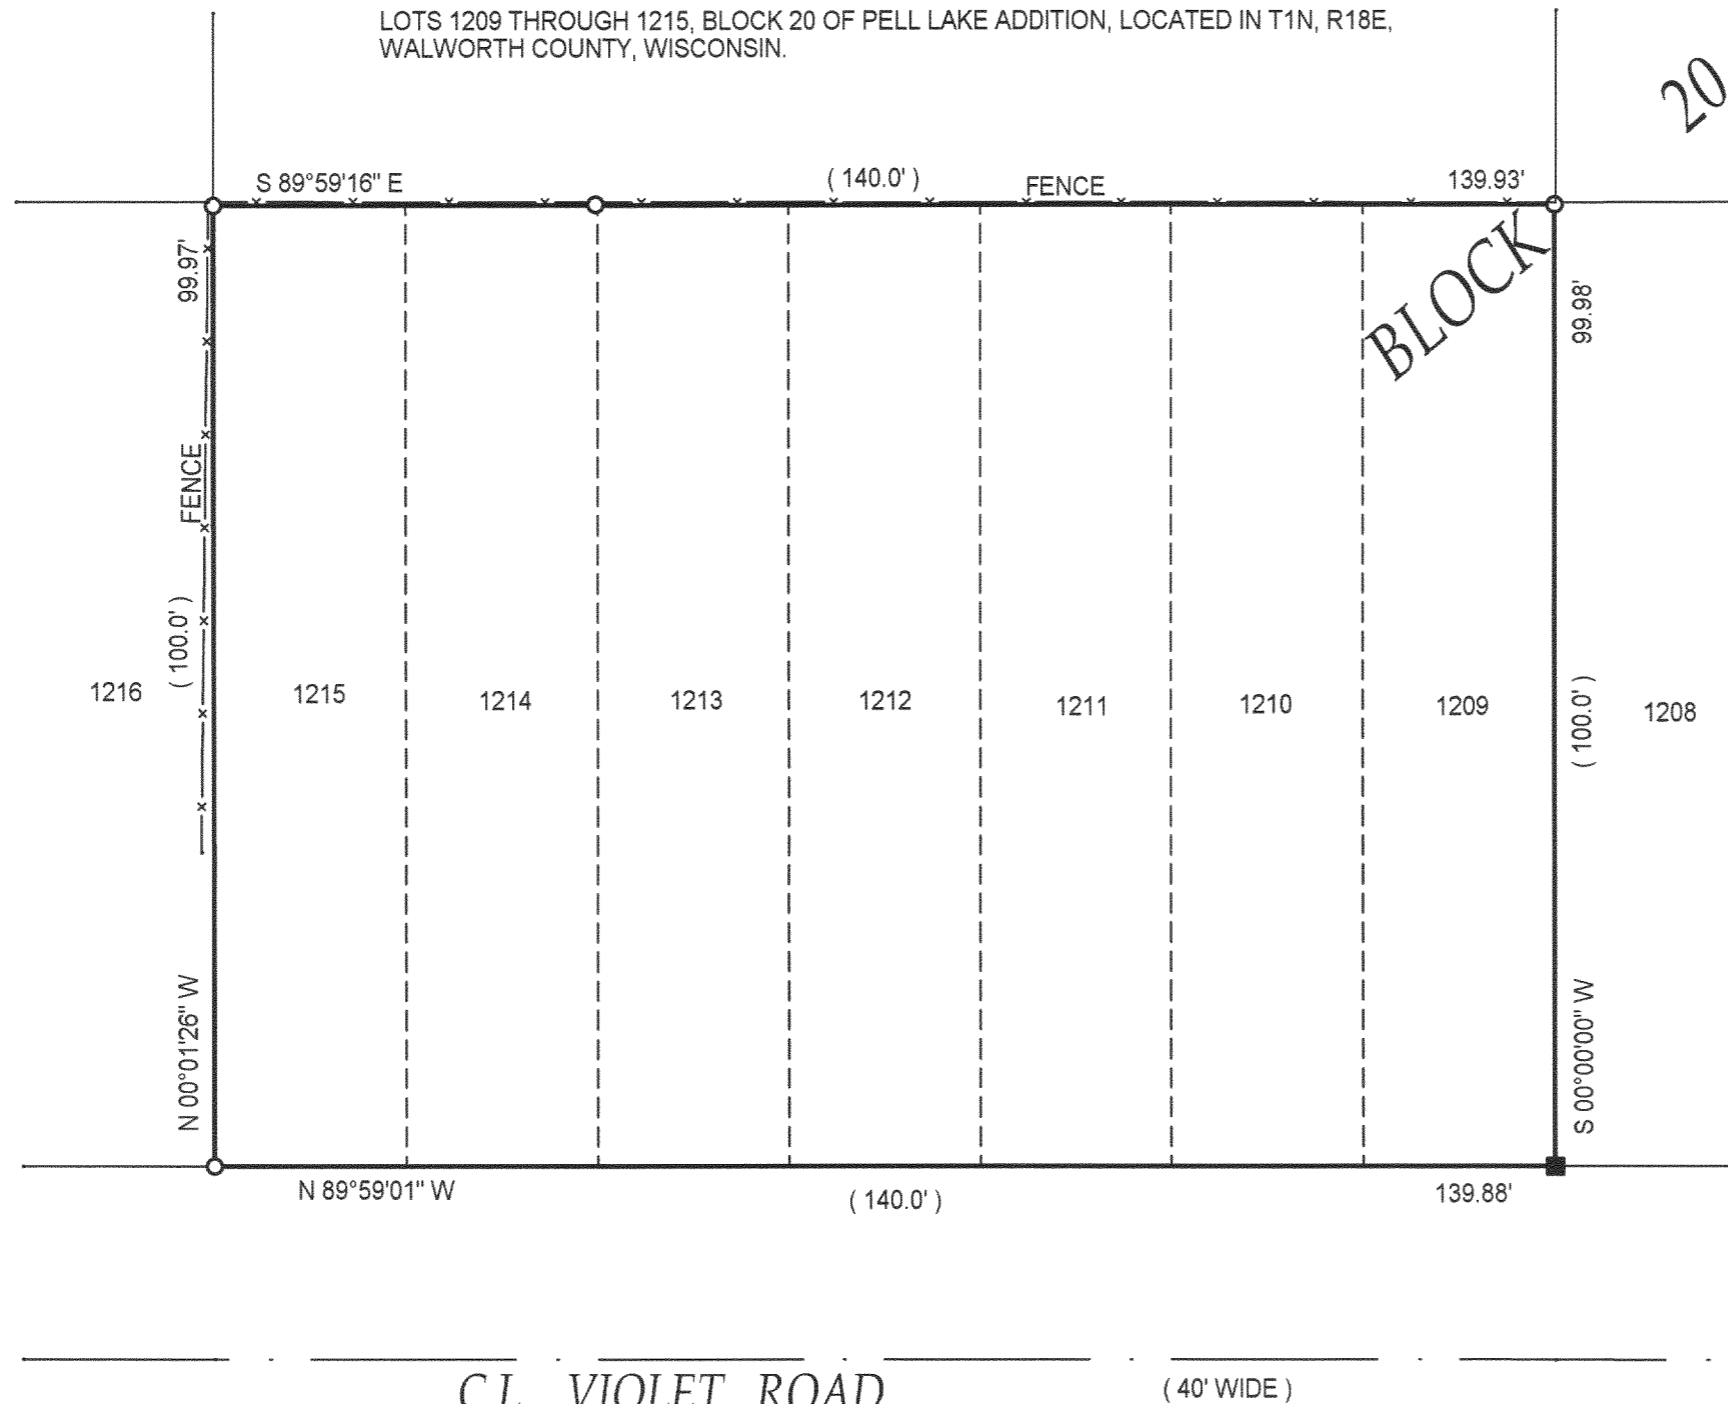

- () = recorded as
- = found iron bar
- = found iron pipe
- = set iron pipe
- = set iron bar

SCALE 1" = 20'

JOB # 03-298

TAX ID # MPLA 00248

C.L. VIOLET ROAD

(40' WIDE)

COMPARE LEGAL DESCRIPTION ABOVE AND DRAWING WITH DEED. FOR BUILDING RESTRICTIONS AND EASEMENTS NOT SHOWN, REFER TO DEED, ABSTRACT SOURCES AND LOCAL MUNICIPAL CODES. NOTIFY THE SURVEYOR IMMEDIATELY OF ANY DISCREPANCY.


"I hereby certify that I have surveyed the above described property and that the above map is a true representation thereof and shows the size and location of all visible structures, apparent easements and encroachments if any."

This survey is made for the present owners of the property, and those who purchase, mortgage, or guarantee the title thereto, within one year from the date hereof.

DATED THIS 05 TH, DAY OF JUNE 20 03

OCT - 3 2003

JRP

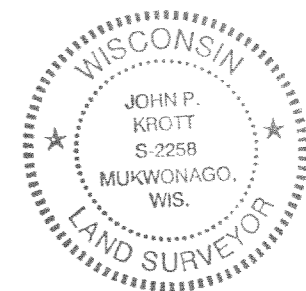

John P. Krott
JOHN KROTT S - 2258
Wisconsin Registered Land Surveyor
(original if signed in red)

118-2348