

PLAT OF SURVEY


- OF -

Site plan for Block 4, showing lots 225 through 231. The plan includes an existing residence with a deck and a concrete driveway. Dimensions are provided for all boundaries and internal features. A north arrow is located in the top right corner. The plan also shows a fence line with a bearing of 0.2° E & 0.3° N and another fence line with a bearing of 0.7° N & 0.2° W. The block is labeled 'BLOCK 4' and the lots are labeled 'lot 231', 'lot 230', 'lot 229', 'lot 228', 'lot 227', 'lot 226', and 'lot 225'.

TAX ID # MPLH 00049

COMPARE LEGAL DESCRIPTION ABOVE AND DRAWING WITH DEED. FOR BUILDING RESTRICTIONS AND EASEMENTS NOT SHOWN, REFER TO DEED. ABSTRACT SOURCES AND LOCAL MUNICIPAL CODES. NOTIFY THE SURVEYOR IMMEDIATELY OF ANY DISCREPANCY.

This survey is made for the present owners of the property, and those who purchase, mortgage, or guarantee the title thereto, within one year from the date hereof. DATED THIS 03 TH, DAY OF APRIL 20 03

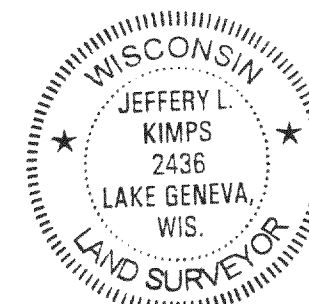

JEFFREY L KIMPS S-2436
Wisconsin Registered Land Surveyor
(original if signed in red)

118-2350