



PLAT OF SURVEY

PREPARED FOR:
JAMES WENSHUTONIS

- OF -

J.K. SURVEYING INC.
N3705 WILLOWBEND LANE
LAKE GENEVA, WI, 53147
262-248-3697

LOT 19, 20 AND 21 AND THAT VACATED PLATTED ROADWAY IN ZUHDE SUBDIVISION BEING 15.0 FEET IN WIDTH AND 136.75 FEET IN LENGTH RUNNING FROM THE SOUTHWEST OF LOT 20, EAST ALONG THE SOUTHERN LINE OF LOT 20, 136.75 FEET TO THE SOUTHEAST CORNER OF LOT 20, THENCE SOUTH IN LINE WITH THE EAST LINE LINE OF SAID LOT 20, 15.00 FEET TO THE NORTHEAST LINE OF LOT 19; THENCE WEST 136.50 FEET TO THE NORTHWEST CORNER OF LOT 19, THENCE NORTH 15.00 FEET TO THE POINT OF BEGINNING, ALL LOCATED IN SECTION 13, TOWN 1 NORTH, RANGE 18 EAST, TOWN OF BLOOMFIELD, WALWORTH COUNTY, WISCONSIN.

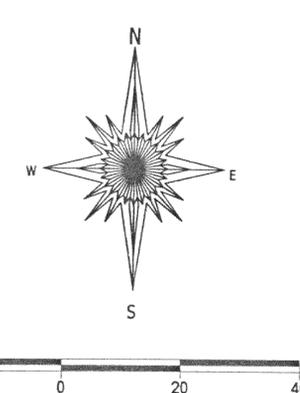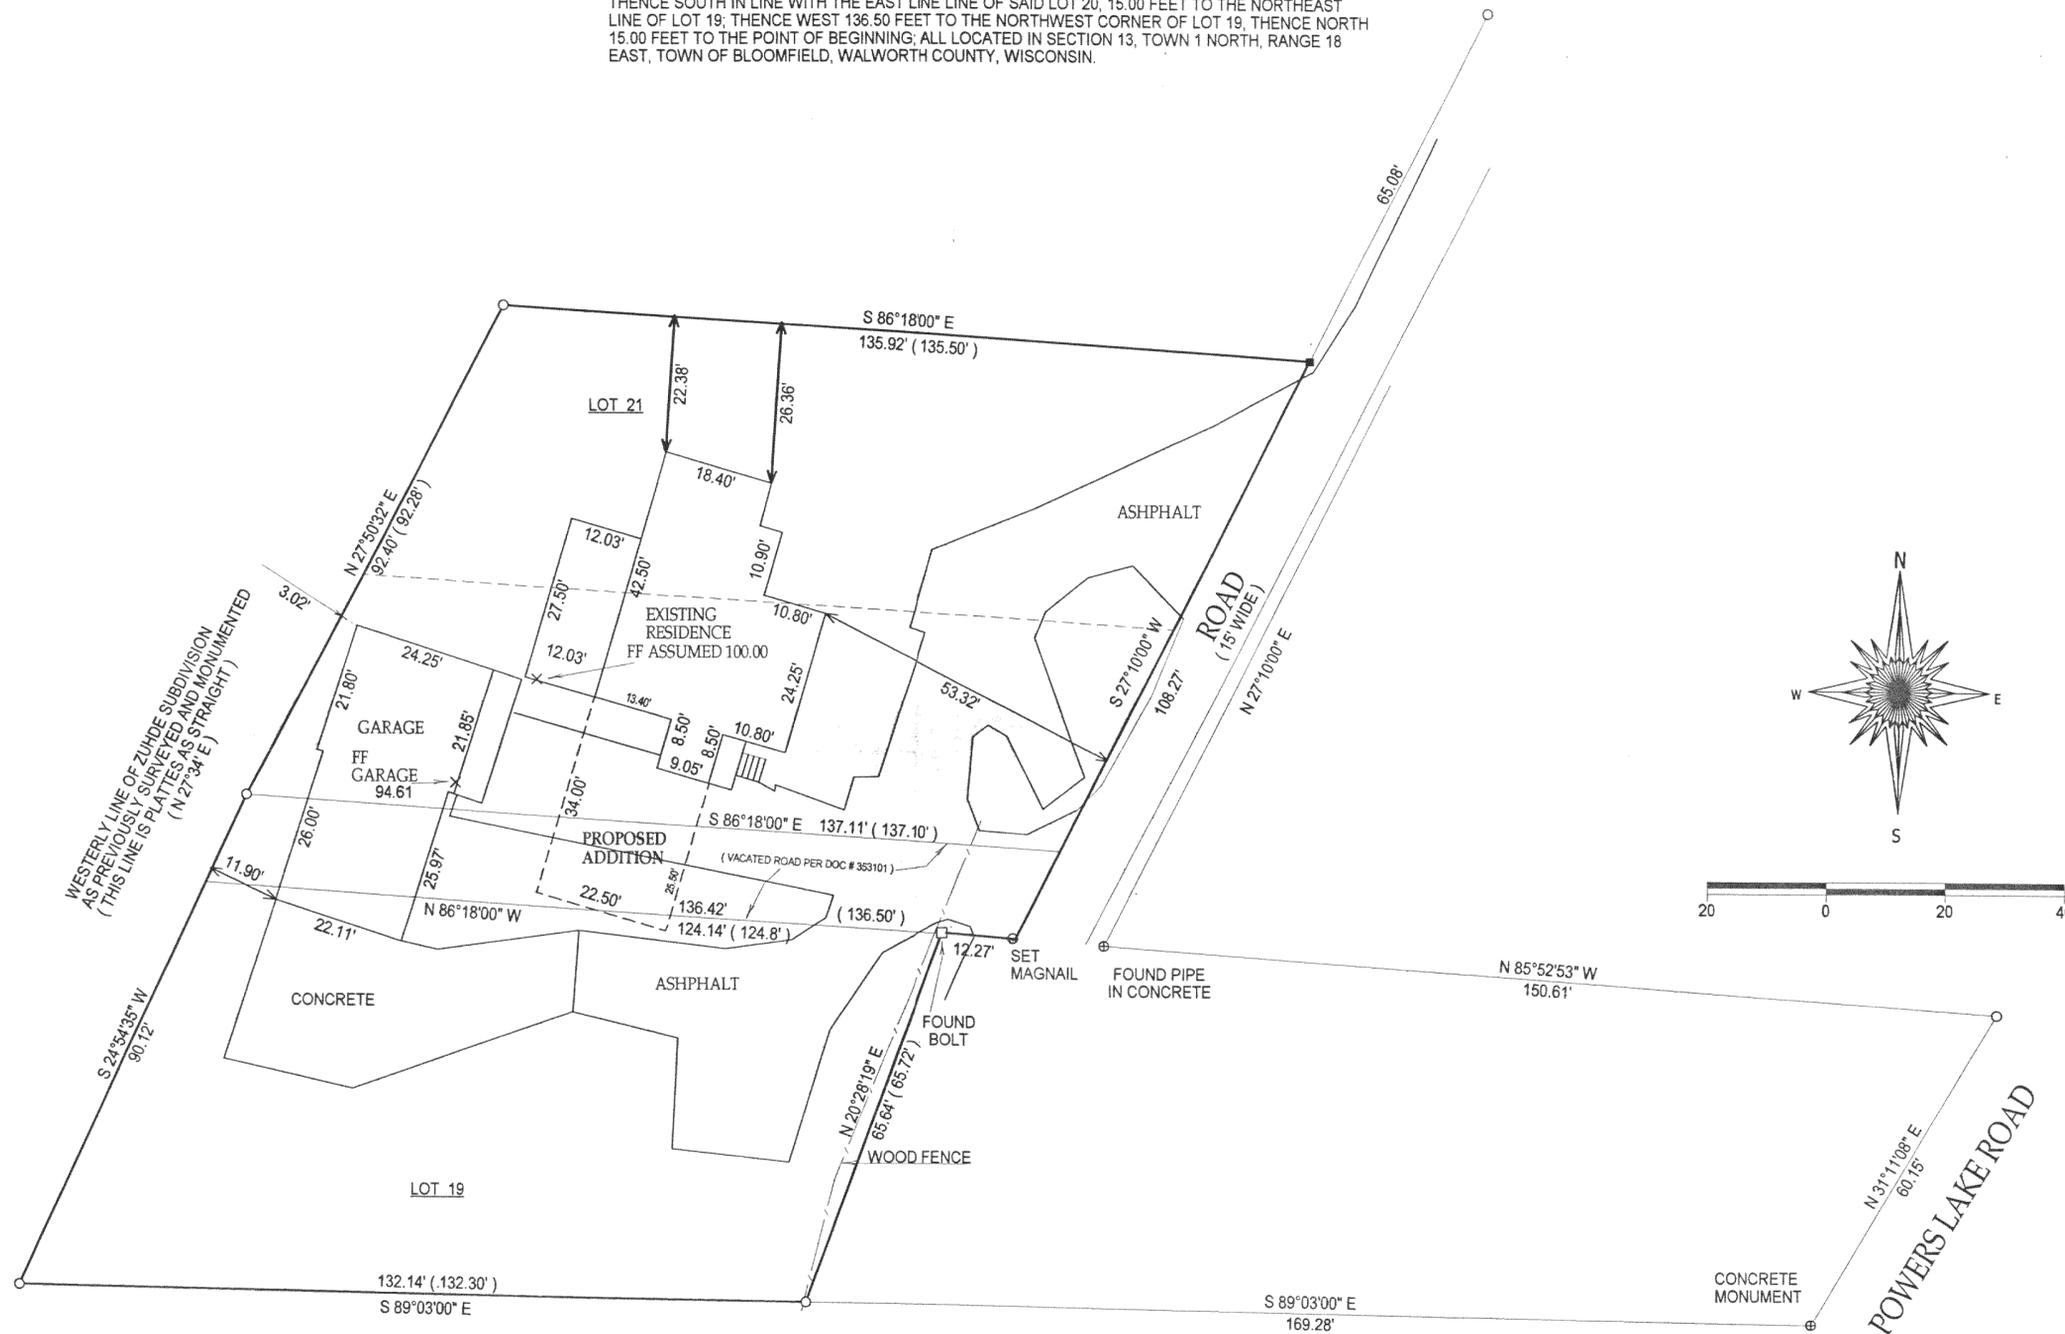

- () = recorded as
- = found iron bar
- = found iron pipe
- = set iron pipe
- = set iron bar

SCALE 1" = 20'
JOB # 03-195

OCT - 3 2003
DRP

COMPARE LEGAL DESCRIPTION ABOVE AND DRAWING WITH DEED, FOR BUILDING RESTRICTIONS AND EASEMENTS NOT SHOWN REFER TO DEED, ABSTRACT SOURCES AND LOCAL MUNICIPAL CODES. NOTIFY THE SURVEYOR IMMEDIATELY OF ANY DISCREPANCY.

"I hereby certify that I have surveyed the above described property and that the above map is a true representation thereof and shows the size and location of all visible structures, apparent easements and encroachments if any."
This survey is made for the present owners of the property, and those who purchase, mortgage, or guarantee the title thereto, within one year from the date hereof.

DATED THIS 29 TH, DAY OF APRIL 20 03

TAX ID # MZ 00020 & MZ 00021

WISCONSIN
JEFFREY L. KIMPS
2436
LAKE GENEVA,
WIS.
LAND SURVEYOR
JEFFREY L. KIMPS S-2436
WISCONSIN REGISTERED LAND SURVEYOR
(original if signed in red)

118-2354