

DEGEN - FOAT SURVEYING LLC

037283
037283S1.DWG




100 SOUTH SECOND STREET
WATERFORD, WISCONSIN 53185
(262)534-5404
(FAX)534-2022

PLAT OF SURVEY

LOT 18 AND LOT 19 OF NIPPERINK HIGHLANDS SUBDIVISION, A SUBDIVISION LOCATED IN THE
NORTHEAST 1/4 OF SECTION 24, TOWN OF BLOOMFIELD, WALWORTH COUNTY, WISCONSIN AND AN
ADDITIONAL 30.0 FEET OF LAND IN DEPTH AND WIDTH OF LOT 19 ON THE REAR LYING NORTHWESTERLY
OF SAID LOT.

* REFER TO A CURRENT TITLE REPORT FOR EASEMENTS, RESTRICTIONS OR COVENANTS OF RECORD THAT MAY AFFECT THIS LAND. *

SURVEY PREPARED FOR: DEBBIE SARNA
RE/MAX - SOUTHERN LAKES
112 ELIZABETH LANE
GENOA CITY, WI 53128

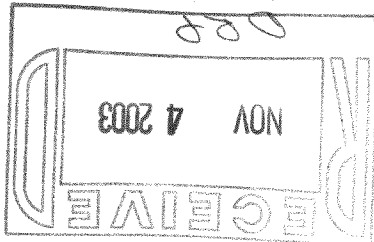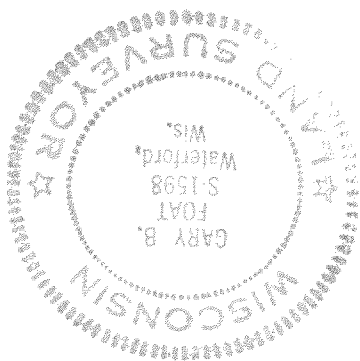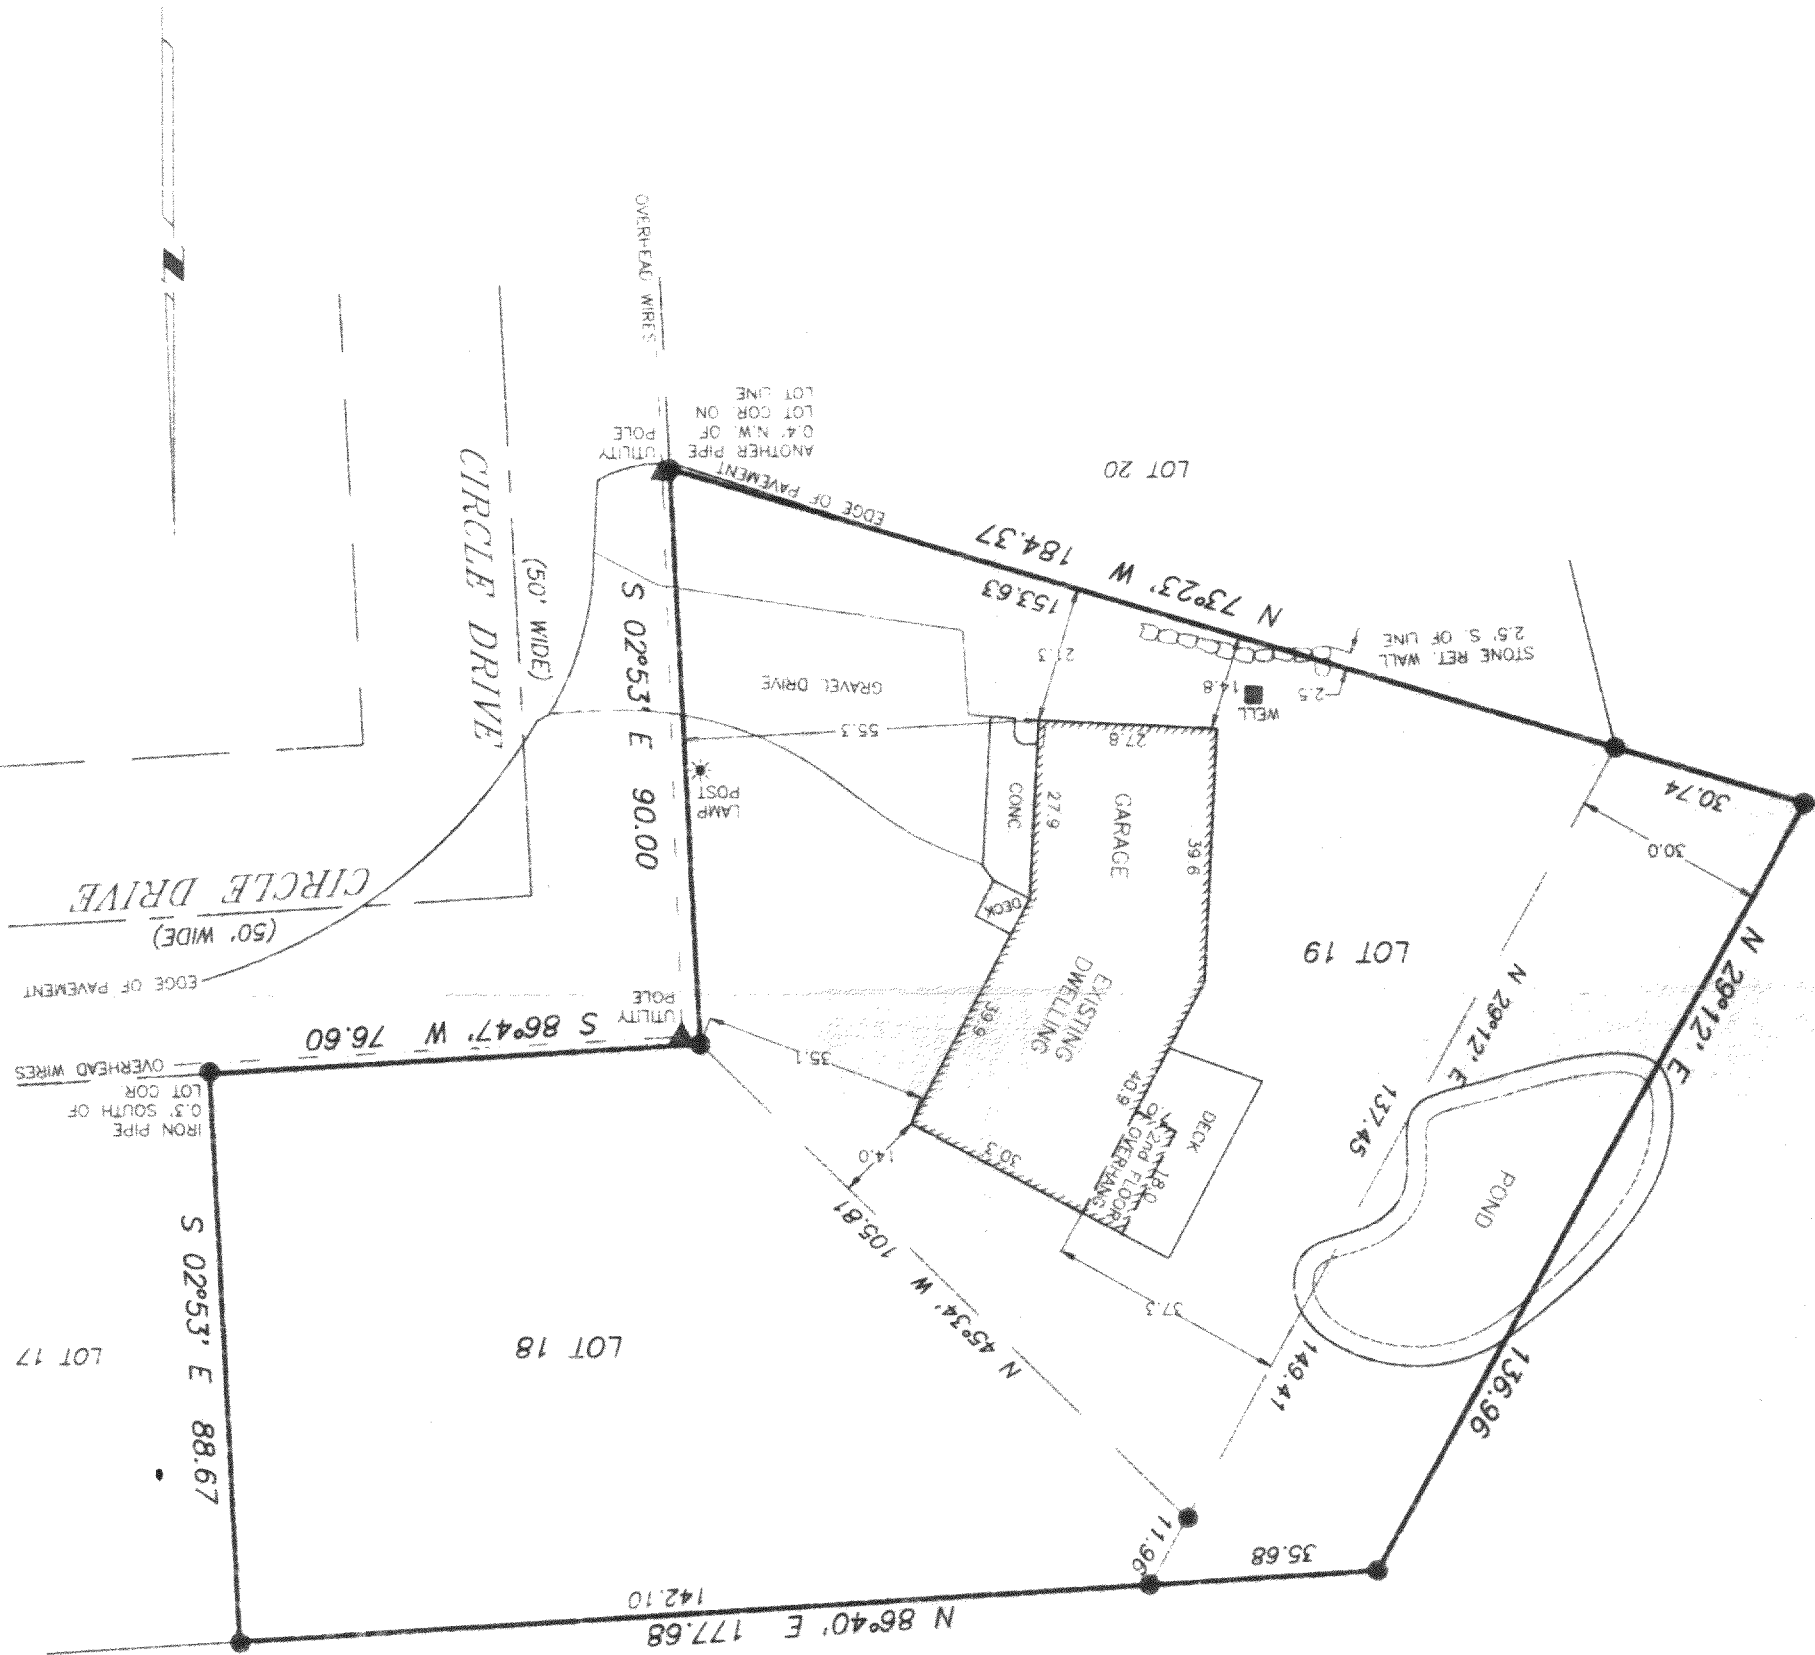

RECEIVED
DATED AT WATERFORD, WI THIS 18th DAY OF SEPTEMBER 20, 2003
GARY B. FOAT

I HEREBY CERTIFY THAT I HAVE SURVEYED THE ABOVE DESCRIBED PROPERTY AND THE ABOVE MAP IS A TRUE REPRESENTATION THEREOF AND SHOWS THE SIZE AND LOCATION OF THE PROPERTY, THE LOCATION OF ALL VISIBLE STRUCTURES AND DIMENSIONS OF ALL PRINCIPAL BUILDINGS THEREON, BOUNDARY FENCES, APPARENT EASEMENTS, ROADWAY AND VISIBLE ENCROACHMENTS, IF ANY.
THIS SURVEY IS MADE FOR THE PRESENT OWNERS OF THE PROPERTY, AND ALSO THOSE WHO PURCHASE OR GUARANTEE THE TITLE THEREIN WITHIN (1) YEAR FROM THE DATE HEREOF

LEGEND
● - FOUND IRON PIPE
() - RECORDED AS

SCALE: 1" = 30'

BEARING BASE AS RECORDED AS