

DEGEN-FOAT SURVEYING LLC


100 SOUTH SECOND STREET
WATERFORD, WISCONSIN
(262)534-5404 (FAX)534-2022

037106
037106S1.DWG

PLAT OF SURVEY

LOTS 1830 THRU 1839, BLOCK 21, PELL LAKE HIGHLANDS, BEING A SUBDIVISION LOCATED IN THE SOUTHEAST 1/4 OF SECTION 16, TOWN 1 NORTH, RANGE 18 EAST, OF THE FOURTH PRINCIPAL MERIDIAN, TOWN OF BLOOMFIELD, WALWORTH COUNTY, WISCONSIN.

* REFER TO CURRENT TITLE REPORT FOR EASEMENTS, RESTRICTIONS OR COVENANTS OF RECORD THAT MAY AFFECT THIS LAND *
* ESPECIALLY THOSE NOT SHOWN ON THE RECORDED PLAT OF PELL LAKE HIGHLANDS SUBDIVISION *


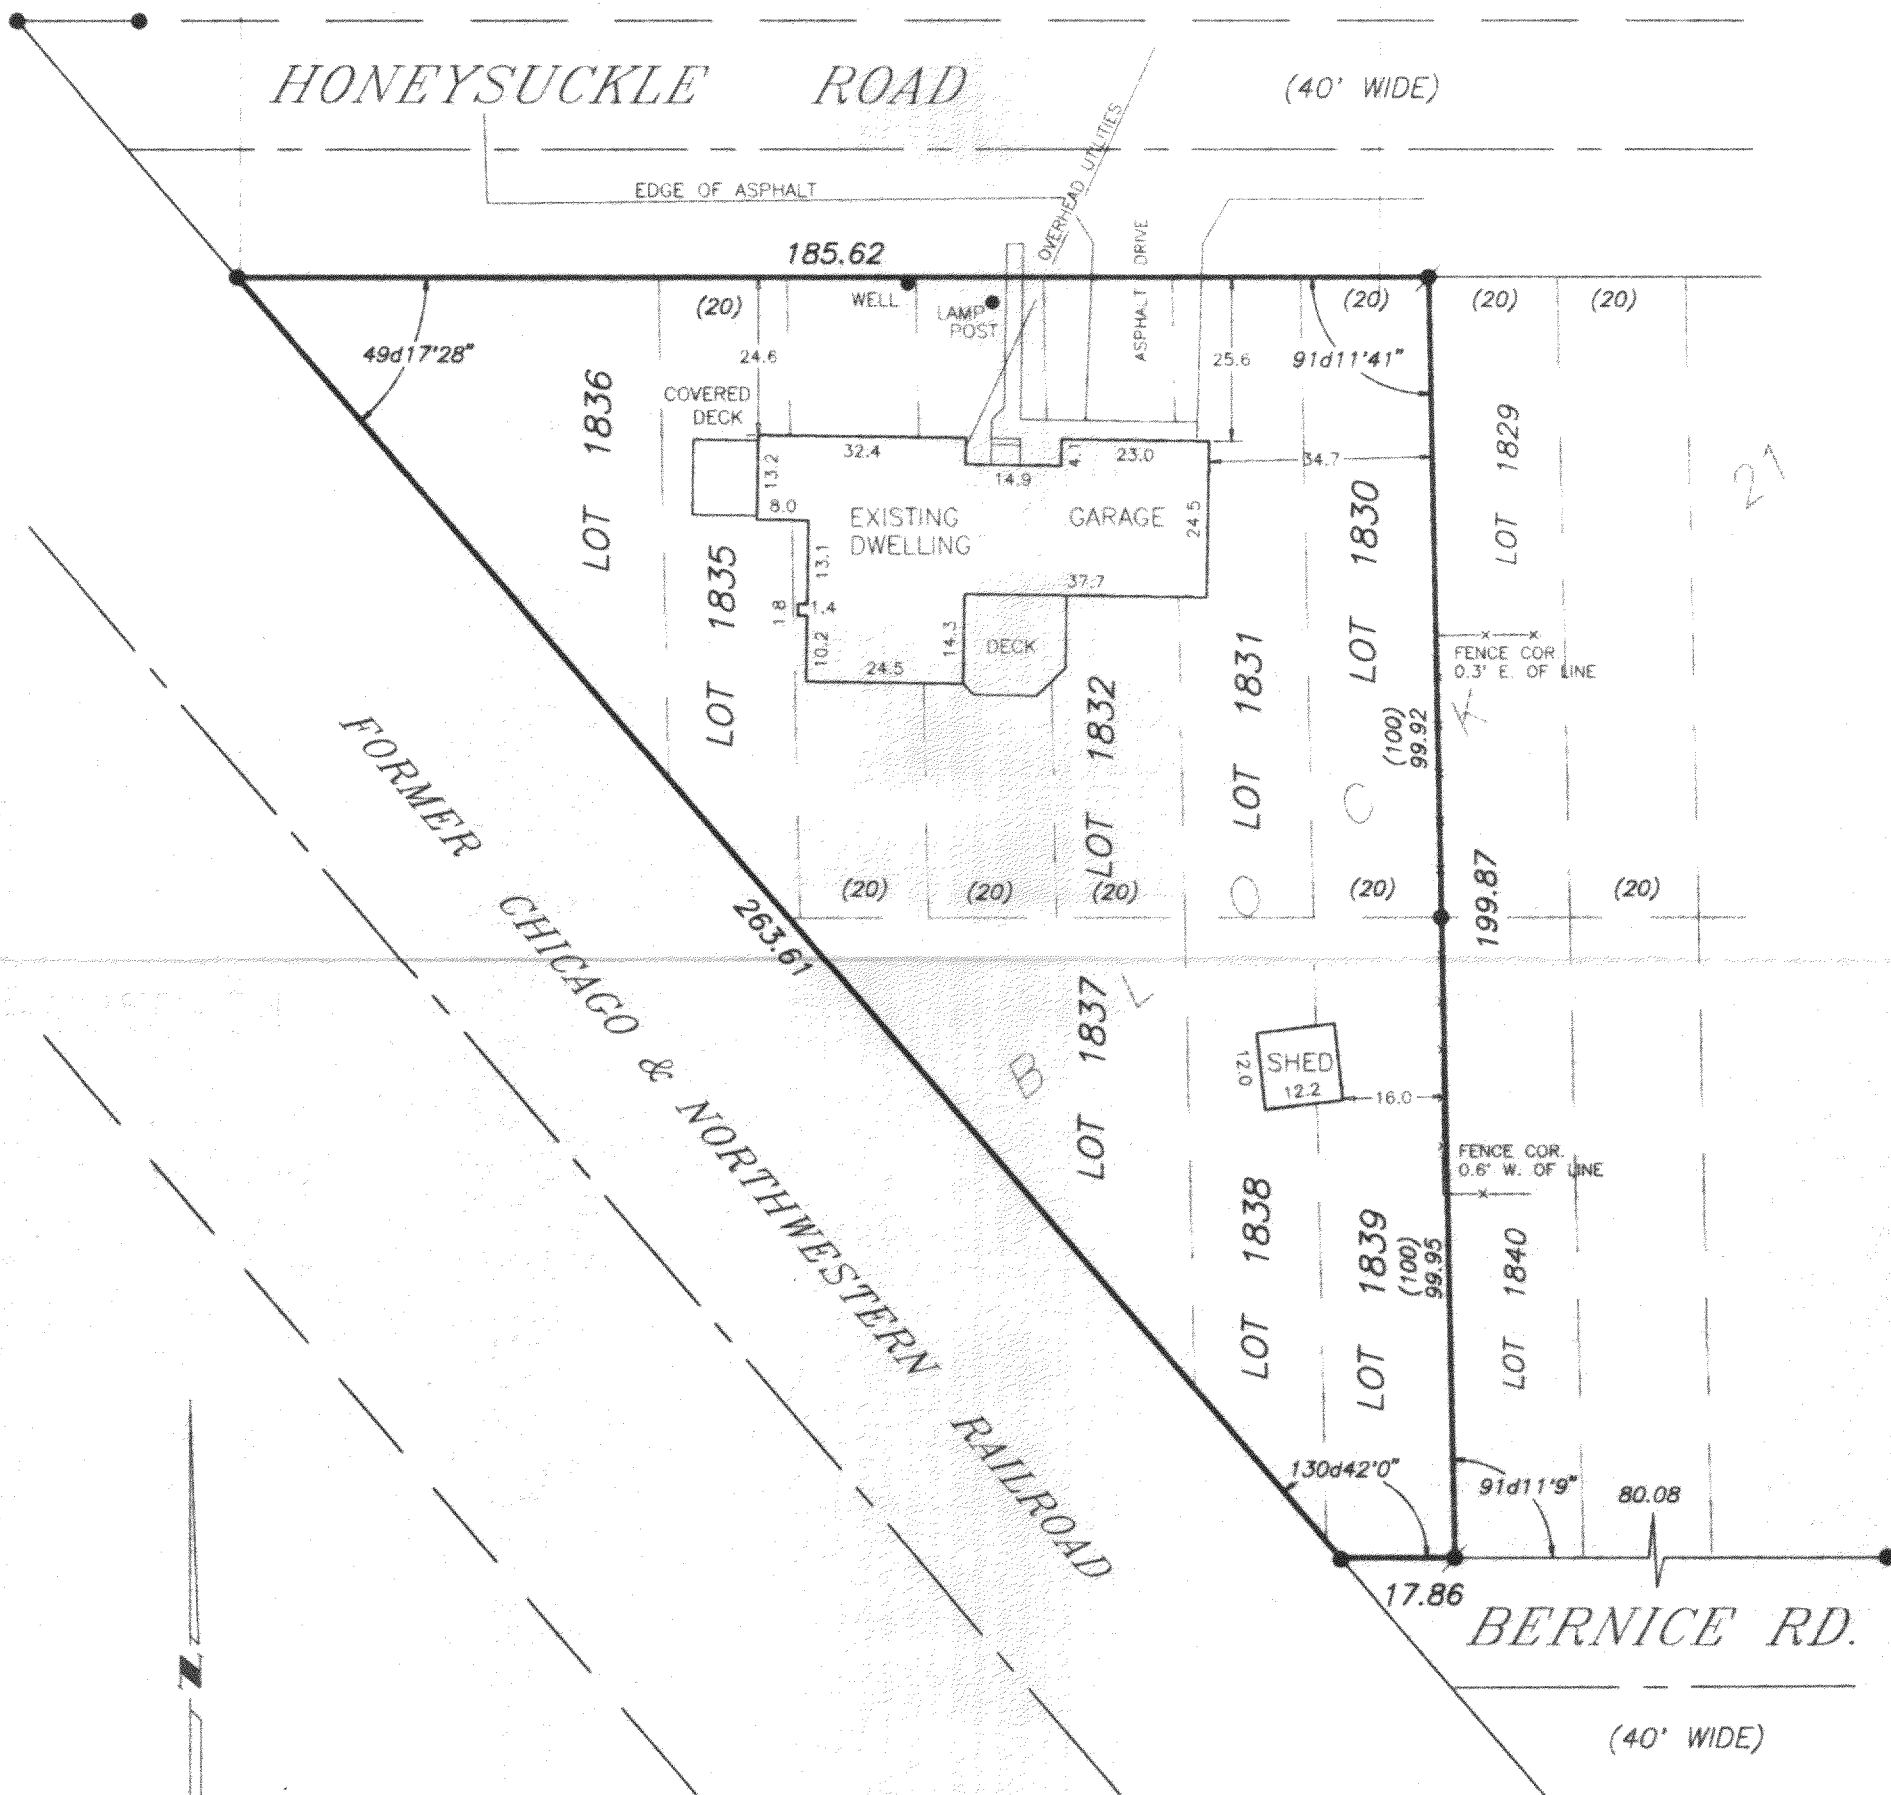


ORDERED BY: ROBERT E. BURKE
4719 WEST ELM STREET
McHENRY, IL 60050

SCALE: 1" = 30'

LEGEND

- - FOUND IRON PIPE
- - FOUND IRON ROD
- () - RECORDED AS

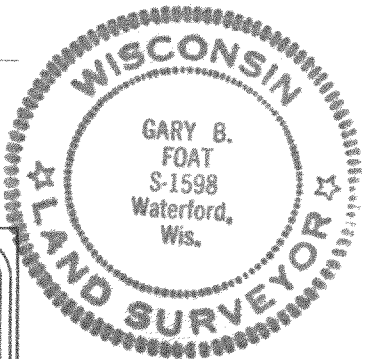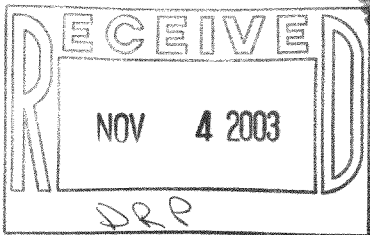

I HEREBY CERTIFY THAT I HAVE SURVEYED THE ABOVE DESCRIBED PROPERTY AND THE ABOVE MAP IS A TRUE REPRESENTATION THEREOF AND SHOWS THE SIZE AND LOCATION OF THE PROPERTY, THE LOCATION OF ALL VISIBLE STRUCTURES AND DIMENSIONS OF ALL PRINCIPAL BUILDINGS THEREON, BOUNDARY FENCES, APPARENT EASEMENTS, ROADWAY AND VISIBLE ENCROACHMENTS, IF ANY.

THIS SURVEY IS MADE FOR THE PRESENT OWNERS OF THE PROPERTY, AND ALSO THOSE WHO PURCHASE OR GUARANTEE THE TITLE THERETO WITHIN (1) YEAR FROM THE DATE HEREOF.

DATED AT WATERFORD THIS 17TH DAY OF APRIL 2003

RECERTIFIED

Gary B. Foat

MPLH-325
MPLH-326

118-2372