

Plat of Survey of
 LOTS 1113 THRU 1117 & LOTS
 1138 THRU 1142 IN BLOCK 8 IN
 PELL LAKE HIGHLANDS

in Section 16-1-18

TOWN OF BLOOMFIELD
 WALWORTH COUNTY, WIS.

-for-
 Johnson Realty
 and
 LaSalle Bank, N.A.


address: W1322 W. Forest Road

LEGAL DESCRIPTION (AS FURNISHED)..... LOTS 1113, 1114, 1115, 1116, 1117, 1138, 1139, 1140, 1141 AND 1142, IN BLOCK 8, AS DESIGNATED AND DELINEATED ON THE MAP ENTITLED "PELL LAKE HIGHLANDS" AND RECORDED IN THE OFFICE OF THE REGISTER OF DEEDS IN AND FOR THE COUNTY OF WALWORTH AND STATE OF WISCONSIN ON THE 12TH DAY OF JUNE 1925, IN VOLUME 8 OF PLATS ON PAGE 27.

J.K.R. SURVEYING, INC.
 8121 22ND AVENUE, KENOSHA, WI. 53143

I hereby certify that the above described property was surveyed under my direction and that this plat is a true representation thereof and shows the size and location of the property, its exterior boundaries, the location and dimensions of all visible structures thereon, fences, apparent easements and roadways and visible encroachments, if any.


This survey is made for the exclusive use of the present owners of the property, and those who purchase, mortgage or guarantee the title thereto, within one (1) year from the date hereof.

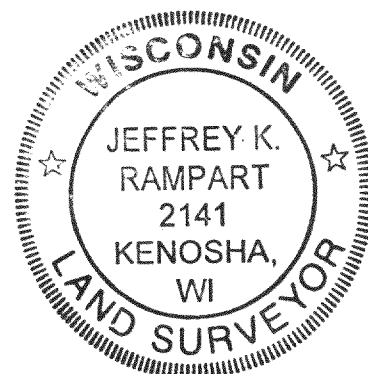

[Signature]
 SURVEYOR
 October 22, 2003

MPLH-235

Lake Geneva (50' r/w) Highway

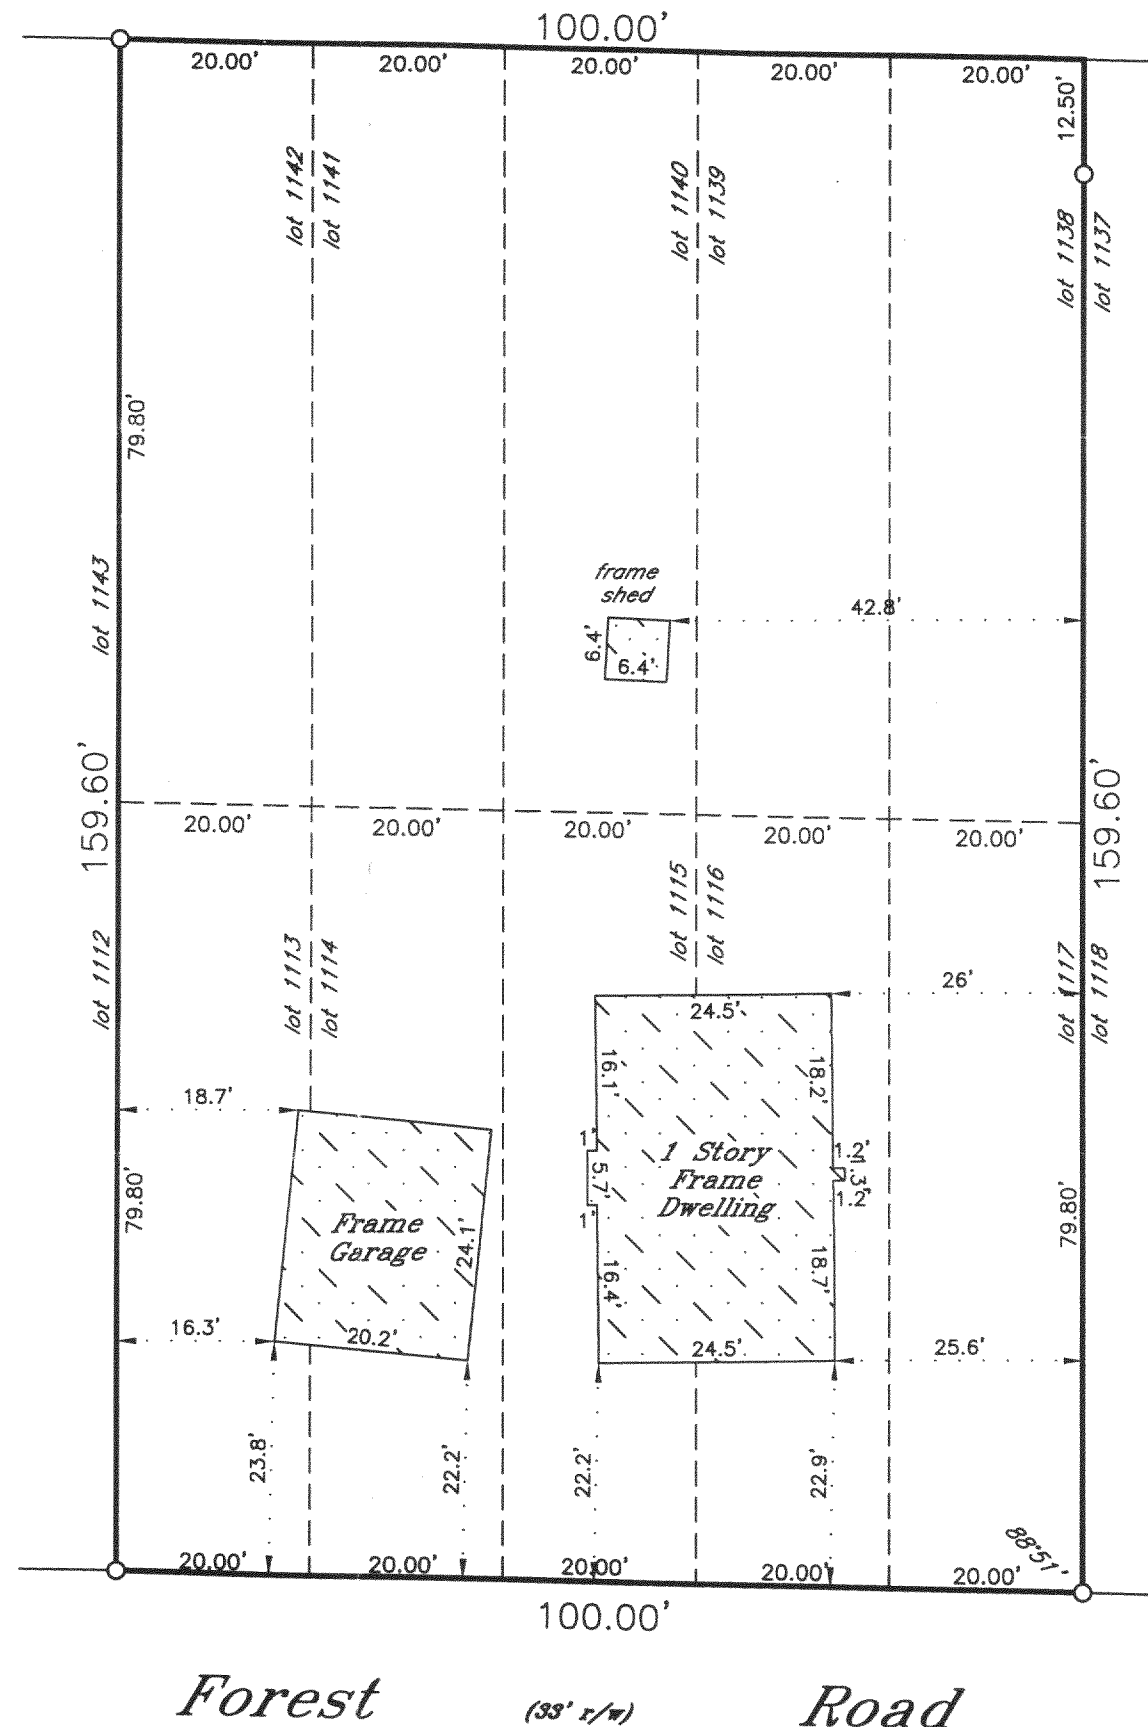

Scale
 1" = 20'

SELLER


The Secretary of Housing and
 Urban Development

BUYER

Gregory Ozog

tax key no.: MPLH 00235

denotes iron
 pipe found

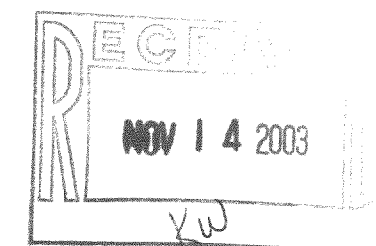

n.t.s. rec. 200'

Clover Road

118-2377