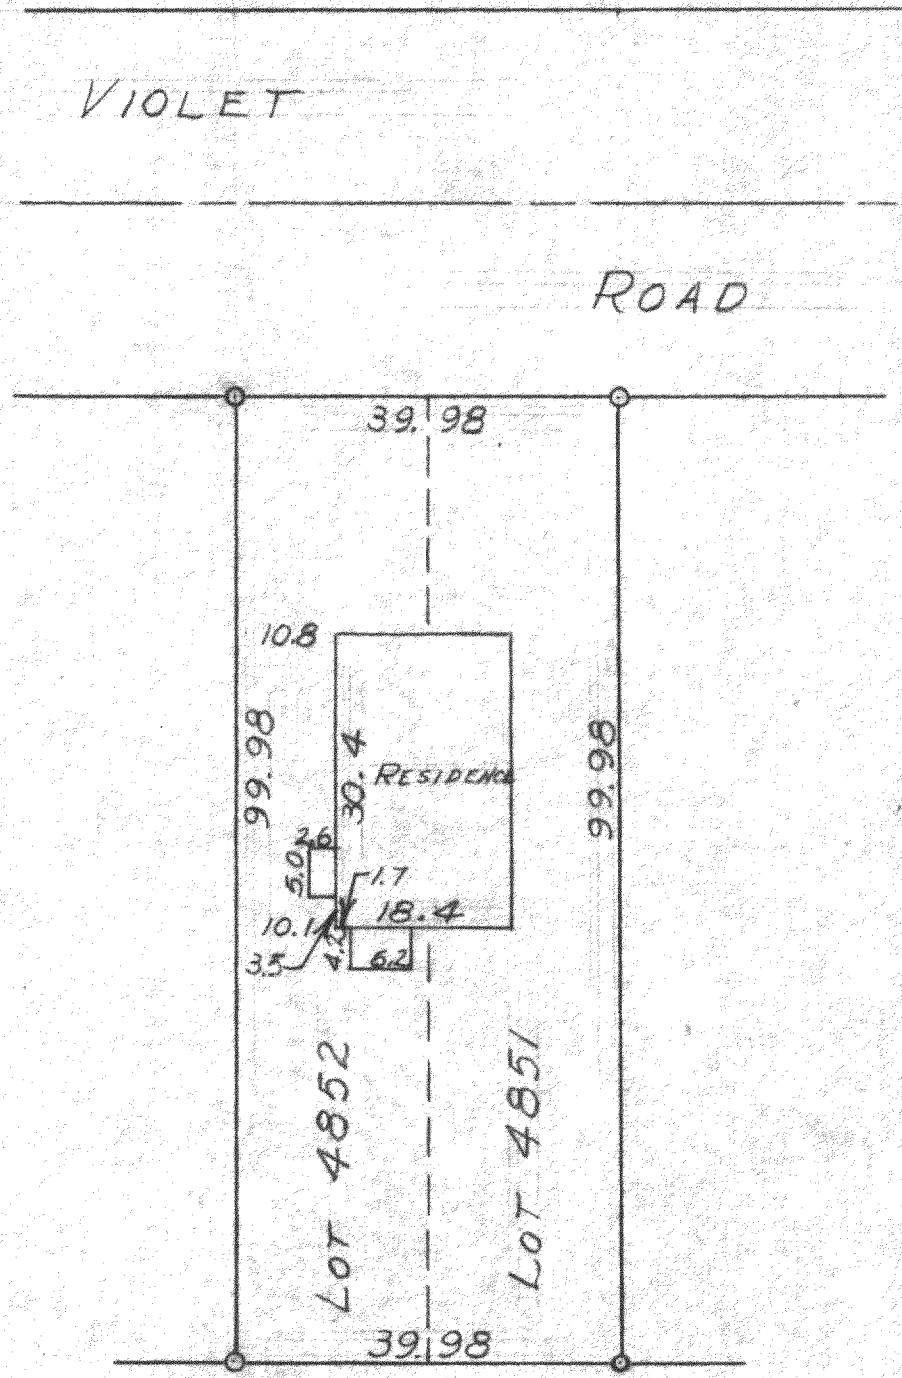


SCALE ~ 1" = 20'
0" ~ IRON PIPE

PLAT OF SURVEY OF LOTS 4851 AND 4852, SECTION 3 OF PELL LAKE
SUBDIVISIONS LOCATED IN T1N18E, WALWORTH COUNTY, WISCONSIN
JULY 20, 1957

George T. Dunham
GEORGE T. DUNHAM, SURVEYOR
DELAVER, WISCONSIN