


PREPARED FOR:  
KTR BUILDERS  
N1495 RYER COURT  
WALWORTH, WI. 53184

PLAT OF SURVEY  
- OF -

J.K. SURVEYING INC.  
N3705 WILLOWBEND LANE  
LAKE GENEVA, WI, 53147  
262-248-3697

A PARCEL OF LAND BEING LOTS 715 THRU 718 AND PART OF LOTS 719 AND 720,  
BLOCK 14 OF PELL LAKE HIGHLANDS A SUBDIVISION LOCATED IN THE SECTION  
16, T.1.N., R.18.E. WALWORTH COUNTY, WISCONSIN.  
DESCRIBED AS FOLLOWS:  
BEGINNING AT THE SOUTHWEST CORNER OF SAID LOT 715; THENCE N 00°00'00" E  
120.10' TO THE NORTHWEST CORNER OF SAID LOT 720; THENCE S 88°38'29" E ALONG  
THE NORTH LINE OF SAID LOT 720, 72.26 FEET; THENCE S 14°08'40" E 31.17 FEET;  
THENCE  
S 88°37'31" E 20.00 FEET; THENCE S 00°04'16" W 90.04 FEET TO THE SOUTHEAST CORNER  
OF SAID LOT 715; THENCE N 88°39'05" W 99.77 FEET TO THE POINT OF BEGINNING.  
SAID PARCEL CONTAINS. 11271.55 SQUARE FEET MORE OR LESS.

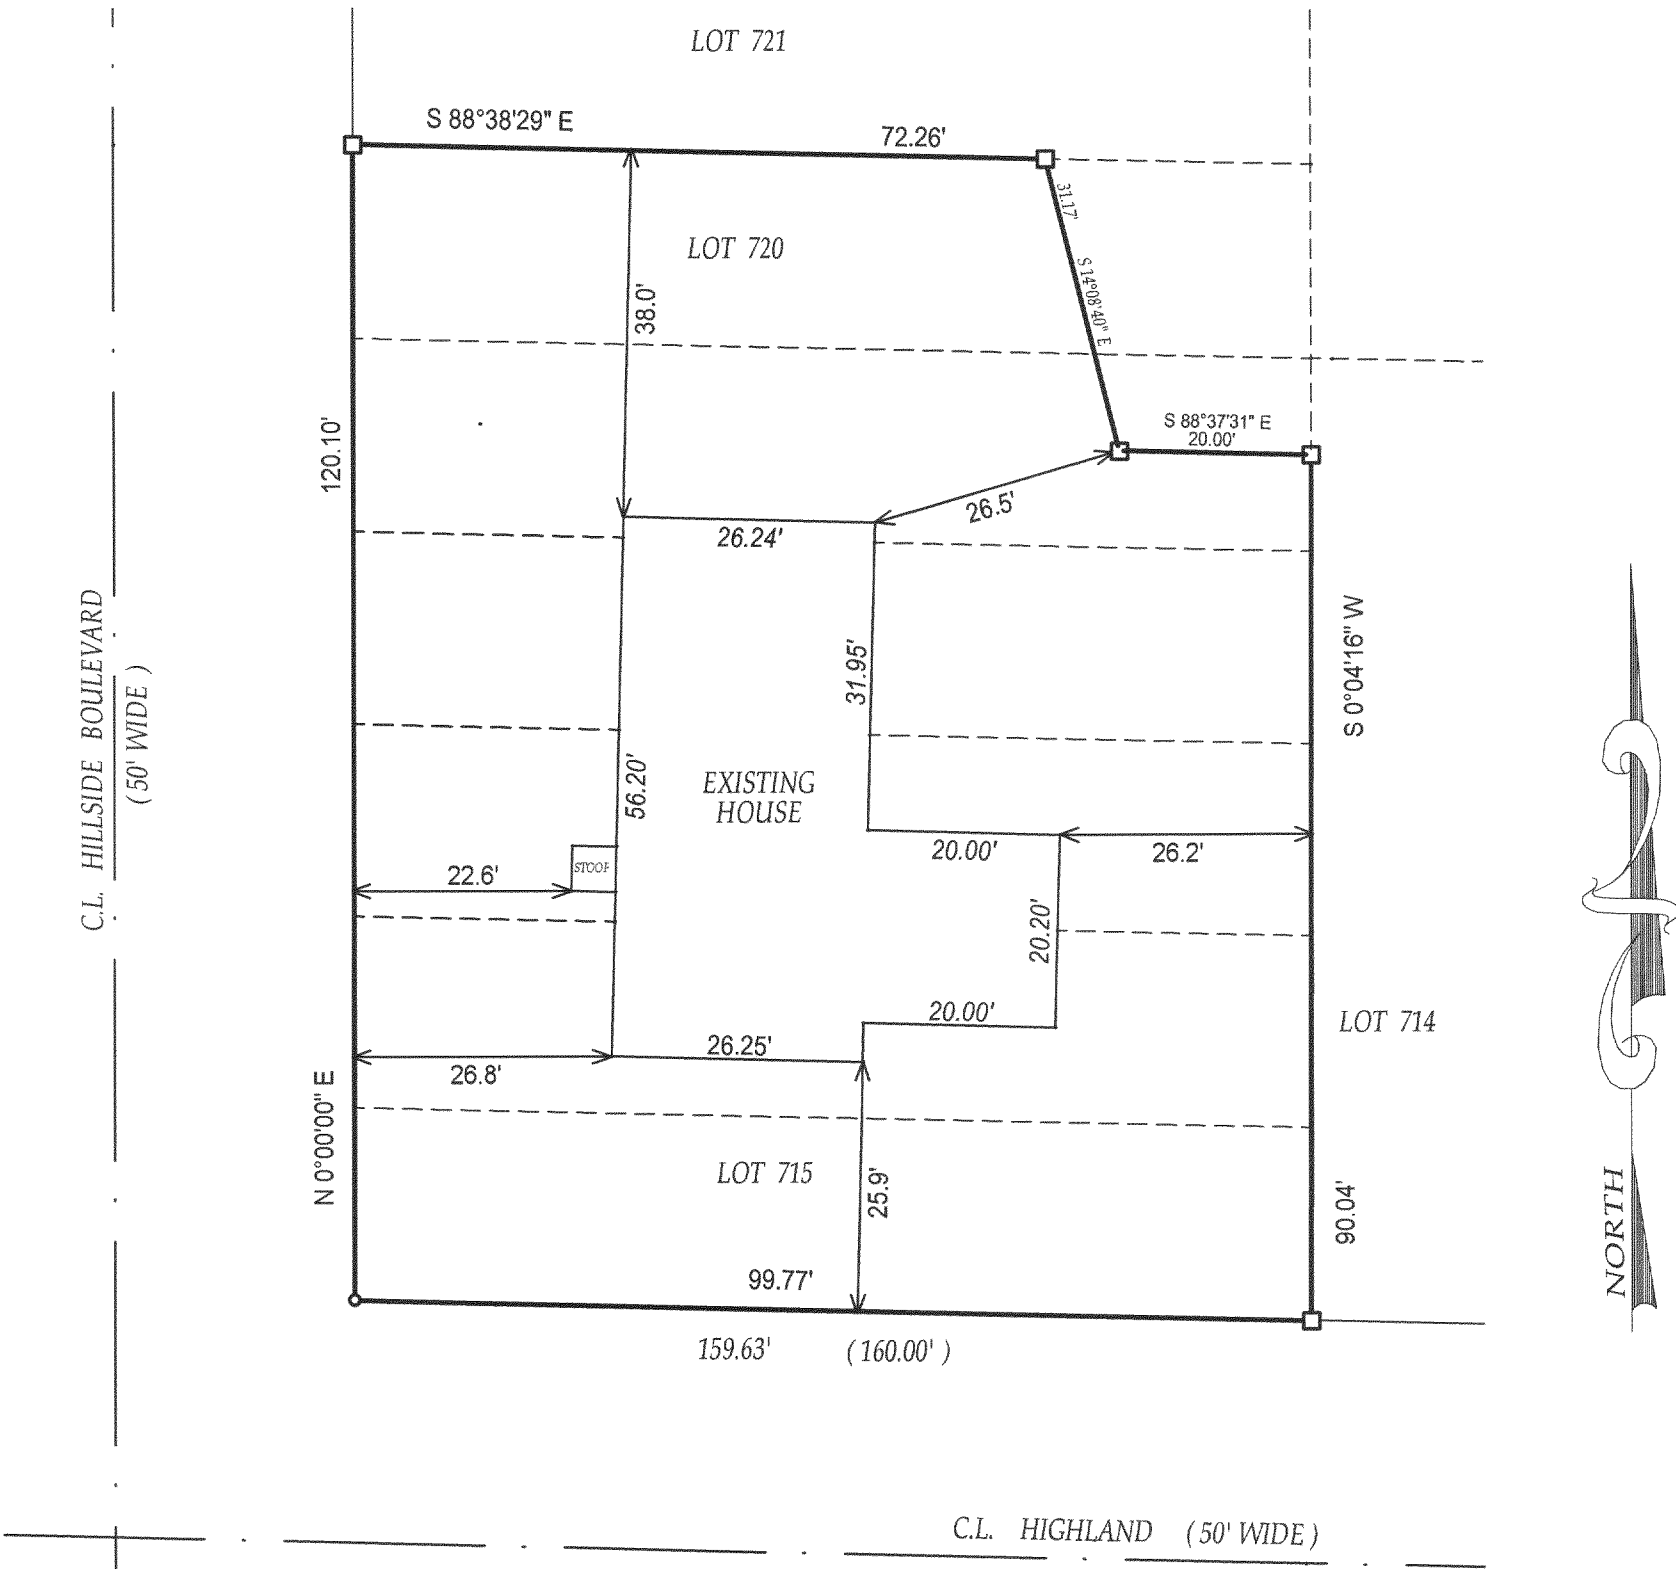


- ( ) = recorded as
- = found iron bar
- = found iron pipe
- = set iron pipe
- = set iron bar

SCALE 1" = 20'

JOB # 03-203AB

TAX ID # MPLH-155 A

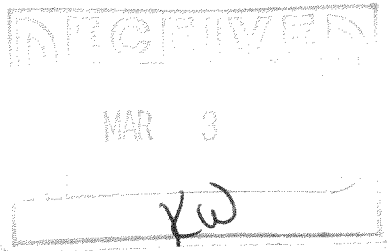


REVISED 06 / 25 / 03  
DATE OF LAST REVISION 10-22-03.

COMPARE LEGAL DESCRIPTION ABOVE AND DRAWING WITH DEED. FOR BUILDING RESTRICTIONS AND  
EASEMENTS NOT SHOWN, REFER TO DEED, ABSTRACT SOURCES AND LOCAL MUNICIPAL CODES. NOTIFY  
THE SURVEYOR IMMEDIATELY OF ANY DISCREPANCY.

"I hereby certify that I have surveyed the above described property and that  
the above map is a true representation thereof and shows the size and  
location of all visible structures, apparent easements and encroachments  
if any."

This survey is made for the present owners of the property, and those who  
purchase, mortgage, or guarantee the title thereto, within one year from  
the date hereof.

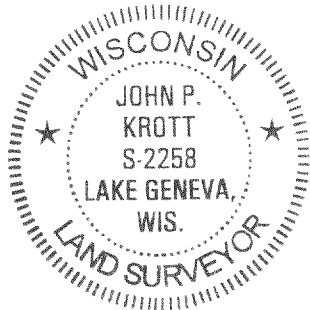

*John P. Krott*  
JOHN KROTT S - 2258  
Wisconsin Registered Land Surveyor  
(original if signed in red)

DATED THIS 21st, DAY OF APRIL, 2003

118-2416