


PREPARED FOR : THE PROPERTY SHOP
C/O LUCY BRENNAN
N1178 CLOVER RD.
PELL LAKE WI. 53157

PLAT OF SURVEY
- OF -

LOTS 876-884 , BLOCK 12 PELL LAKE HIGHLANDS, ACCORDING TO
THE RECORD PLAT THEREOF, AS RECORDED IN THE OFFICE OF THE REGISTER
OF DEEDS FOR WALWORTH COUNTY AND THE STATE OF WISCONSIN, ON THE
12TH DAY OF JUNE, 1925 IN VOLUME 8 OF PLATS PAGE 27.

C.L. OAKWOOD ROAD
(40' WIDE ROAD)

J.K. SURVEYING INC.
N3705 WILLOWBEND LANE
LAKE GENEVA, WI, 53147
262-248-3697

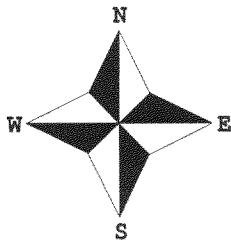




- () = recorded as
□ = found iron bar
○ = found iron pipe
● = set iron pipe
■ = set iron bar

SCALE 1" = 20'

JOB # 03-735

TAX ID # MPLH00185

NOTE : BEARINGS ARE ASSUMED.

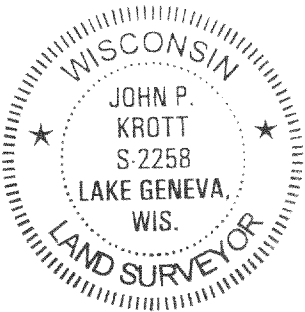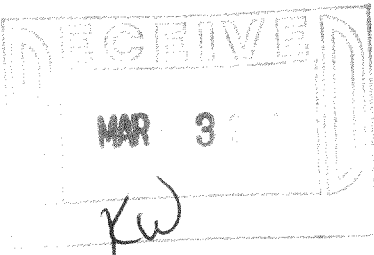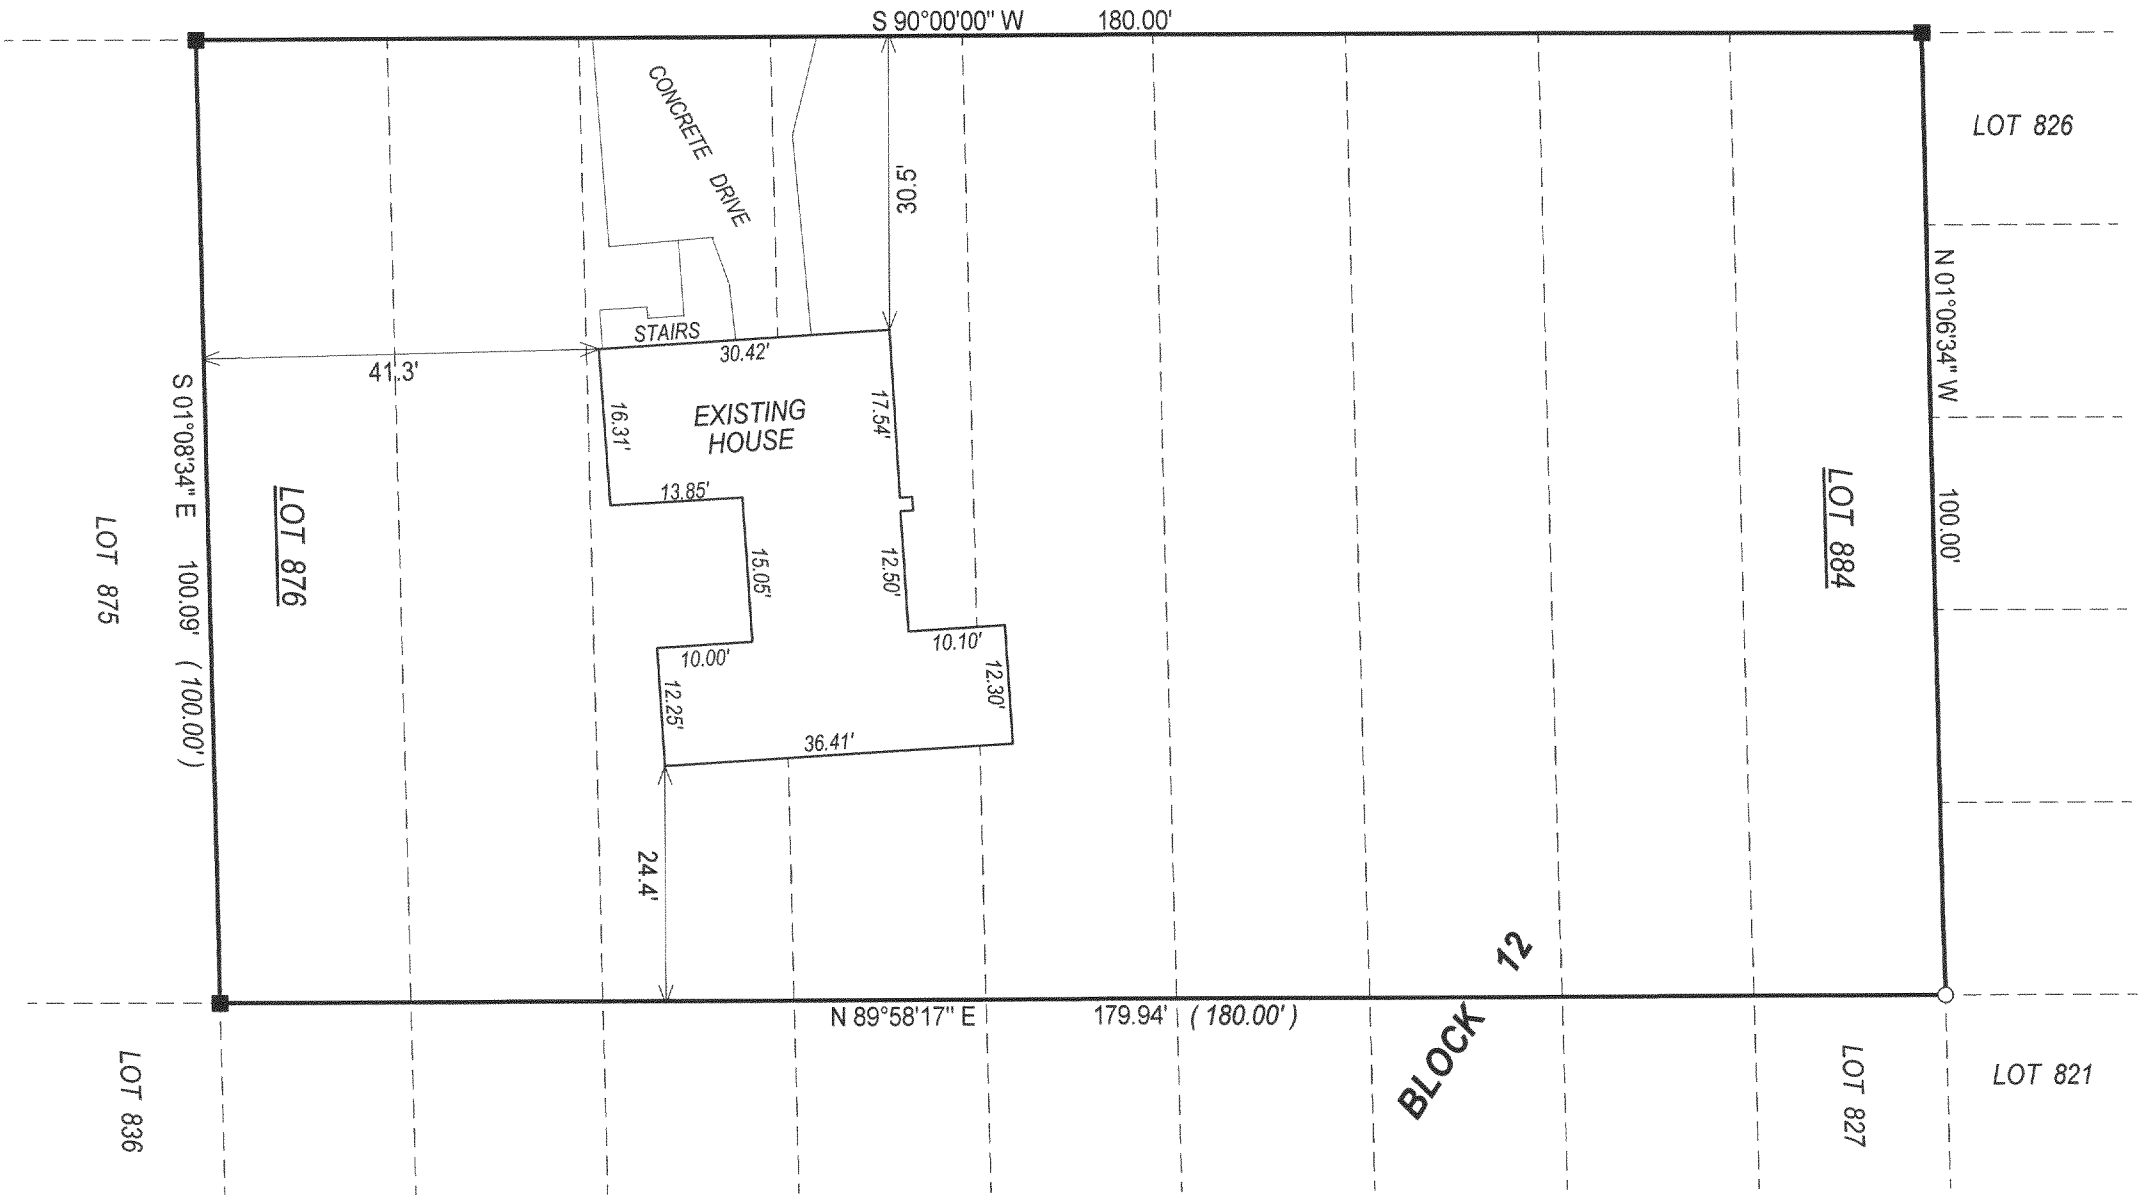

COMPARE LEGAL DESCRIPTION ABOVE AND DRAWING WITH DEED. FOR BUILDING RESTRICTIONS AND
EASEMENTS NOT SHOWN, REFER TO DEED, ABSTRACT SOURCES AND LOCAL MUNICIPAL CODES. NOTIFY
THE SURVEYOR IMMEDIATELY OF ANY DISCREPANCY.

"I hereby certify that I have surveyed the above described property and that
the above map is a true representation thereof and shows the size and
location of all visible structures, apparent easements and encroachments
if any."

This survey is made for the present owners of the property, and those who
purchase, mortgage, or guarantee the title thereto, within one year from
the date hereof.

John P. Krott

JOHN KROTT S - 2258
Wisconsin Registered Land Surveyor
(original if signed in red)

DATED THIS THE 19th DAY OF NOVEMBER 2003.

118-2417