

REGISTERED PROFESSIONAL LAND SURVEYOR
LAKE GENEVA, WISCONSIN

100.00

22


ROSEWOOD

N

LEGEND

- ♂ — IRON PIPE FOUND
 ○ — IRON PIPE PLACED
 ● — CONCRETE MONUMENT
 X — SPIKE

SCALE - 1" = 40'

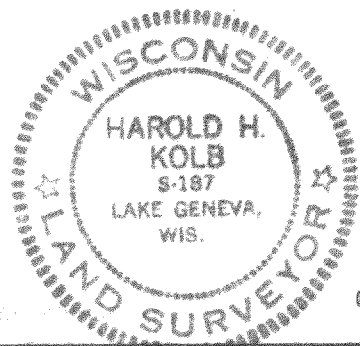

PLAT OF SURVEY OF
Lots 2874 to 2878 and Lots
2884 to 2889, Block 57, Pell
Lake Subd., Walworth County,
Wisconsin

57
02'

I, HAROLD H. KOLB, DO HEREBY CERTIFY THAT I HAVE SURVEYED THE PROPERTY HEREON DESCRIBED ACCORDING TO THE OFFICIAL RECORDS, AND THAT THE PLAT HEREON IS A CORRECT REPRESENTATION OF THE LOT LINES, and the principal lines of the buildings thereon.

Harold H. Kolb

HAROLD H. KOLB

WISCONSIN REGISTERED LAND SURVEYOR, S-187

DATE SEPT. 20, 1968

Revised: October 3, 1968

MP L-601,604

118-244