


PREPARED FOR:  
JAVIER REYES  
1156 ROSEWOOD DR.  
GENOA CITY, WI 53128

# PLAT OF SURVEY

-OF-

LOTS 2364 - 2368, BLOCK 56 PELL LAKE SUBDIVISION,  
A SUBDIVISION LOCATED IN SECTION 22, TOWN 1 NORTH,  
RANGE 18 EAST, TOWN OF BLOOMFIELD, WALWORTH  
COUNTY, WISCONSIN.

J.K. SURVEYING INC.  
N3705 WILLOWBEND LANE  
LAKE GENEVA, WI 53147  
(262) 248-3697

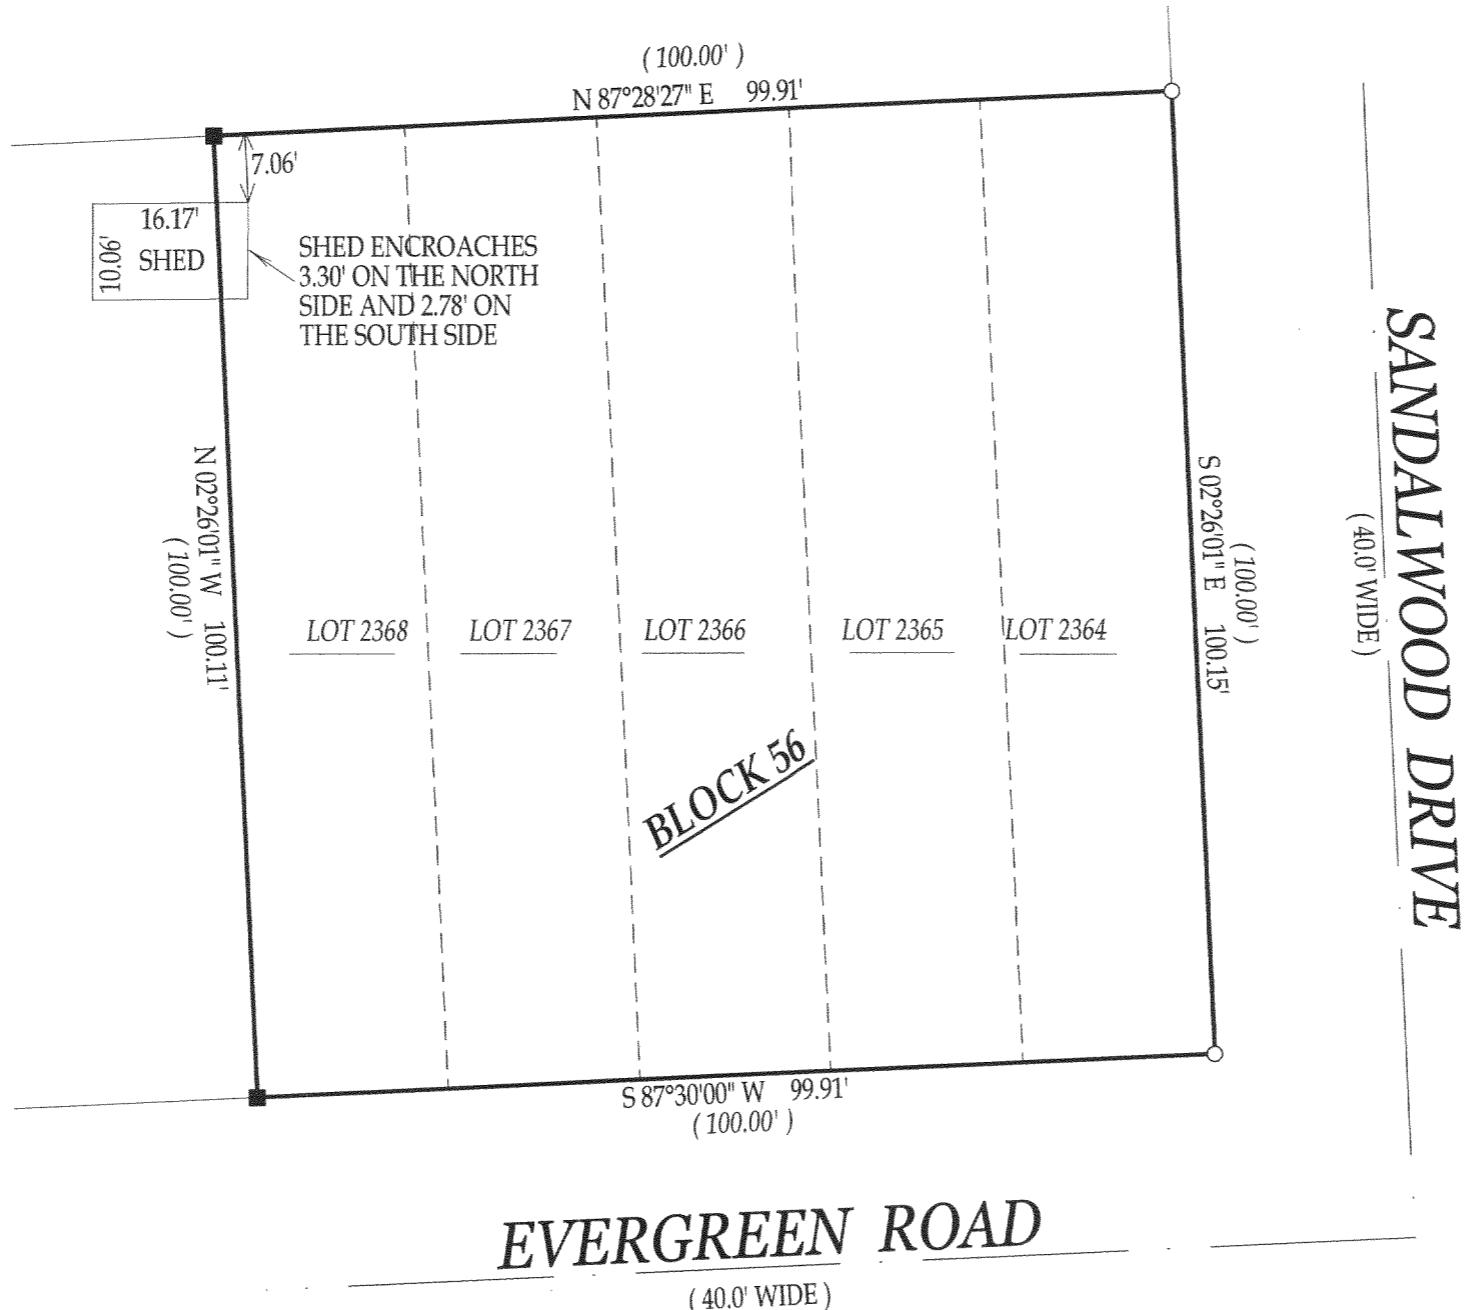



( ) = RECORDED AS  
 = FOUND IRON BAR  
 = FOUND IRON PIPE  
 = SET IRON BAR  
 = SET IRON PIPE  
SCALE: 1" = 20'  
JOB #: 04-137  
TAX ID #: MPL 0490

COMPARE LEGAL DESCRIPTION ABOVE AND DRAWING WITH DEED. FOR BUILDING RESTRICTIONS AND  
EASEMENTS NOT SHOWN, REFER TO DEED, ABSTRACT SOURCES AND LOCAL MUNICIPAL CODES. NOTIFY  
THE SURVEYOR IMMEDIATELY OF ANY DISCREPANCY.

"I hereby certify that I have surveyed the above described property and that  
the above map, to the best of my knowledge and belief, is a true representation  
thereof and shows the size and location of all visible structures, apparent  
easements and encroachments if any."

This survey is made for the present owners of the property, and those who  
purchase, mortgage, or guarantee the title thereto, within one year from  
the date hereof.

NOTE: BEARINGS ARE ASSUMED.

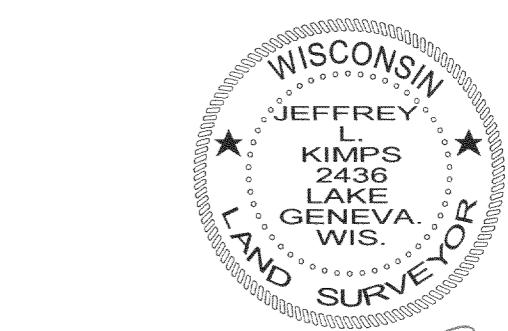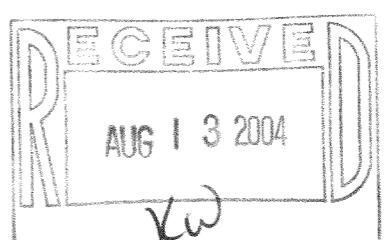

JEFFREY L. KIMPS S-2436  
Wisconsin Registered Land Surveyor  
(original if signed in red)

DATED THIS 30th DAY OF MARCH, 2004

118-2459