


HAROLD H. KOLB

REGISTERED PROFESSIONAL LAND SURVEYOR
LAKE GENEVA, WISCONSIN



PLAT OF SURVEY OF
Lots 5861 to 5867, Block 132, Pell Lake
Subd., Section 4, T 1 N R 18 E,
Walworth County, Wisconsin

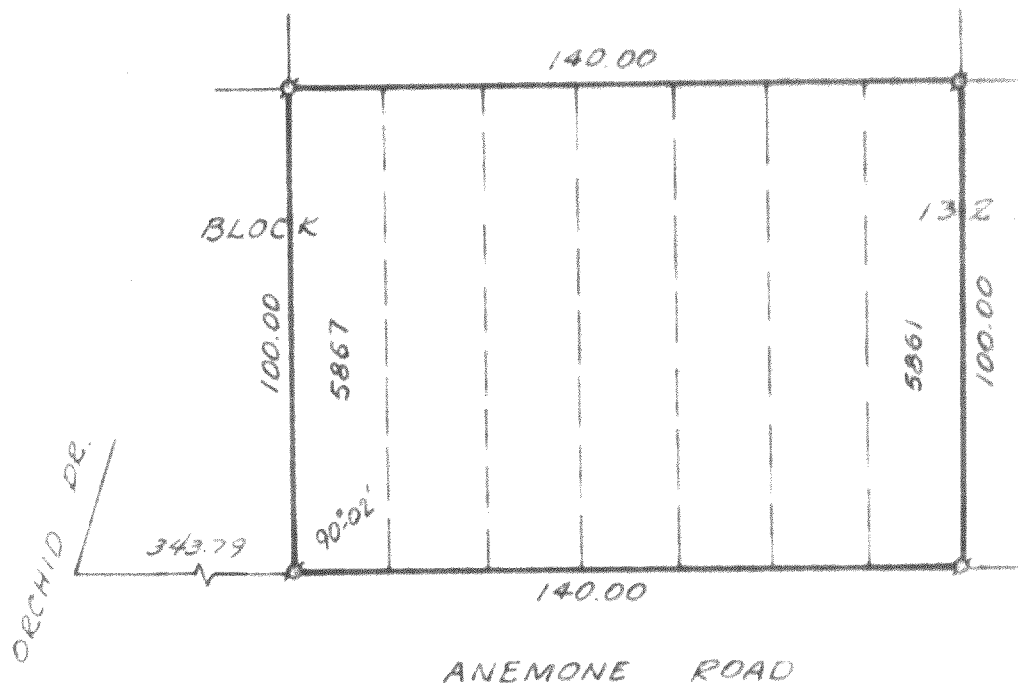

LEGEND

- X — IRON PIPE FOUND
 - O — IRON PIPE PLACED
 - — CONCRETE MONUMENT
 - X — SPIKE
- SCALE - 1" = 40'


I, HAROLD H. KOLB, DO HEREBY CERTIFY THAT I HAVE
SURVEYED THE PROPERTY HEREON DESCRIBED ACCORDING
TO THE OFFICIAL RECORDS, AND THAT THE PLAT HEREON
IS A CORRECT REPRESENTATION OF THE LOT LINES.

Harold H. Kolb

HAROLD H. KOLB

WISCONSIN REGISTERED LAND SURVEYOR, S-187

DATE OCT. 8, 1968

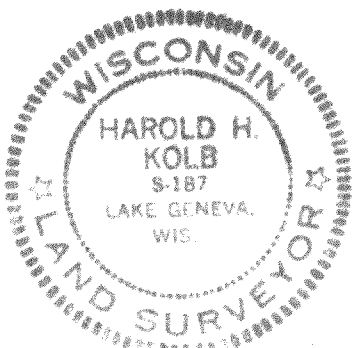

MO 6-1272, 1273

118-246