



PLAT OF SURVEY

J.K. SURVEYING, INC.
FORMERLY KOLB LAND CONSULTING
929 WILLIAMS STREET LAKE GENEVA, WI. 53147
(414) 248-3697

DATE OF LAST REVISION: 4 - 22-04
DATE: 10\15\1998

ORDERED BY: PHYLLIS SAAB
REMAX GENEVA , REALTY, LTD.
101 BROAD ST.
LAKE GENEVA, WI 53147

DESCRIPTION: LOTS 346-350, BLOCK 19 PELL LAKE
HIGHLANDS SUBDIVISON, A SUBDIVISON LOCATED IN
T1N, R18E, WALWORTH COUNTY, WISCONSIN

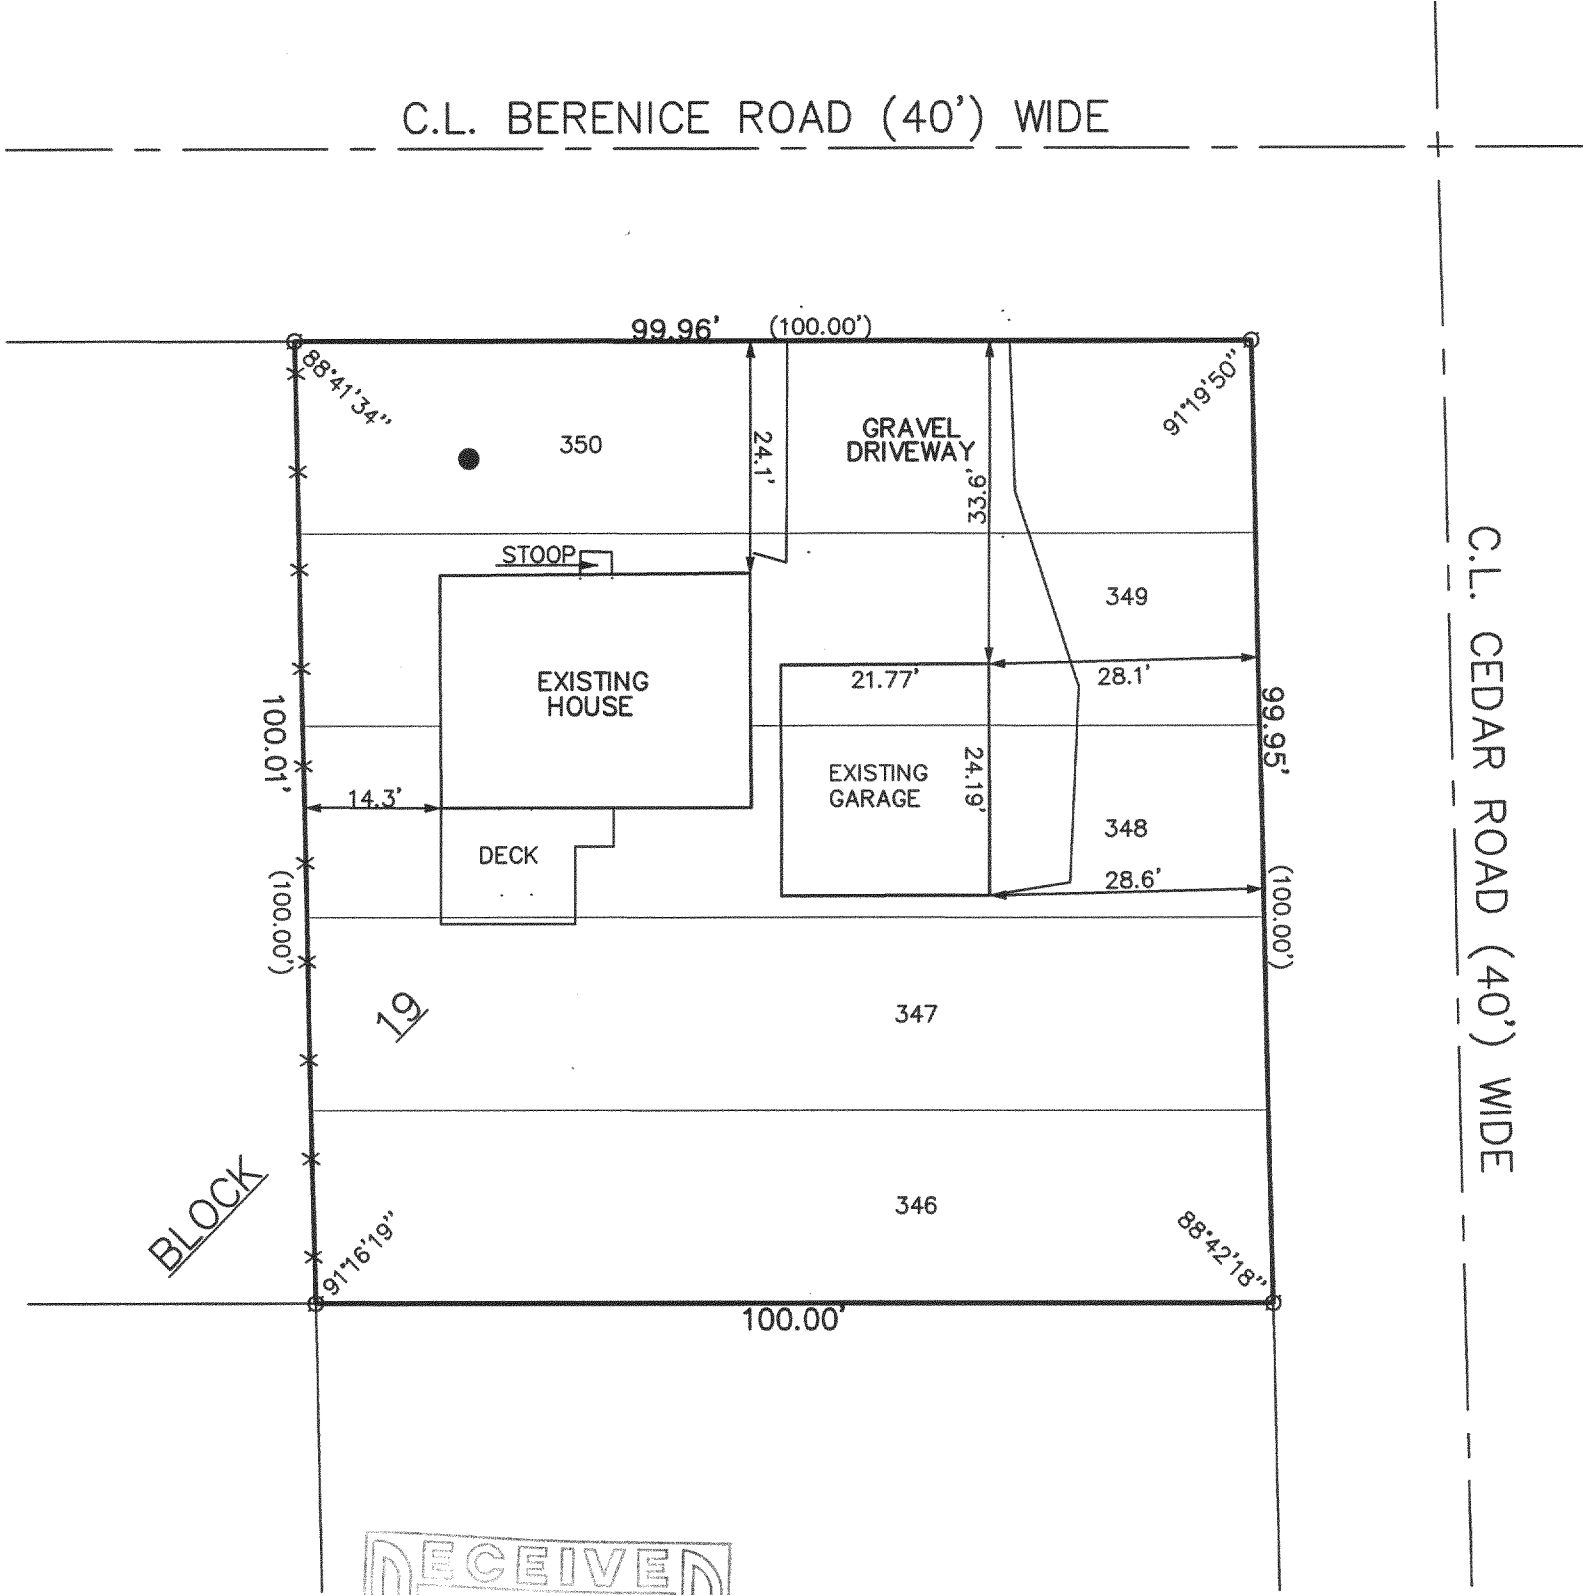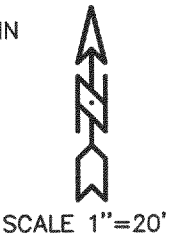

RECEIVED
AUG 13 2004
[Signature]

- LEGEND**
- FOUND IRON PIPE
 - x— FENCE
 - ⊙ VENT
 - WELL
 - (XXX) RECORDED AS

THE ABOVE MAP IS A TRUE REPRESENTATION THEREOF AND
SHOWS THE SIZE AND LOCATION OF ALL THE PROPERTY,
EXTERIOR BOUNDARIES, THE LOCATION OF ALL VISIBLE
BOUNDARY FENCES , APPARENT EASEMENTS , ROADWAYS
AND VISIBLE ENCROACHMENTS , IF ANY

THIS SURVEY IS MADE FOR THE USE OF THE PRESENT
OWNERS OF THE PROPERTY , AND ALSO THOSE WHO
PURCHASE , MORTGAGE OR GURANTEE TITLE THERETO
WITHIN ONE (1) YEAR FROM DATE HERETO.

[Signature]
JOHN P. KROTT , R.L.S. 2258



NOTE: THIS IS NOT A CERTIFIED COPY
UNLESS SEAL IS IN RED.
JOB NUMBER #98202 1-18-MPLH 00075

MPLH 00075

118-2467