


PLAT OF SURVEY
-OF-

LOTS 740 TO 744, BOTH INCLUSIVE, BLOCK 12, PELL LAKE ADDITION, TOWN OF
BLOOMFIELD, WALWORTH COUNTY, WISCONSIN.


SURVEY FOR: RE/MAX SOUTHERN LAKES
SURVEY LOCATION: N1398 DAISY DRIVE

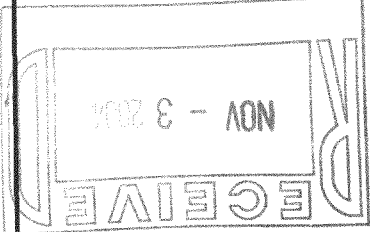

1" = 30'

SCALE:

(499.64' meas.)
500.00'

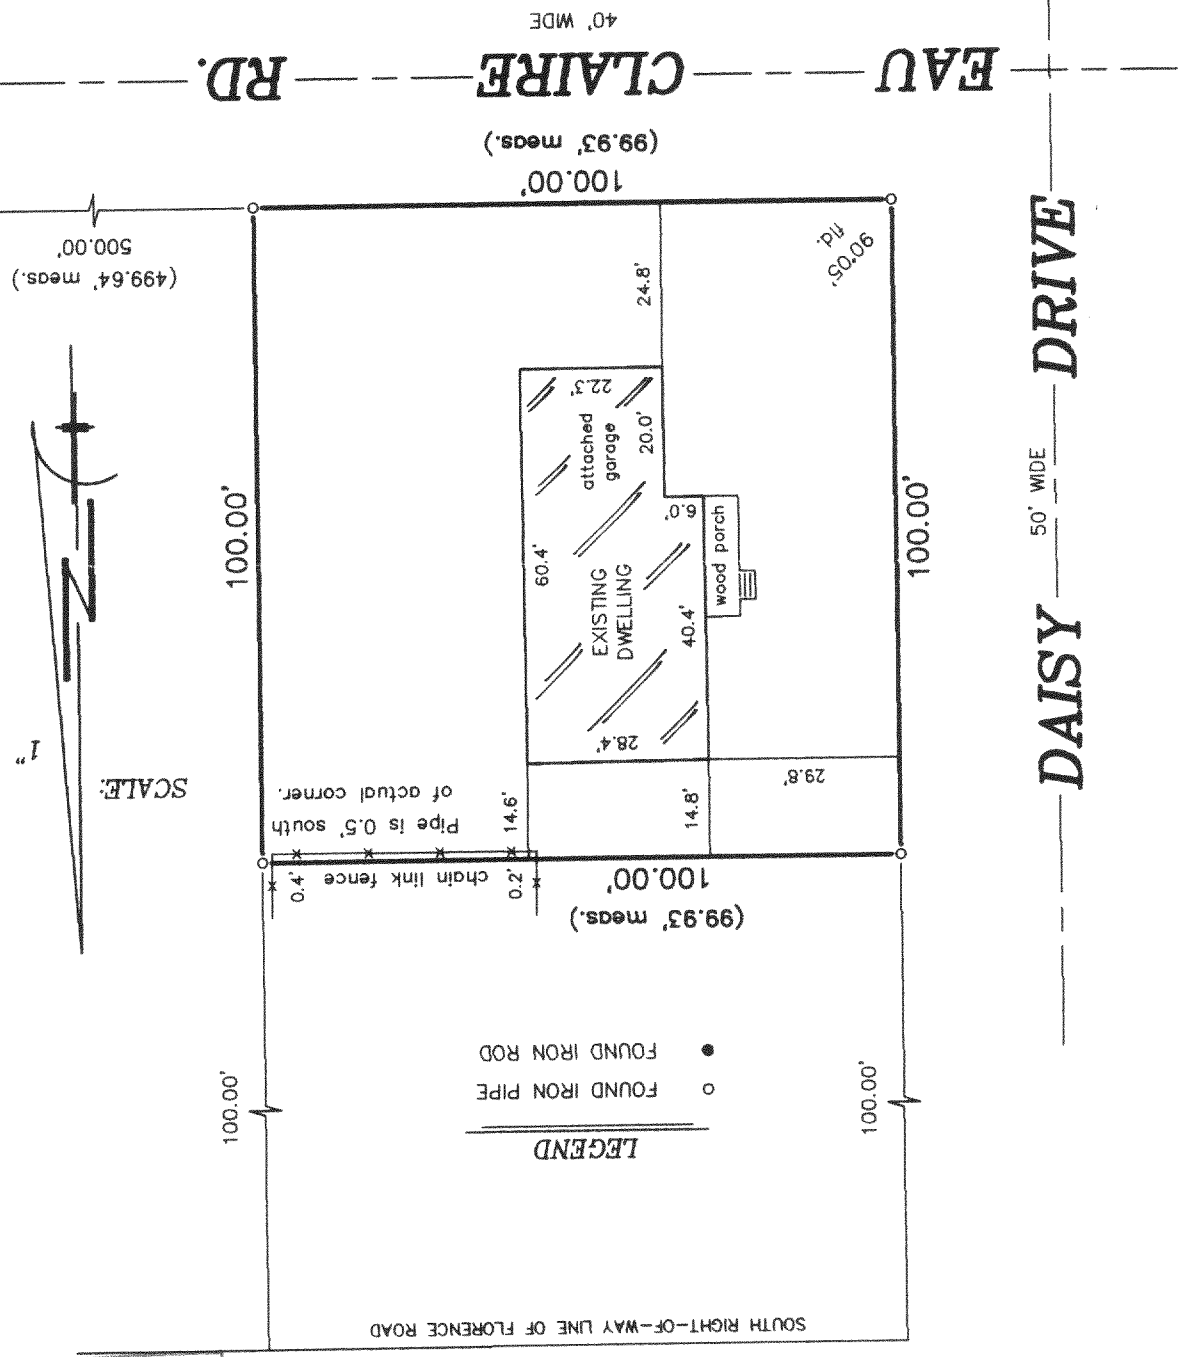

(99.93' meas.)

100.00'

EAU CLAIRE RD.

40' WDE

DAISY DRIVE
50' WIDE



THIS IS NOT AN ORIGINAL PRINT
UNLESS THIS SEAL IS RED.

Robert J. Wetzel
ROBERT J. WETZEL
S-1778

OCTOBER 7, 2004
DATE

6595
JOB NUMBER

412 N. PINE STREET
BURLINGTON, WI 53105
(262)-767-0225

B.W. SURVEYING, INC.



"I hereby certify that I have surveyed the above described property and that the above map is a correct representation thereof and shows the size and location of the property, its exterior boundaries, the location of all visible structures and dimensions of all principal buildings thereon, boundary fences, apparent easements, roadways and encroachments, if any.
"This survey is made for the use of the present owners of the property, and those who purchase, mortgage, or guarantee the title thereto within one year from date hereof."

118 - 2488

MPLA 00153