
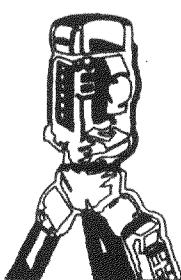


PLAT OF SURVEY
-OF-

LOTS 577-581, BLOCK 11, AS DESIGNATED AND DELINEATED ON THE MAP ENTITLED "MAP OF SECTION 'ONE' OF PELL LAKE, WALWORTH COUNTY, WISCONSIN," AND RECORDED IN THE OFFICE OF THE REGISTER OF DEEDS IN AND FOR THE COUNTY OF WALWORTH AND STATE OF WISCONSIN ON THE 16TH DAY OF JULY, 1924.

SURVEY FOR: WALLACE CONSTRUCTION

PROPOSED ADDRESS: SPRUCE DRIVE

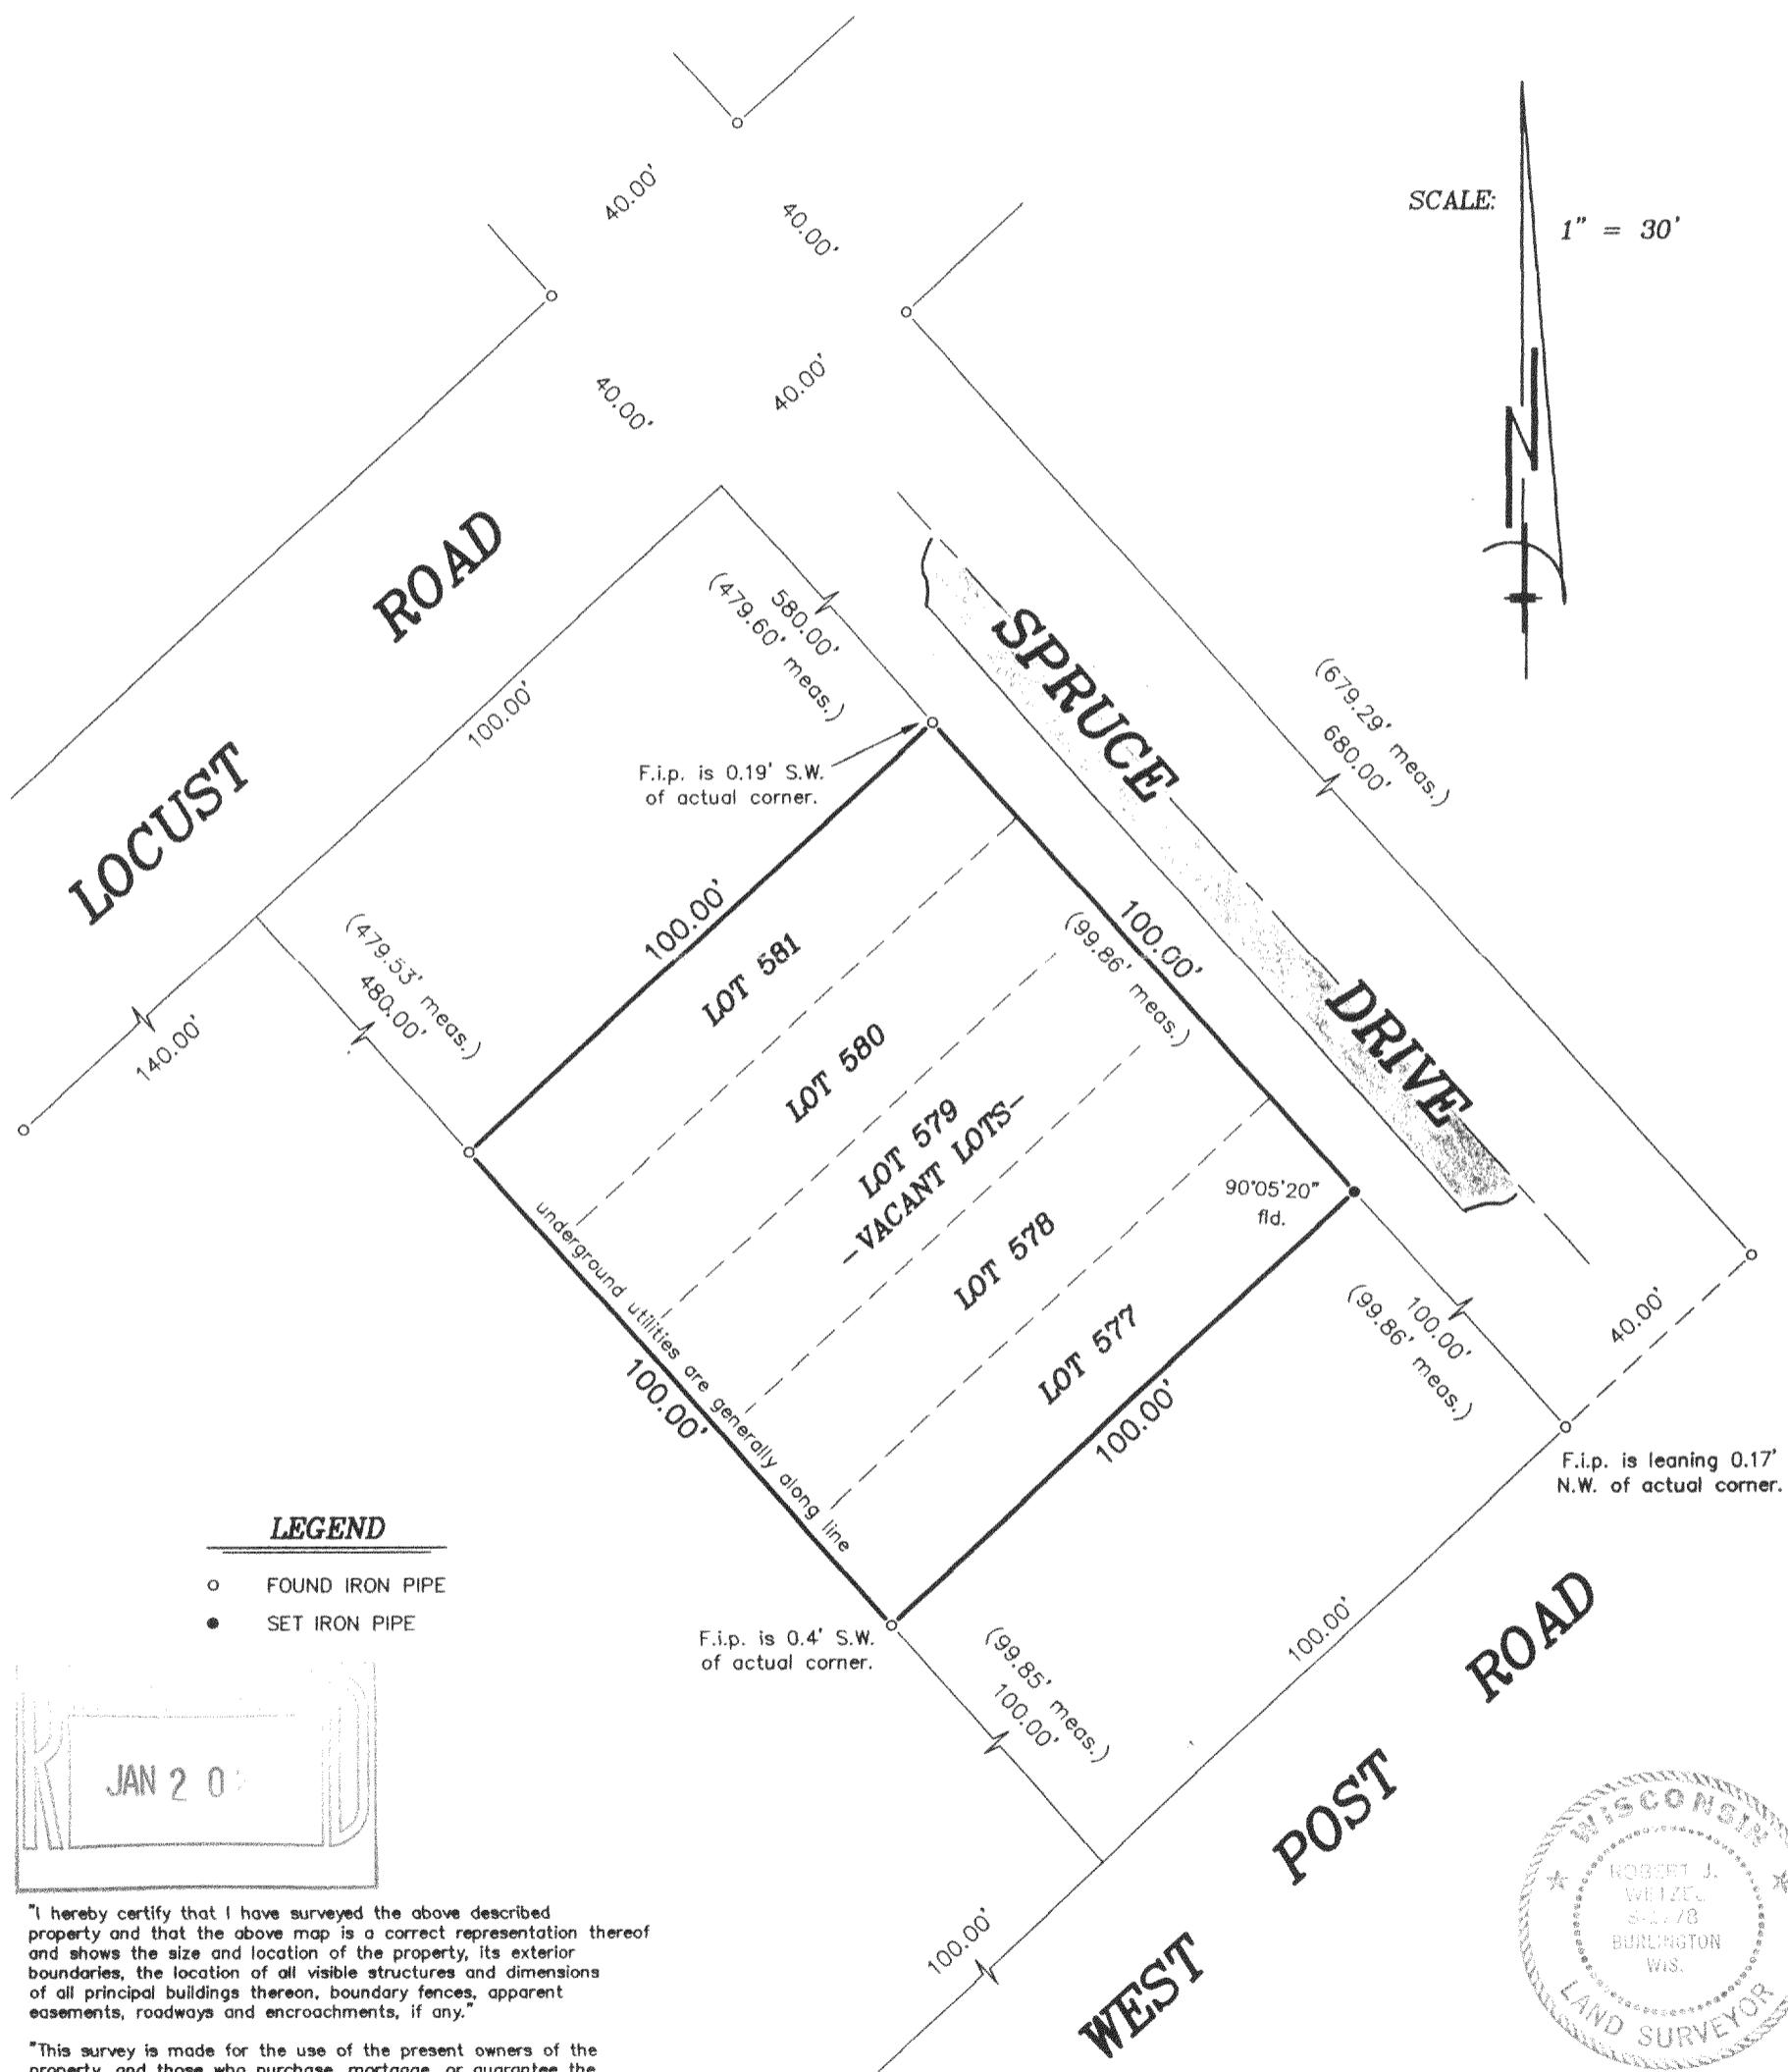

B.W. SURVEYING, INC.
LAND SURVEYS
MAPPING AND PLANNING
412 N. PINE STREET
BURLINGTON, WI 53105
(262)-767-0225

THIS IS NOT AN ORIGINAL PRINT
UNLESS THIS SEAL IS RED.



Robert J. Wetzel
ROBERT J. WETZEL S-1778
JANUARY 3, 2005
DATE
6694
JOB NUMBER

MPL-121A

118-2516