


ABELL
SURVEYING & MAPPING

1140 SEQUOIA STREET • DELAVAN, WISCONSIN 53115
262-728-6737

FLORENCE ROAD

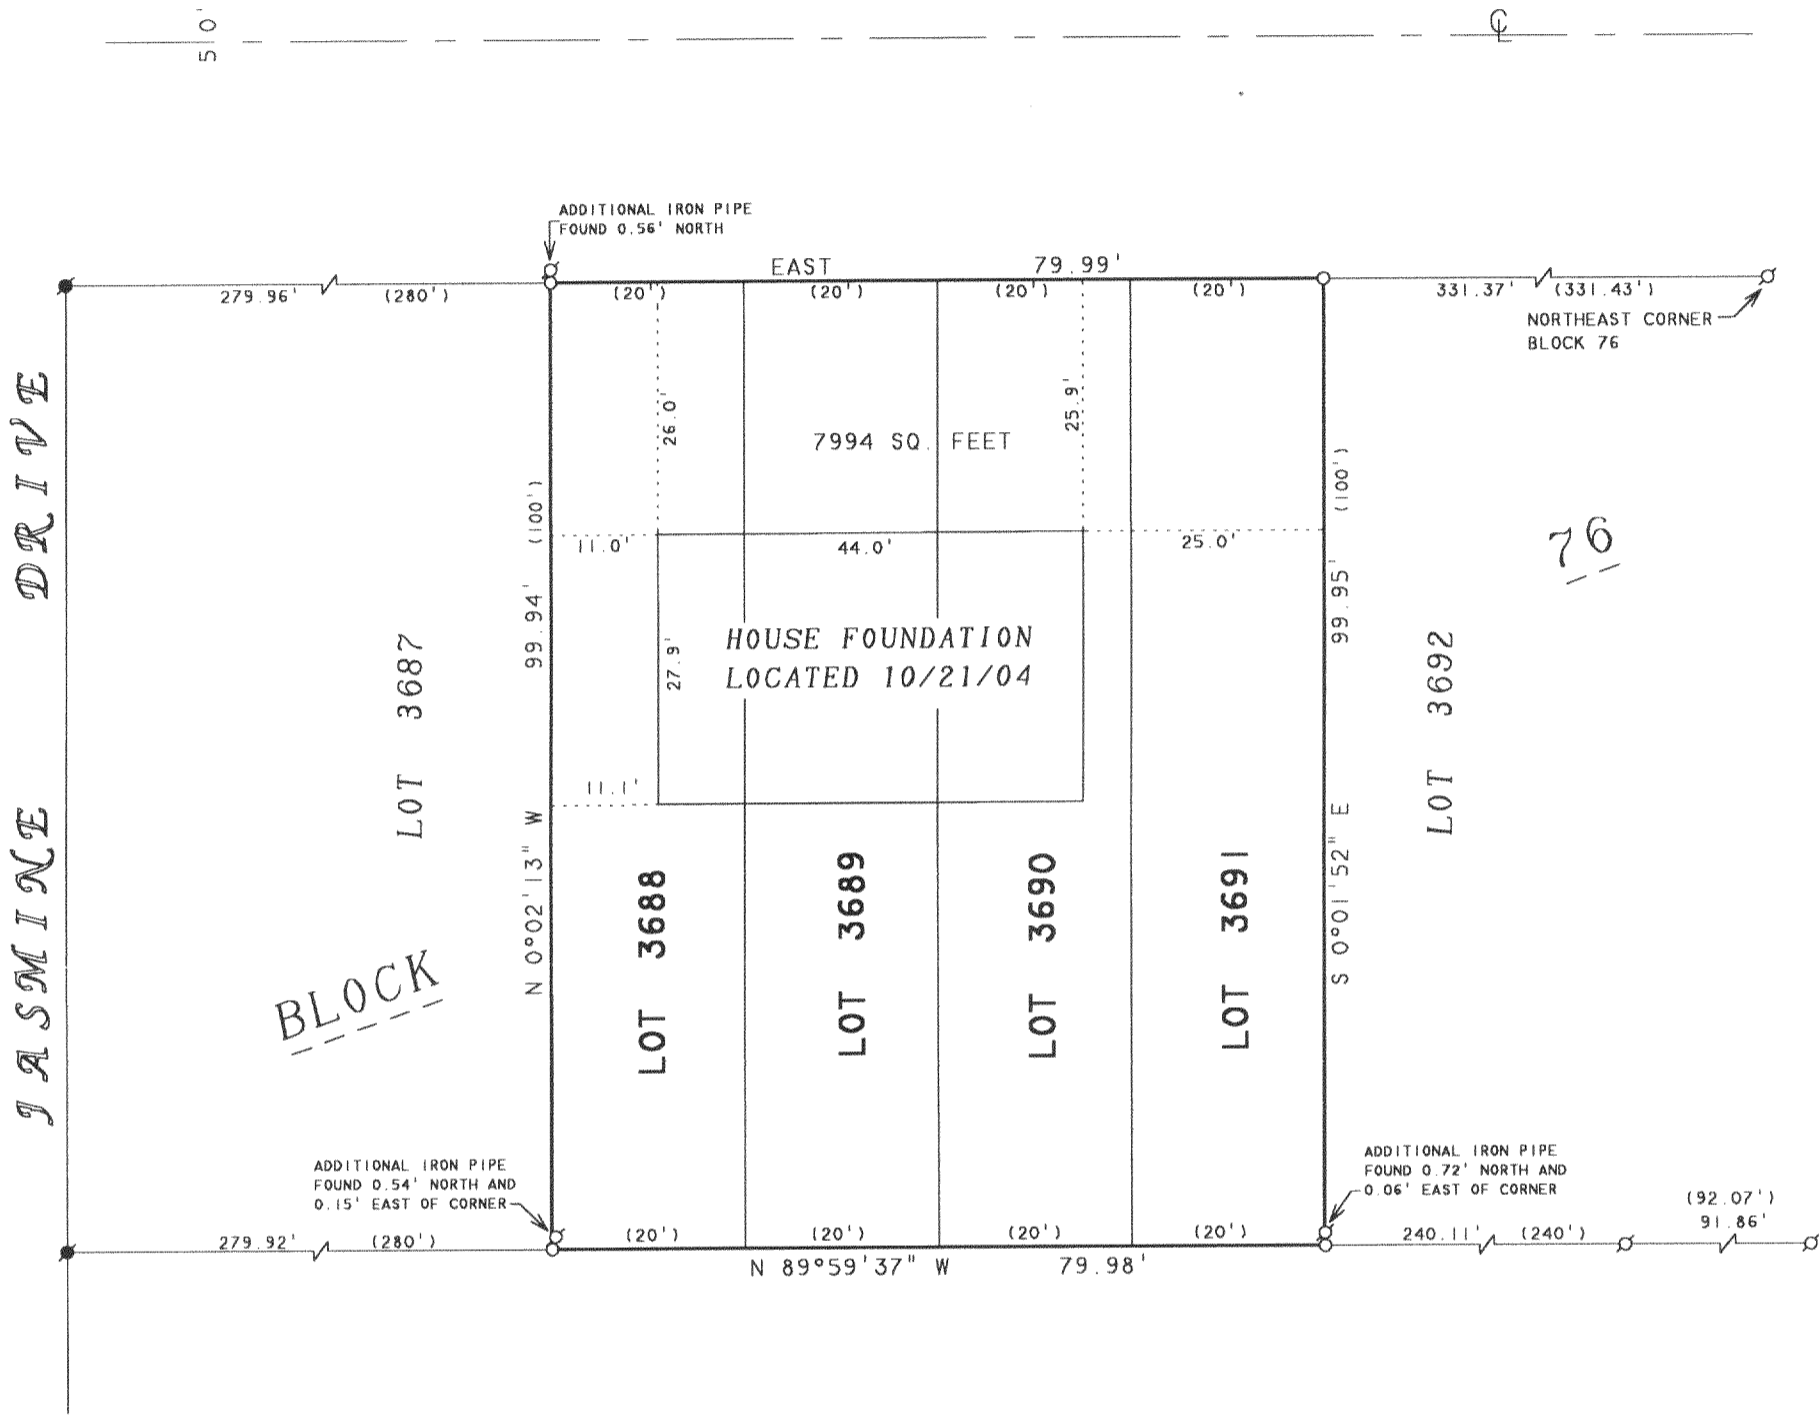

PLAT OF SURVEY OF

LOTS 3688-3691, BLOCK 76, PELL LAKE SUBDIVISION,
TIN. RIBE, WALWORTH COUNTY, WISCONSIN.

ORDERED BY: CENTURY 21 - PAGLIARINI GROUP
252 CENTER STREET
LAKE GENEVA, WI 53147

REVISED: SEPTEMBER 1, 2004 TO SHOW THE PROPOSED HOUSE.
REVISED: OCTOBER 21, 2004 TO SHOW HOUSE FOUNDATION.
ORDERED BY: CARYN LARSON
9422 MARTIN ROAD
SPRING GROVE, IL 60081

NOTE: BEARINGS ARE REFERENCED TO EXISTING SURVEY RECORDS.



SCALE 1" = 20'

LEGEND

- - IRON PIPE FOUND
- - IRON PIPE SET
- - IRON ROD FOUND
- () - RECORDED AS

I HEREBY CERTIFY THAT I HAVE SURVEYED THE ABOVE DESCRIBED PROPERTY AND THAT THE ABOVE MAP IS A TRUE REPRESENTATION THEREOF AND SHOWS THE SIZE AND LOCATION OF THE PROPERTY, ITS EXTERIOR BOUNDARIES, THE LOCATION OF ALL VISIBLE STRUCTURES AND DIMENSIONS OF ALL PRINCIPAL BUILDINGS THEREON, BOUNDARY FENCES, APPARENT EASEMENTS, ROADWAYS AND VISIBLE ENCROACHMENTS, IF ANY, TO THE BEST OF MY KNOWLEDGE AND BELIEF.

THIS SURVEY IS MADE FOR THE USE OF THE PRESENT OWNERS OF THE PROPERTY, AND ALSO THOSE WHO PURCHASE, MORTGAGE, OR GUARANTEE THE TITLE THERETO WITHIN ONE (1) YEAR FROM DATE HEREON.

David F. Abell

DAVID F. ABELL
WISCONSIN REGISTERED LAND SURVEYOR, S-1596

March 10, 2004

DATE JOB NUMBER - 04018B
NOTE: THIS IS NOT A CERTIFIED COPY UNLESS SEALED.

MPL-771

118-2542