

PREPARED FOR:

PLAT OF SURVEY

J.K. SURVEYING INC.
N3705 WILLOWBEND LANE
LAKE GENEVA, WI, 53147
262-248-3697


OF

LOTS 3406-3408 BLOCK 72 PELL LAKE SUBDIVISION,
A SUBDIVISION LOCATED IN, TOWN 1 NORTH,
RANGE 18 EAST, TOWN OF BLOOMFIELD, WALWORTH
COUNTY, WISCONSIN

FEB 18 2005

(40' WIDE)

MYRTLE ROAD

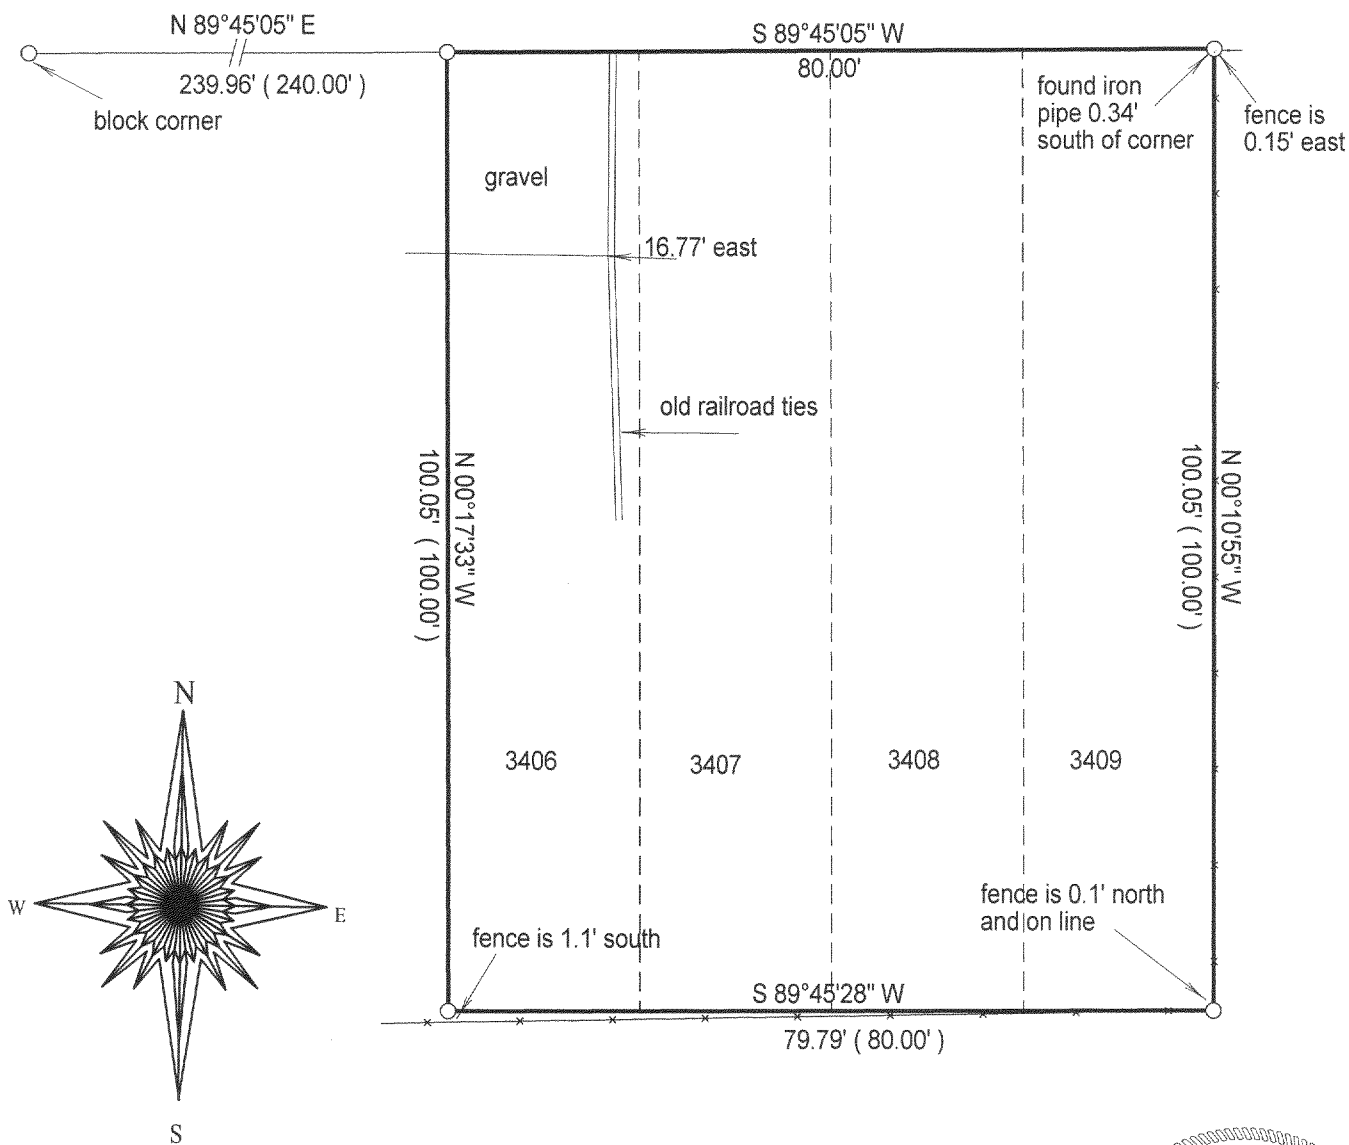

- () = recorded as
- = set iron bar
- = found iron bar
- = found iron pipe
- = set iron pipe


SCALE: 1" = 20'

JOB #: 04-463

TAX KEY #:
MPL00708

COMPARE LEGAL DESCRIPTION ABOVE AND DRAWING WITH DEED. FOR BUILDING RESTRICTIONS AND EASEMENTS NOT SHOWN, REFER TO DEED, ABSTRACT SOURCES AND LOCAL MUNICIPAL CODES. NOTIFY THE SURVEYOR IMMEDIATELY OF ANY DISCREPANCY.

"I hereby certify that I have surveyed the above described property and that the above map, to the best of my knowledge and belief, is a true representation thereof and shows the size and location of all visible structures, apparent easements and encroachments if any." This survey is made for the present owners of the property, and those who purchase, mortgage, or guarantee the title thereto, within one year from the date hereof.

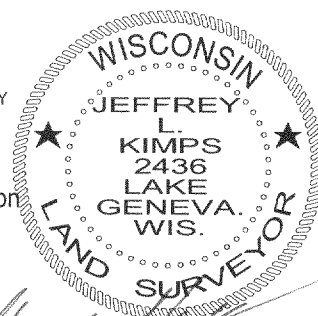

JEFFREY L. KIMPS S-2436
Wisconsin Registered Land Surveyor
(original if signed in red)

DATED THIS 20 TH DAY OF SEPT. 2004.

118-2572