

LAND-MARK SURVEYING

Mark L. Miritz

Wisconsin Registered Land Surveyor S-2582

N9330 Knuteson Drive

Whitewater, WI 53190

Phone: (262) 495-3284

FAX: (262) 495-8421

LAND-MARKSURVEYING.COM

ORDERED BY:

SCHAUDER BUILDING, INC.

4115 U.S. HIGHWAY 51 NORTH

JANESVILLE, WI 53545-9674

OWNERS: ROBERT & FRANCES HANEMAN

PLAT OF SURVEY



LOT 6, HEARTLAND SUBDIVISION, LOCATED IN
THE NW 1/4 OF THE NE 1/4 OF SECTION 16,
TOWN 1 NORTH, RANGE 18 EAST, BLOOMFIELD
TOWNSHIP, WALWORTH COUNTY, WISCONSIN.

LOT 7

LOT 6

5.017 ACRES

LOT 5

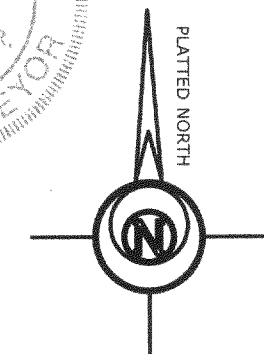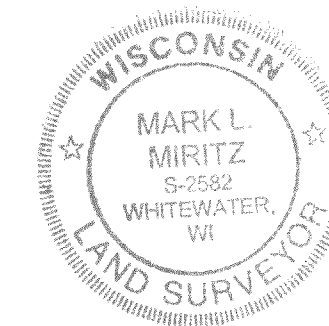

LEGEND

- FOUND IRON PIPE
- FOUND IRON ROD
- FOUND COUNTY MONUMENT
- FOUND CONCRETE MONUMENT
- CHISEL CUT IN CONCRETE
- SET IRON ROD, 24" LONG, WEIGHING 1.5 LBS./LINEAL FT., 3/4" DIA.
- (x x) RECORDED AS DIMENSION
- EXISTING FENCE



SCALE: 1" = 60 FEET

"I hereby certify that the above described property has been surveyed by me or under my direction and that the above map is a true representation thereof and shows the size and location of the property, its exterior boundaries, the location of all visible structures and dimensions of all principal buildings thereon, boundary fences, apparent easements, roadways and visible encroachments, if any."
"This survey is made for the use of the present owners of the property, and also those who purchase, mortgage, or guarantee the title thereto within one year from date hereof."

MARK L. MIRITZ
WISCONSIN REGISTERED
LAND SURVEYOR S-2582

DATE: DEC. 12, 2004 JOB NO. 04.1206

REVISED FEB. 19, 2005 TO FOUNDATION 'AS BUILT'

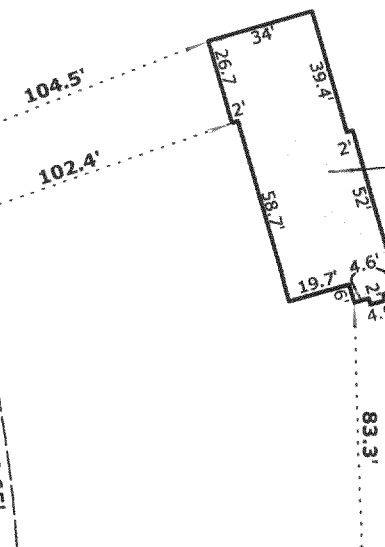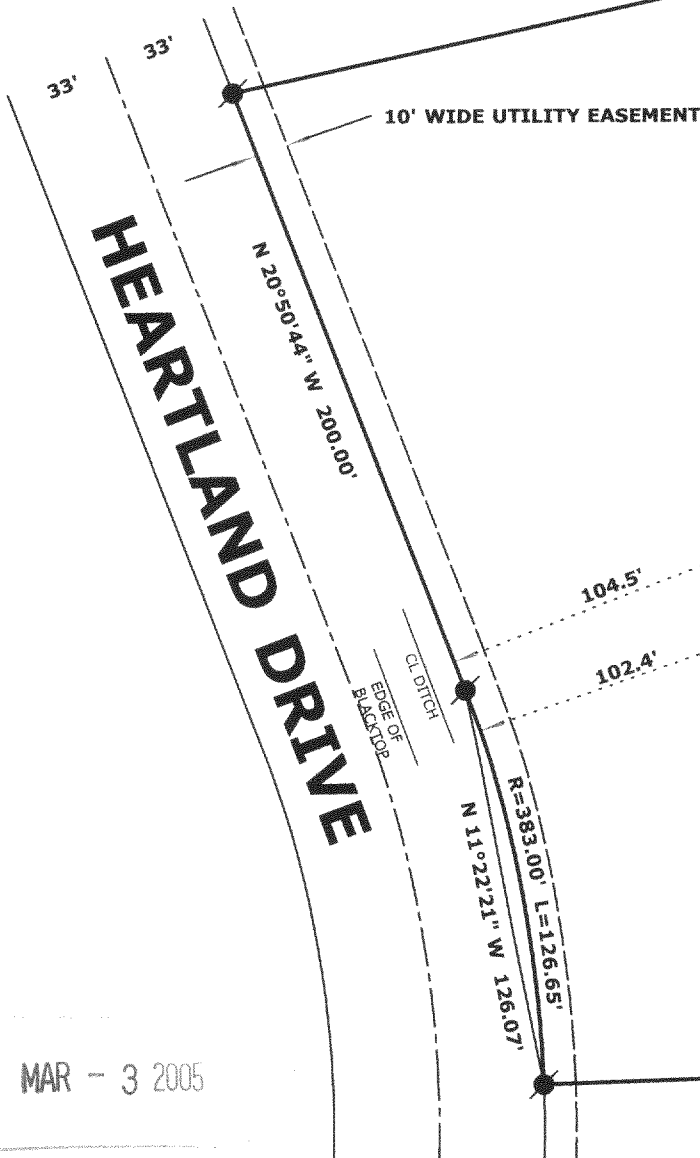

N 78°04'10" E 644.73'

S 01°46'50" E 425.82'

S 88°06'00" W 548.31'

HEARTLAND DRIVE

10' WIDE UTILITY EASEMENT

EXISTING FOUNDATION

MAR - 3 2005