


Elevations shown hereon, refer to Wisconsin State Plane Coordinate System, south zone, vertical control datum.

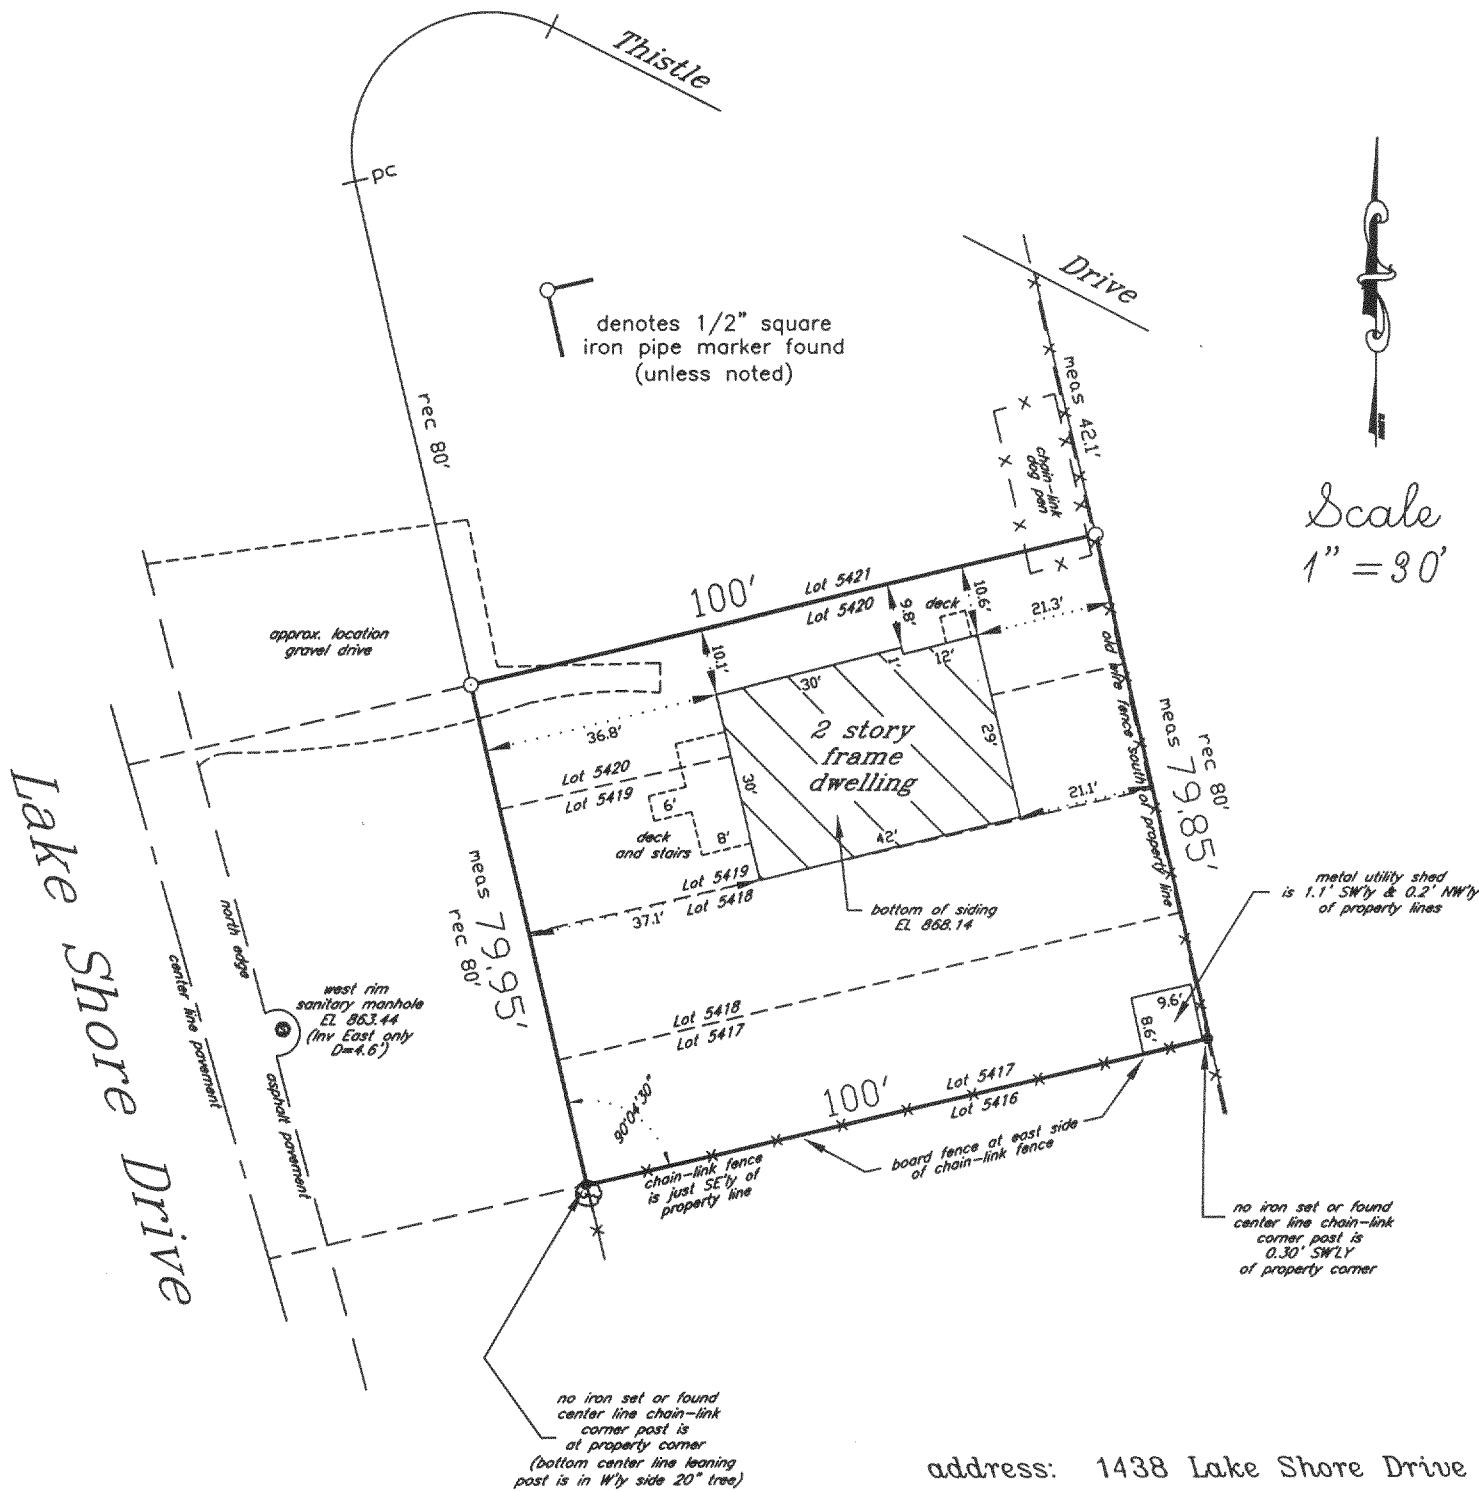

Refer to a current title report for a complete legal description and for easements or restrictions which may affect this site; specifically those not shown on the recorded subdivision plat.

MARESCALCO COUNTYWIDE SURVEYING, INC.
1120 80TH STREET KENOSHA, WI 53143
(262) 654 6809 FAX (262) 654 1120

I hereby certify that
this property was
surveyed under my
direction. This
plat is a true re-
presentation thereof.

Reg. Land Surveyor

October 14, 2003 Revised 10/30/03
Revised 4/22/04 foundation for
new 2 story frame dwelling

TOWN OF BLOOMFIELD
WALWORTH COUNTY, WIS.

PELL LAKE SUBDIVISION

-for-
Frank Tenuta

18-2597