


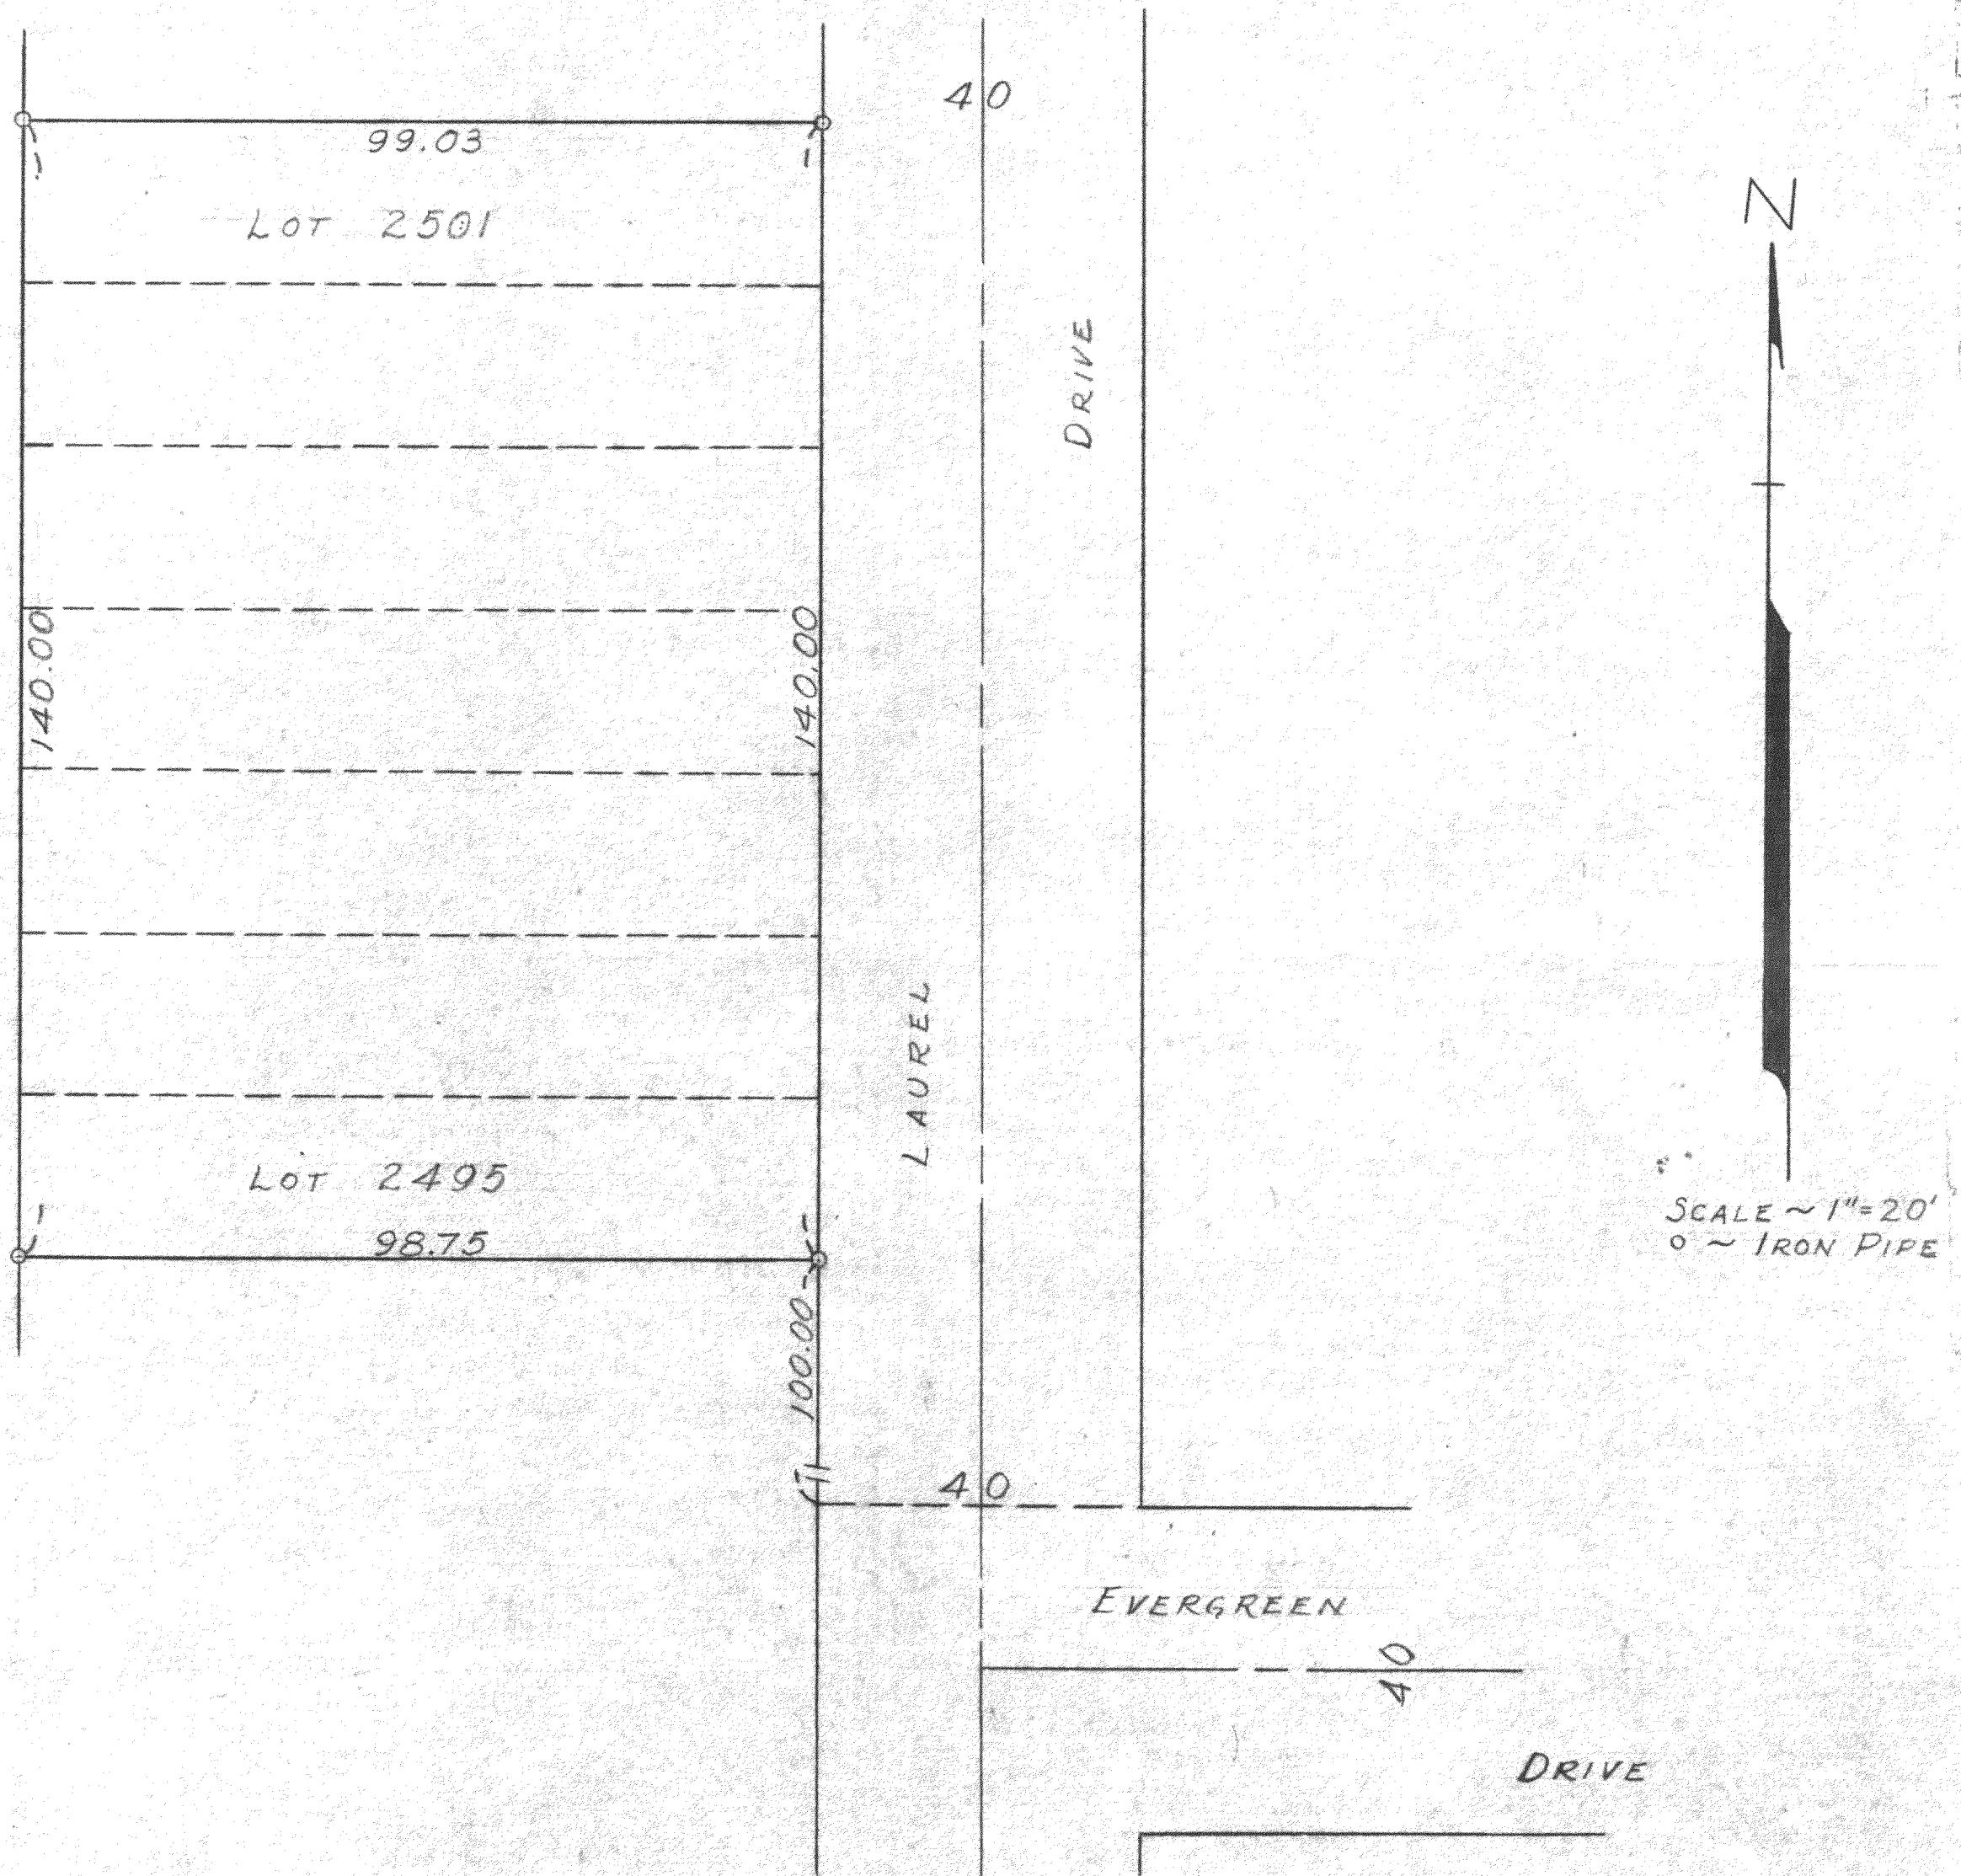

PLAT OF SURVEY OF LOTS 2495 THRU 2501 INCLUSIVE OF SECTION 2 OF
 PELL LAKE SUBDIVISION, T1N R1E, WALWORTH COUNTY, WISCONSIN
 NOV. 27, 1956

George T. Dunham
 GEORGE T. DUNHAM, SURVEYOR
 DELAVAN, WISCONSIN

118-26