


PREPARED FOR:
PHYLLIS SAAB
REMAX GENEVA
101 BROAD ST
LAKE GENEVA 53147

PLAT OF SURVEY

-OF-

PATHFINDER SURVEYING INC.
(formerly)
J.K. SURVEYING INC.
N3705 WILLOWBEND LANE
LAKE GENEVA, WI, 53147
262-248-3697

LOTS 1166-1170, BLOCK 19 OF PELL LAKE ADDITION, A SUBDIVISION
LOCATED IN THE WEST 1/2 OF THE SOUTHEAST 1/4 OF SECTION 14
AND IN THE NORTH 1/2 OF THE NORTHWEST 1/4 OF SECTION 23,
TOWN 1 NORTH, RANGE 18 EAST, TOWN OF BLOOMFIELD, COUNTY OF
WALWORTH AND STATE OF WISCONSIN.

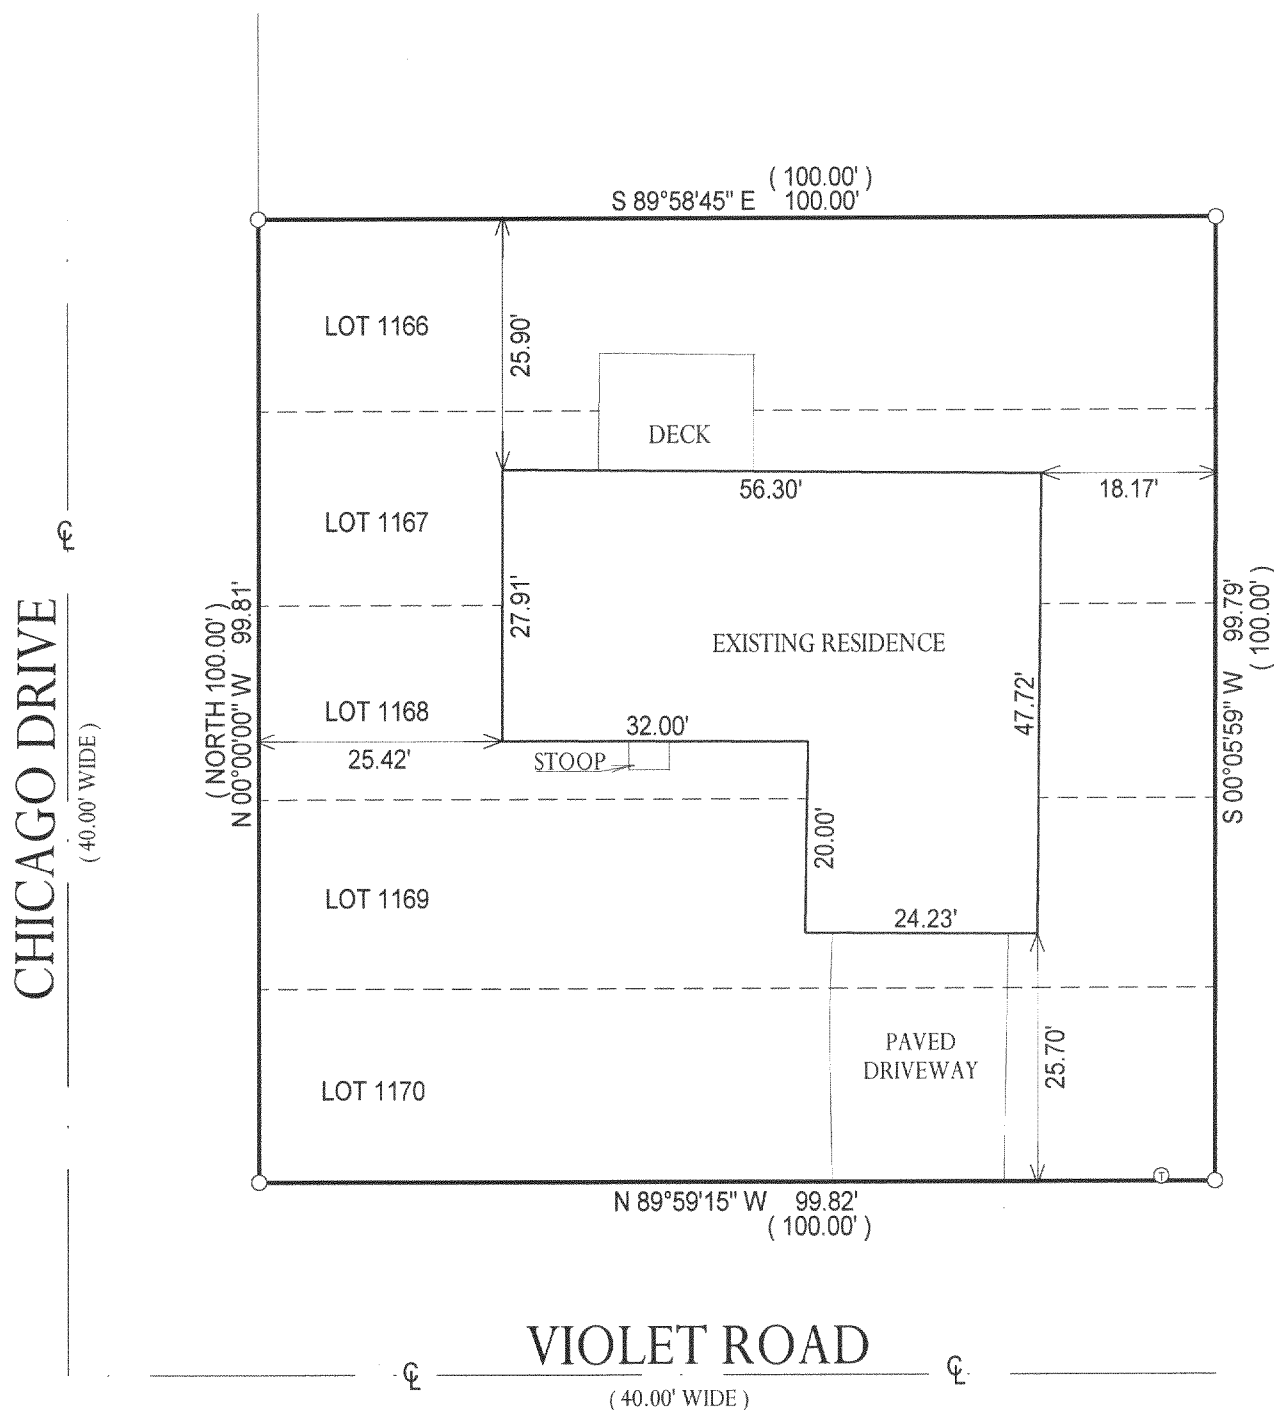


NOTE: BASIS OF BEARING IS CHICAGO DRIVE ASSUMED NORTH-SOUTH

DATED THE 8th, DAY OF JUNE 2005.

COMPARE LEGAL DESCRIPTION ABOVE AND DRAWING WITH DEED. FOR BUILDING RESTRICTIONS AND EASEMENTS NOT SHOWN, REFER TO DEED, ABSTRACT SOURCES AND LOCAL MUNICIPAL CODES. NOTIFY THE SURVEYOR IMMEDIATELY OF ANY DISCREPANCY.

"I hereby certify that the above described property was surveyed under my supervision and that the above map, to the best of my knowledge and belief, is a true representation thereof and shows the size and location of all visible structures, apparent easements and encroachments if any."
This survey is made for the present owners of the property, and those who purchase, mortgage, or guarantee the title thereto, within one year from the date hereof.

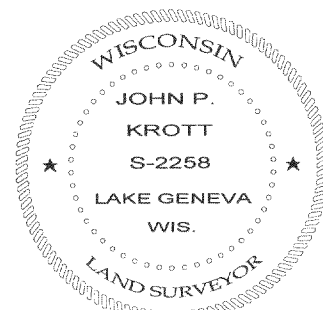

John P. Krott
JOHN KROTT S - 2258
Wisconsin Registered Land Surveyor
(original if signed in red)

118-2623