


PREPARED FOR : GEORGE WENZEL
6319 S. PALMAN
CHICAGO IL. 60629

PLAT OF SURVEY


- OF -

LOT 12 OF ZUHDE SUBDIVISION, LOCATED IN SECTION 13,
TOWN 1 NORTH, RANGE 18 EAST, WALWORTH COUNTY, WISCONSIN.

PATHFINDER SURVEYING INC.
N3705 WILLOW BEND LANE
LAKE GENEVA WI. 53147

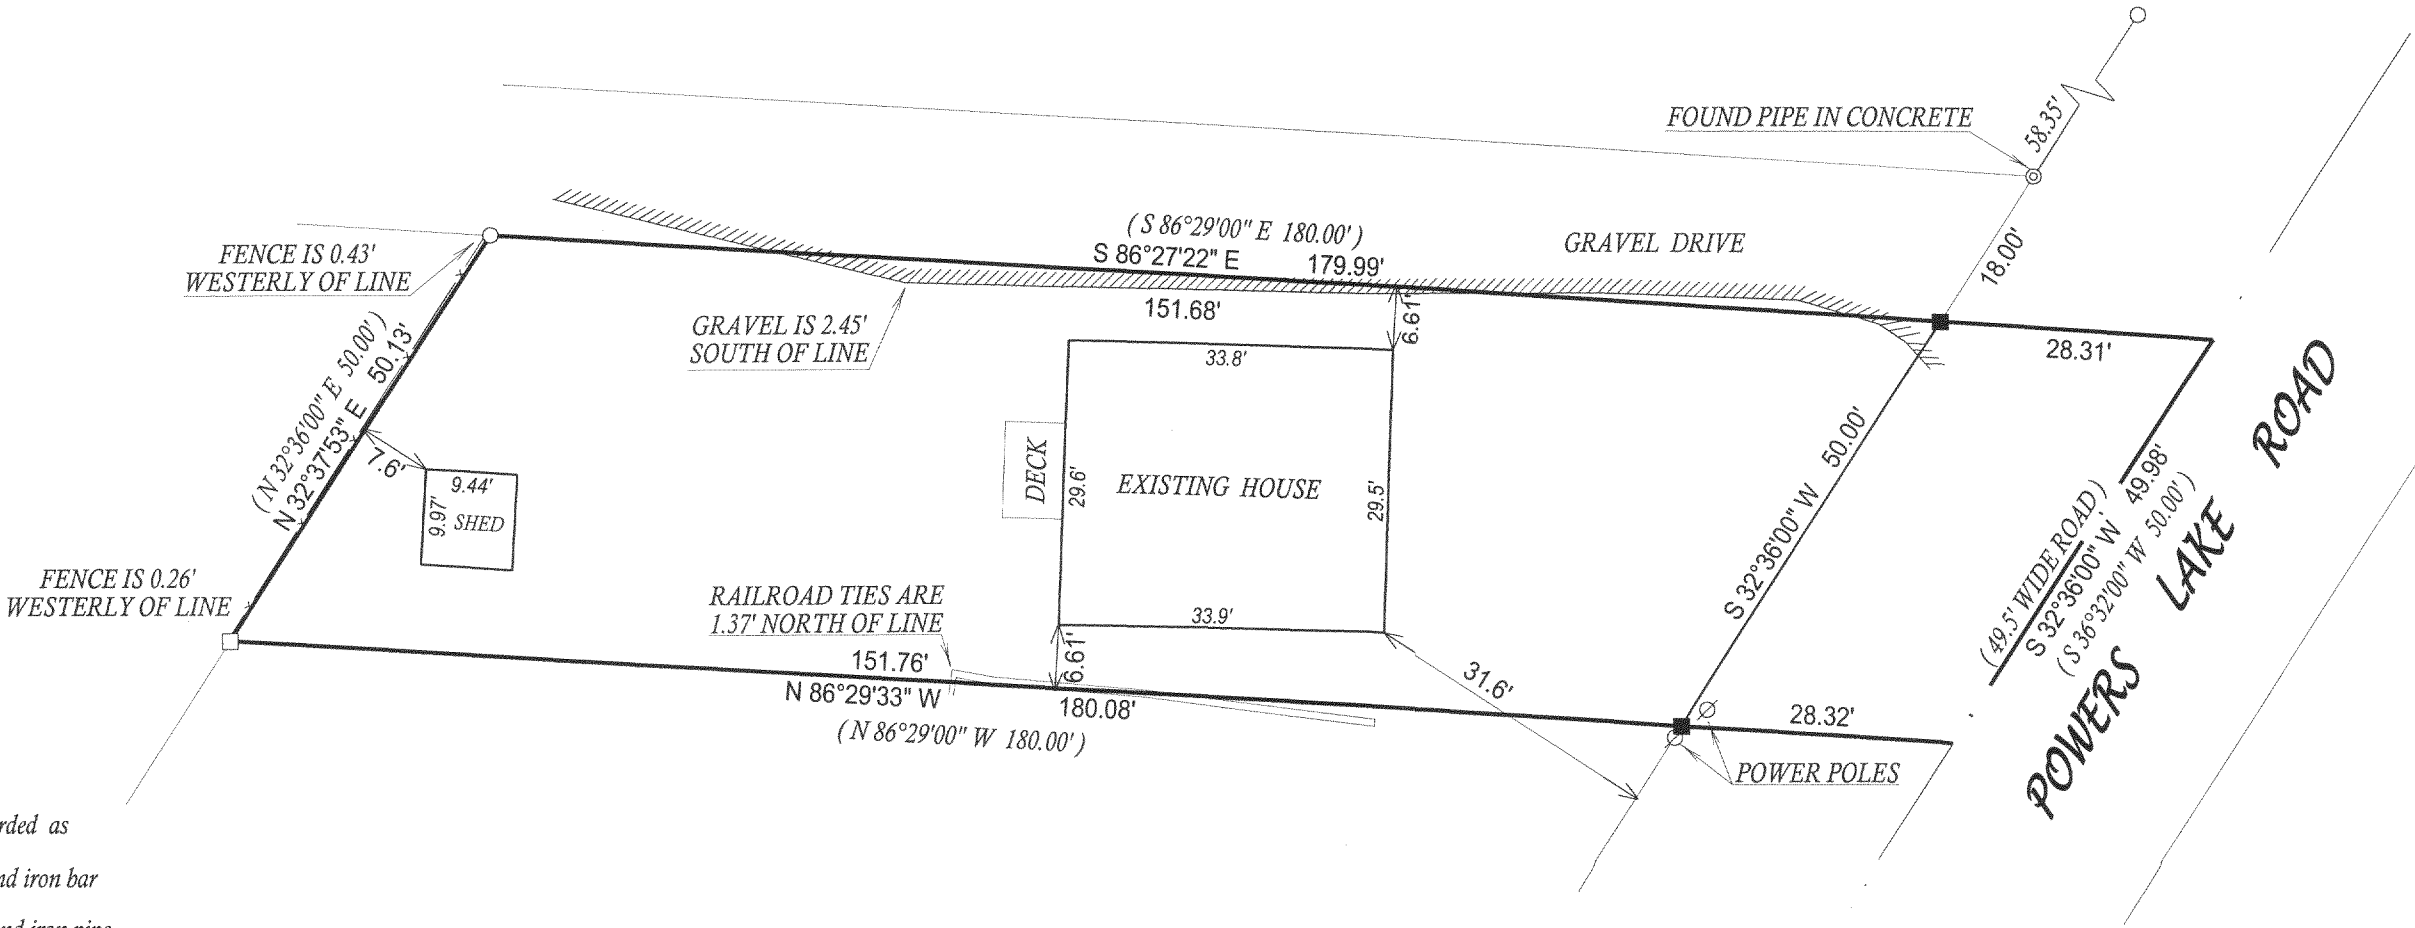

- () = recorded as
- = found iron bar
- = found iron pipe
- = set iron pipe
- = set iron bar

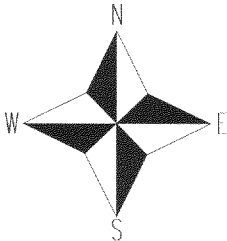



SCALE 1" = 20'

JOB # 05-504

TAX ID # MZ00013

COMPARE LEGAL DESCRIPTION ABOVE AND DRAWING WITH DEED. FOR BUILDING RESTRICTIONS AND EASEMENTS NOT SHOWN, REFER TO DEED, ABSTRACT SOURCES AND LOCAL MUNICIPAL CODES. NOTIFY THE SURVEYOR IMMEDIATELY OF ANY DISCREPANCY.

"I hereby certify that I have surveyed the above described property and that the above map, to the best of my knowledge and belief, is a true representation thereof and shows the size and location of all visible structures, apparent easements and encroachments if any."
This survey is made for the present owners of the property, and those who purchase, mortgage, or guarantee the title thereto, within one year from the date hereof.

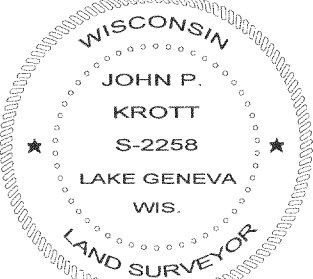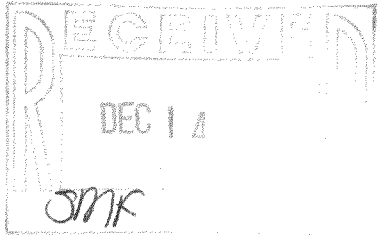

JOHN KROTT S - 2258
Wisconsin Registered Land Surveyor
(original if signed in red)

DATED THIS THE 22nd DAY OF SEPTEMBER 2005.

MZ-13

118-2663