


PREPARED FOR :
BD CARPENTER CONTRACTORS INC.
C/O BILL DAVIS
7934 N VRANVILLE RD.
MILWAUKEE 53224

PLAT OF SURVEY

- OF -


J.K. SURVEYING INC.
N3705 WILLOWBEND LANE
LAKE GENEVA, WI, 53147
262-248-3697

LOTS 3442 THOUGH 3447, BLOCK 73, OF PELL LAKE SUBDIVISION,
LOCATED IN T.1.N., R.18.E., TOWN OF BLOOMFIELD, WALWORTH
COUNTY, WISCONSIN.

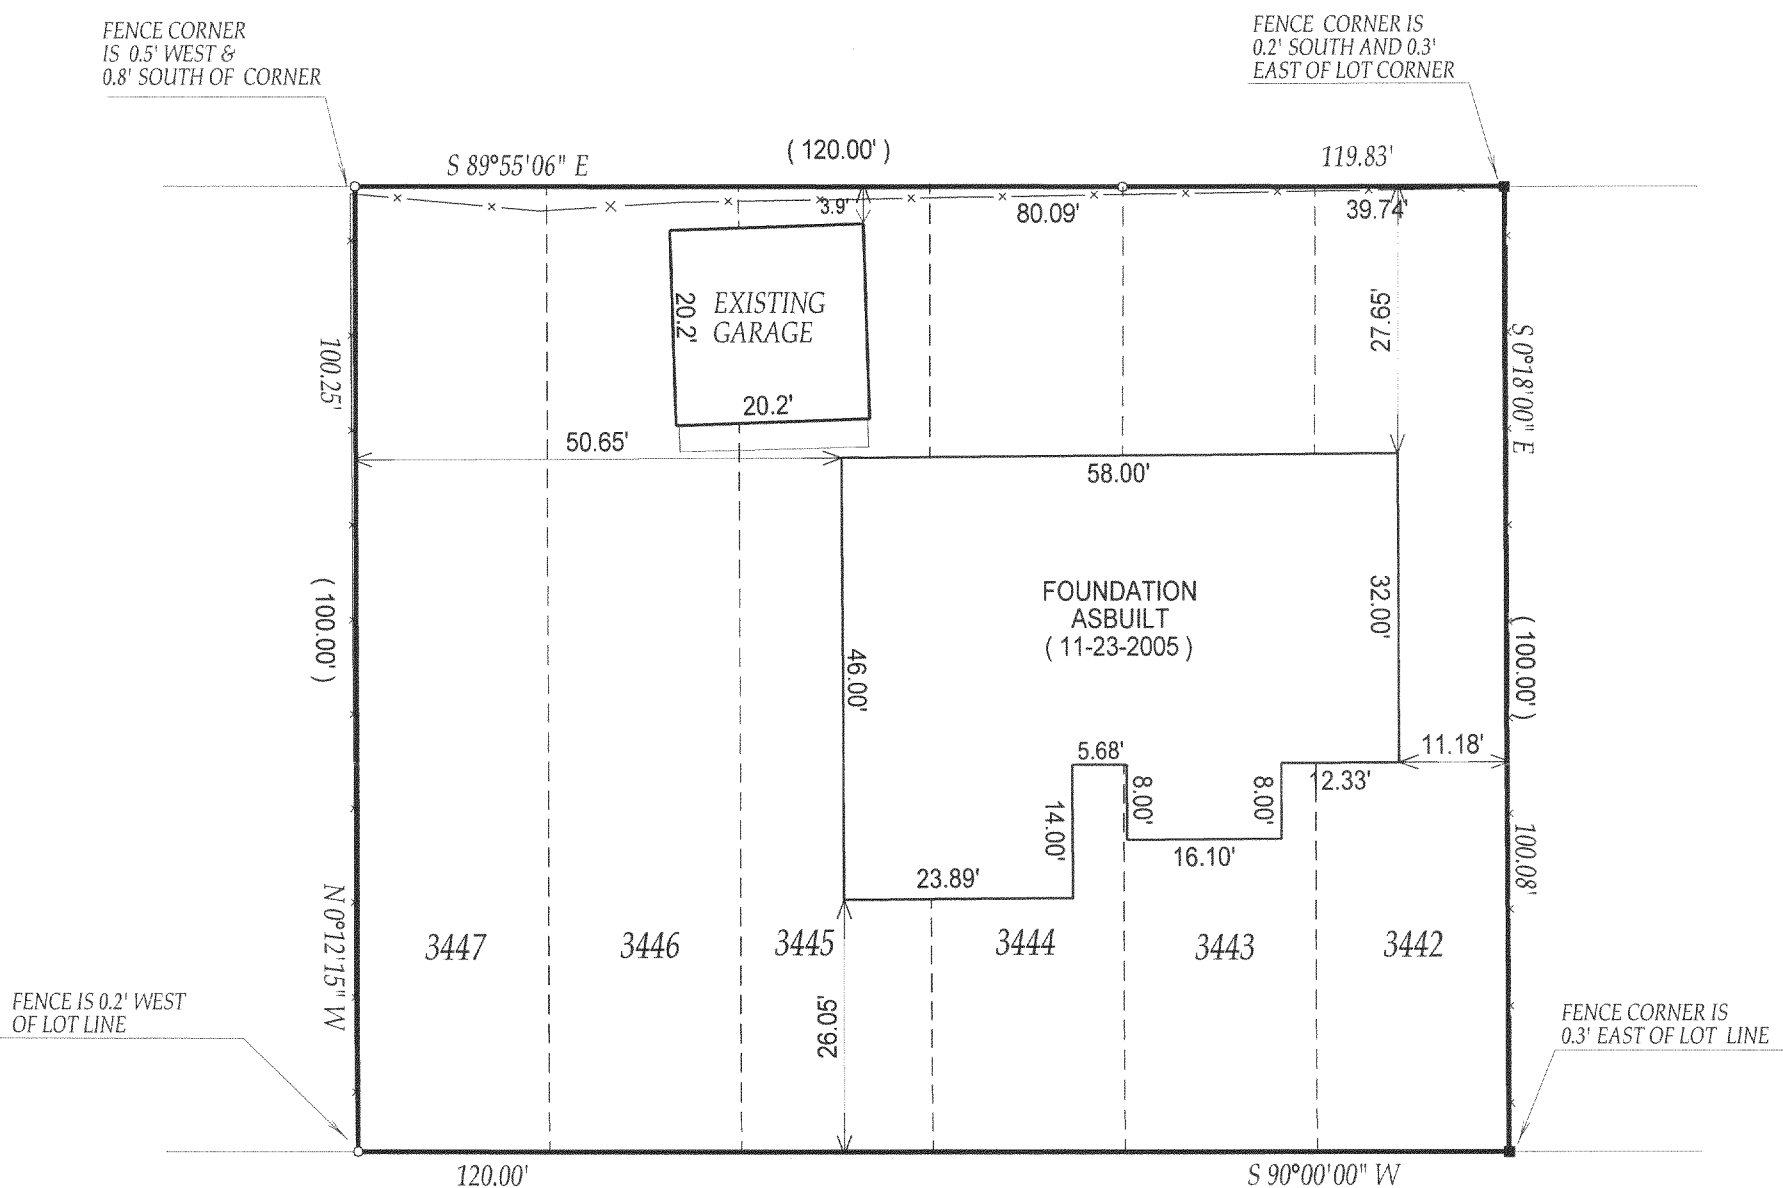

C.L. MYRTLE ROAD

N (40' WIDE)

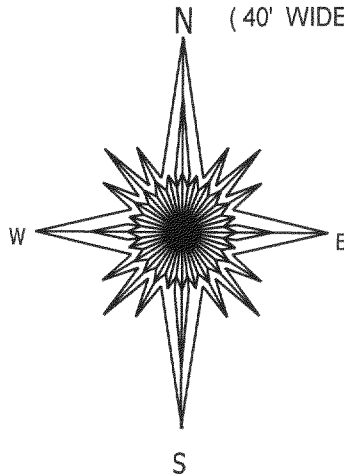

() = recorded as

□ = found iron bar

○ = found iron pipe

● = set iron pipe

■ = set iron bar

SCALE 1" = 20'

JOB # 05-071AB


TAX ID # MPL00718

COMPARE LEGAL DESCRIPTION ABOVE AND DRAWING WITH DEED. FOR BUILDING RESTRICTIONS AND EASEMENTS NOT SHOWN REFER TO DEED, ABSTRACT SOURCES AND LOCAL MUNICIPAL CODES. NOTIFY THE SURVEYOR IMMEDIATELY OF ANY DISCREPANCY.

"I hereby certify that I have surveyed the above described property and that the above map is a true representation thereof and shows the size and location of all visible structures, apparent easements and encroachments if any."

This survey is made for the present owners of the property, and those who purchase, mortgage, or guarantee the title thereto, within one year from the date hereof.

REVISED 11-23-2005 (ASBUILT)
REVISED 06-09-05
DATED THIS 24th, DAY OF FEBRUARY, 2005

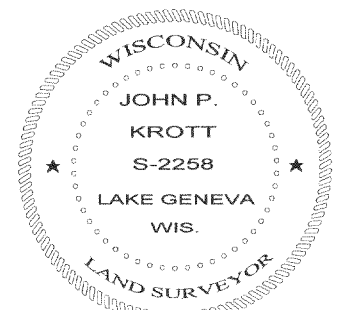

JOHN KROTT S - 2258
Wisconsin Registered Land Surveyor
(original if signed in red)

MPL - 718

118-2666