



PREPARED FOR: RE/MAX GENEVA REALTY, LTD
C/O SCOTT JOHNSON
101 BROAD ST. SUITE 102
LAKE GENEVA WI. 53147

PLAT OF SURVEY

PATHFINDER SURVEYING INC.
N3705 WILLOW BEND LANE
LAKE GENEVA WI. 53147

- OF -

LOTS 7976-7979 EXCEPTING THE NORTHERLY 100' OF LOTS 7976 AND 7977.
ALSO THE NORTHERLY 100 FEET OF LOT 7980, AND LOTS 7981-7985 IN
BLOCK 154, PELL LAKE SUBDIVISION, LOCATED IN TOWN 1 NORTH, RANGE
18 EAST, WALWORTH COUNTY, WISCONSIN.

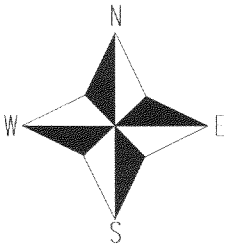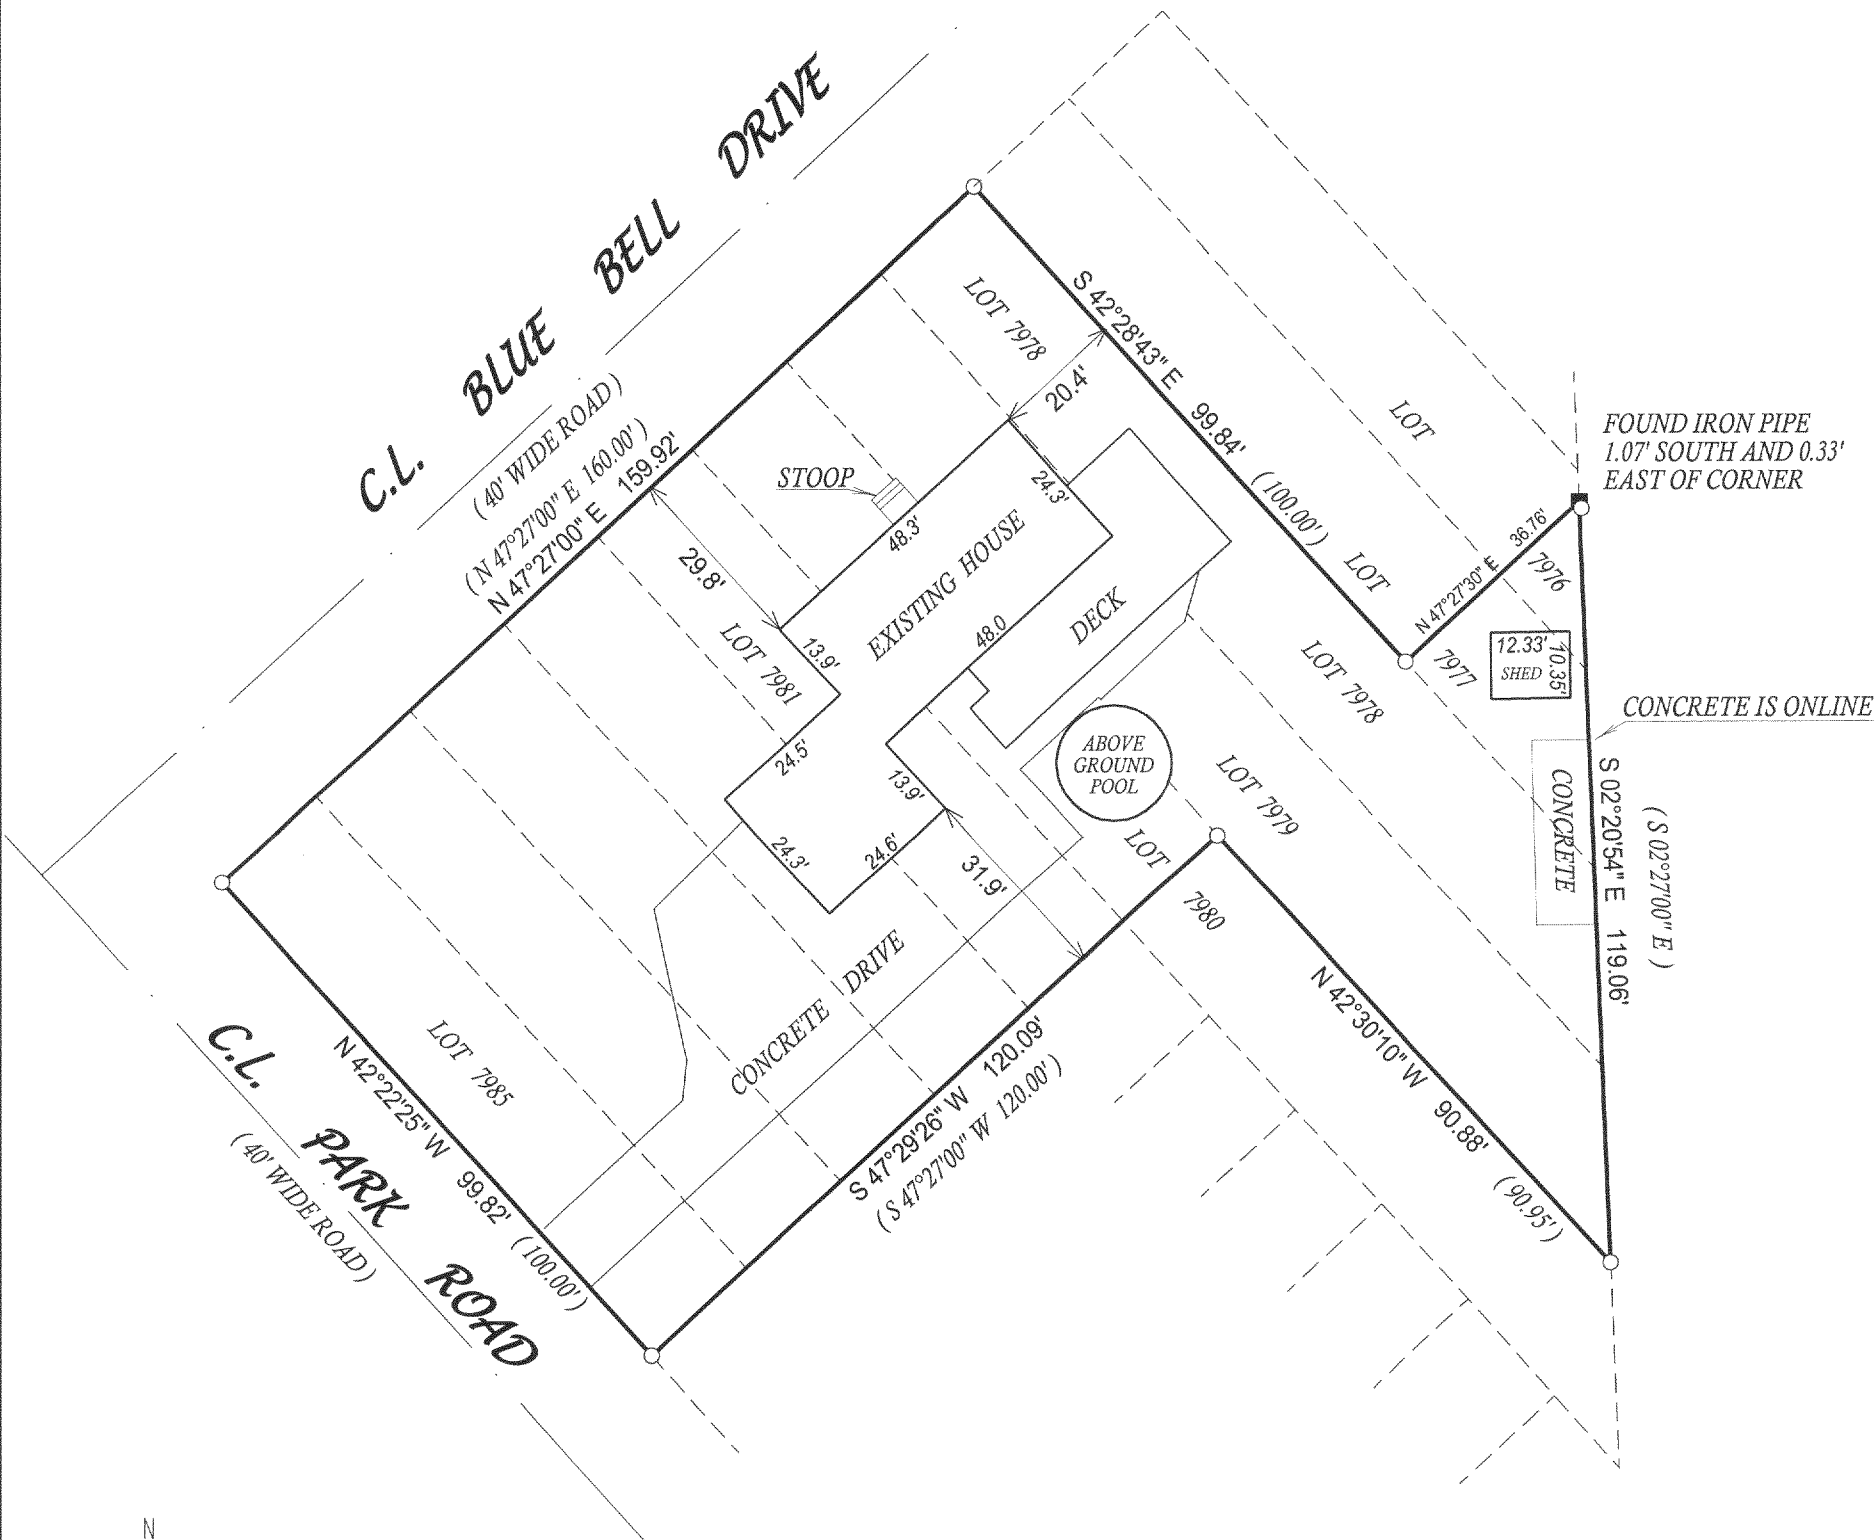

- () = recorded as
- = found iron bar
- = found iron pipe
- = set iron pipe
- = set iron bar

SCALE 1" = 30'



JOB # 05-430

TAX ID # MPL01617

COMPARE LEGAL DESCRIPTION ABOVE AND DRAWING WITH DEED. FOR BUILDING RESTRICTIONS AND EASEMENTS NOT SHOWN, REFER TO DEED, ABSTRACT SOURCES AND LOCAL MUNICIPAL CODES. NOTIFY THE SURVEYOR IMMEDIATELY OF ANY DISCREPANCY.

"I hereby certify that I have surveyed the above described property and that the above map, to the best of my knowledge and belief, is a true representation thereof and shows the size and location of all visible structures, apparent easements and encroachments if any."

This survey is made for the present owners of the property, and those who purchase, mortgage, or guarantee the title thereto, within one year from the date hereof.

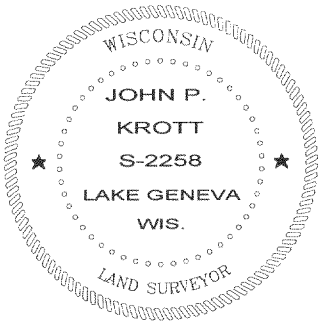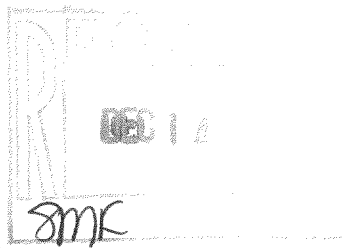

John P. Krott

JOHN KROTT S - 2258
Wisconsin Registered Land Surveyor
(original if signed in red)

DATED THIS THE 17th DAY OF AUGUST 2005.

MPL-1617

118-2668