


DEGEN-FOAT SURVEYING LLC
100 SOUTH SECOND STREET
WATERFORD, WISCONSIN
(262)534-5404 (FAX)534-2022

059152
059152S1.DWG


PLAT OF SURVEY

LOT 2, BLOCK 1 OF PART ONE OF FIRST ADDITION TO JEFFERSON ISLAND SUBDIVISION,
PART OF THE SOUTHEAST 1/4 OF SECTION 13, TOWN 1 NORTH, RANGE 18 EAST OF
THE FOURTH PRINCIPAL MERIDIAN, TOWN OF BLOOMFIELD, WALWORTH COUNTY, WISCONSIN.

PREPARED FOR: TOM ROMANO
217A 92nd STREET
GENOA CITY, WI 53128

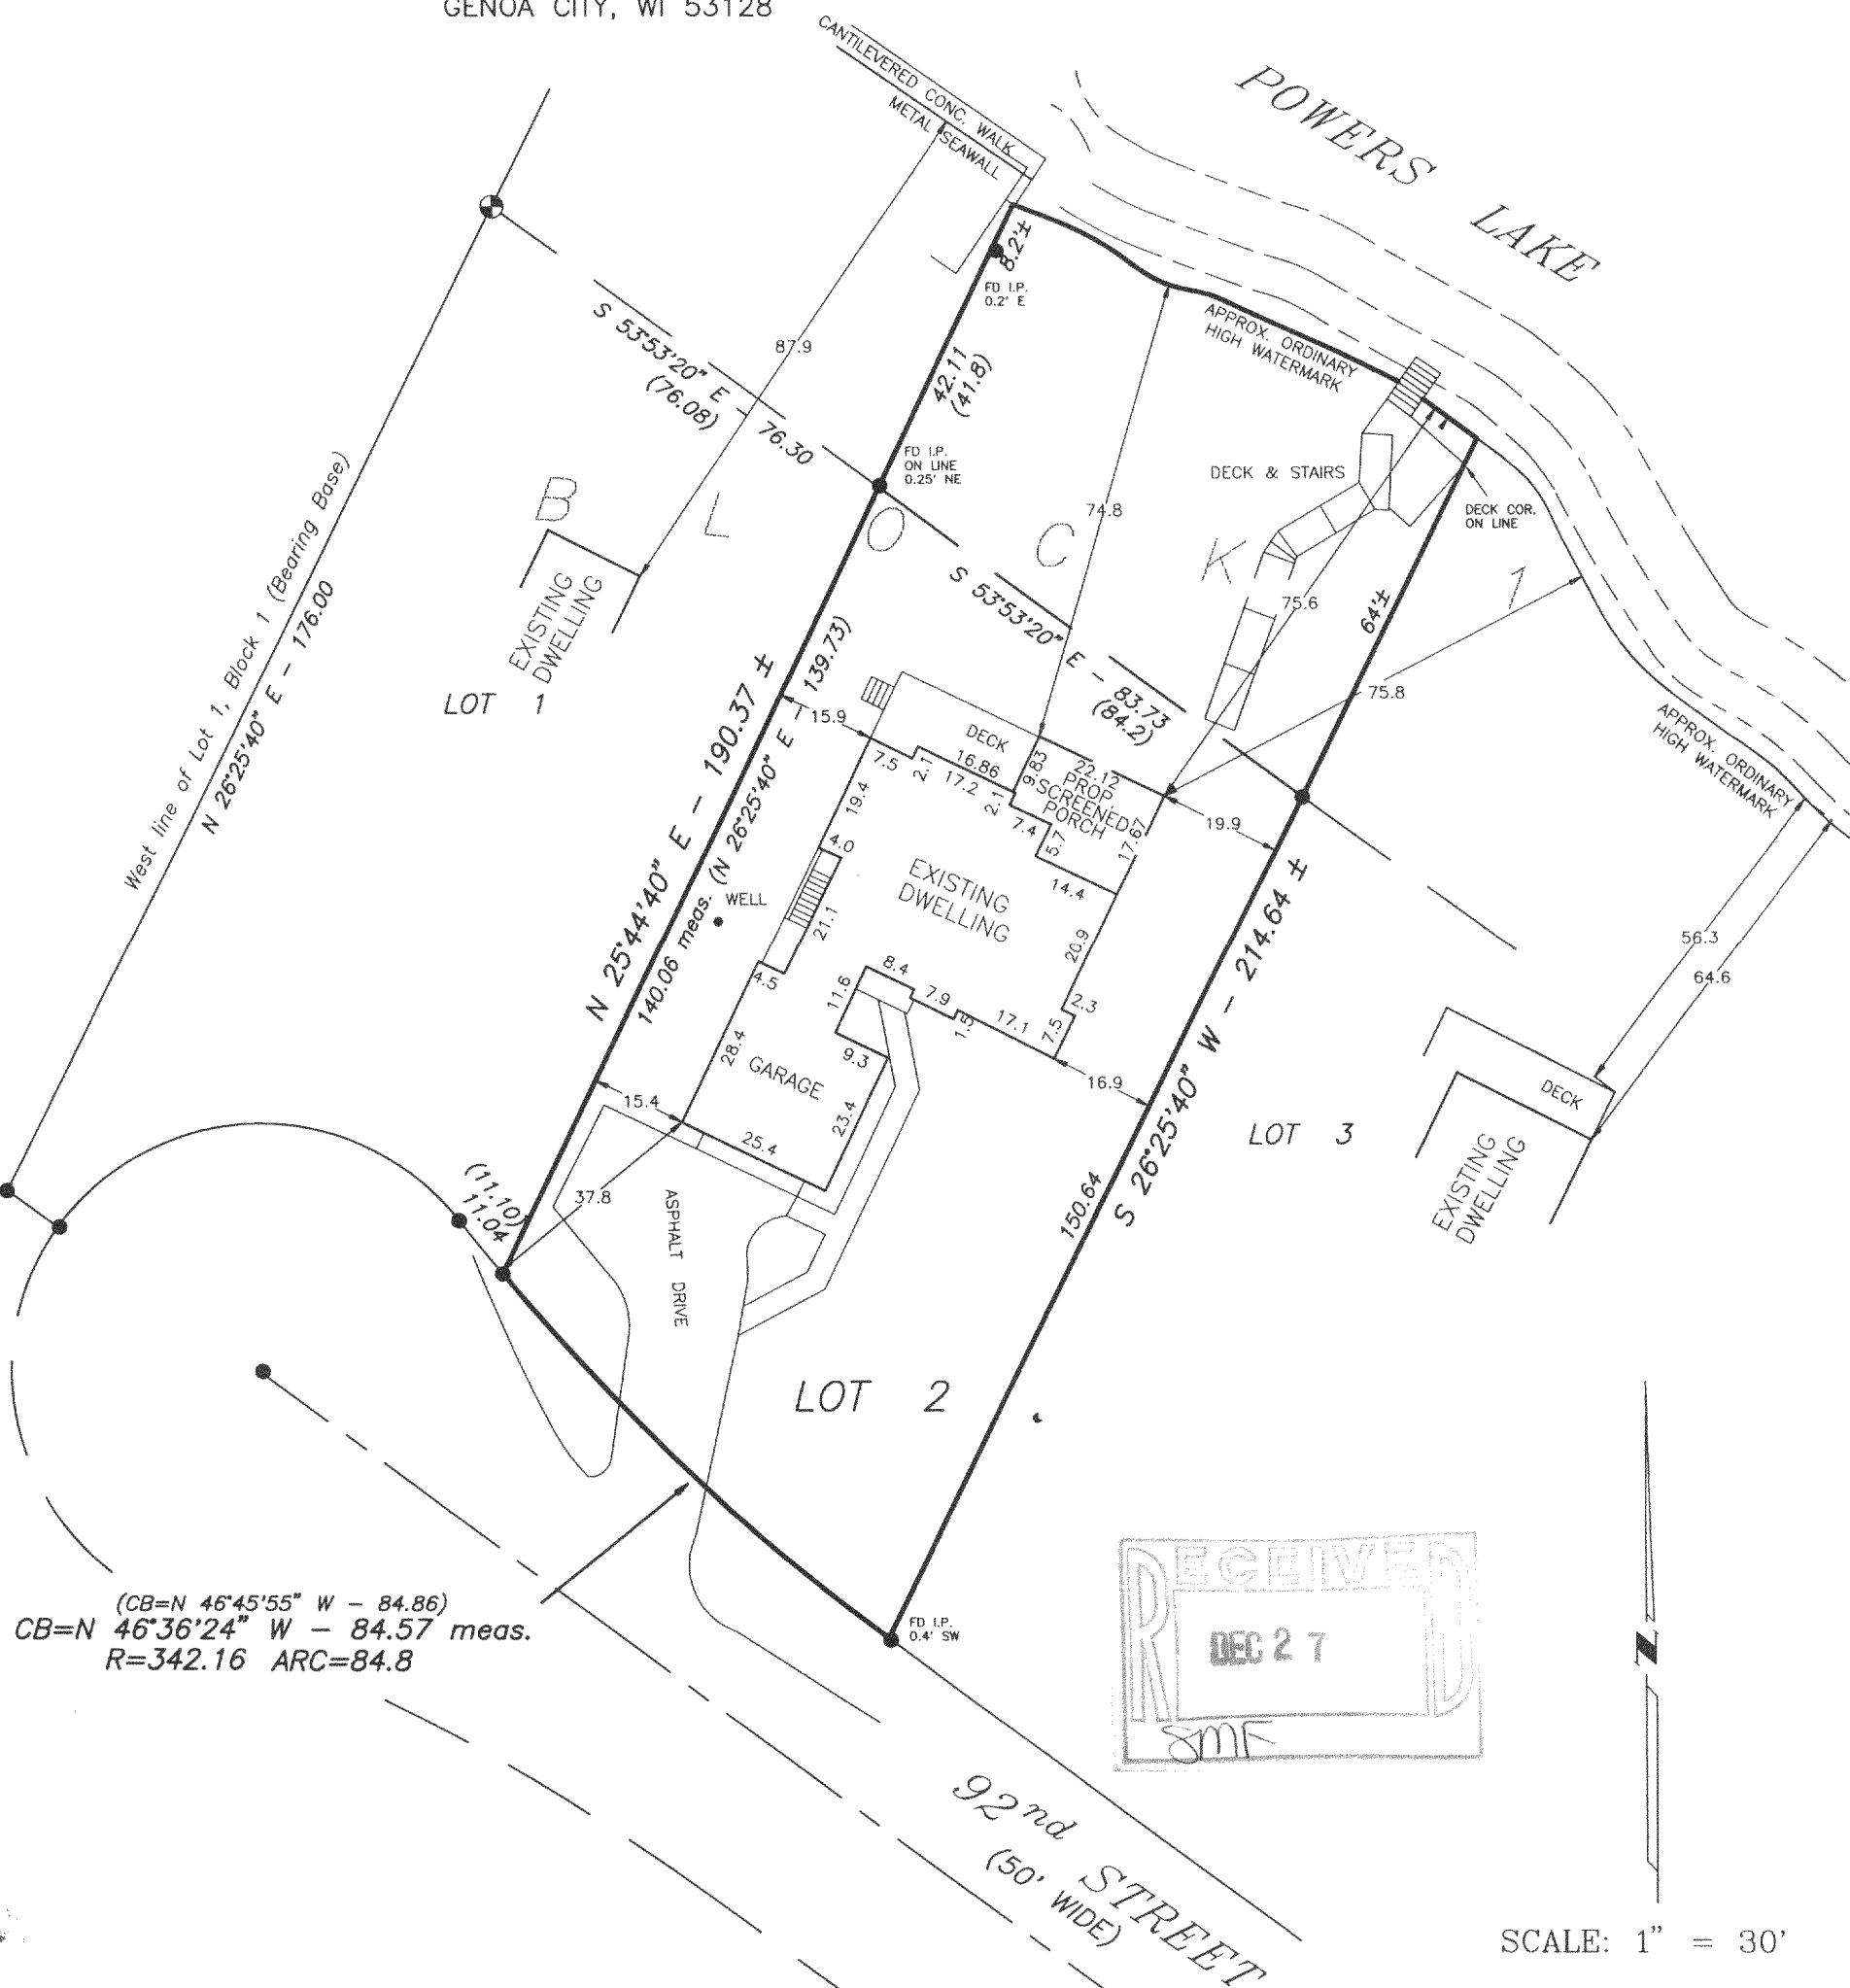

(CB=N 46°45'55" W - 84.86)
CB=N 46°36'24" W - 84.57 meas.
R=342.16 ARC=84.8

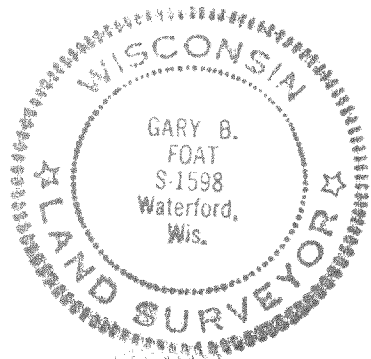

I HEREBY CERTIFY THAT I HAVE SURVEYED THE ABOVE DESCRIBED PROPERTY AND THE ABOVE MAP IS A TRUE REPRESENTATION THEREOF AND SHOWS THE SIZE AND LOCATION OF THE PROPERTY, THE LOCATION OF ALL VISIBLE STRUCTURES AND DIMENSIONS OF ALL PRINCIPAL BUILDINGS THEREON, BOUNDARY FENCES, APPARENT EASEMENTS, ROADWAY AND VISIBLE ENCROACHMENTS, IF ANY.

THIS SURVEY IS MADE FOR THE PRESENT OWNERS OF THE PROPERTY, AND ALSO THOSE WHO PURCHASE, OR GUARANTEE THE TITLE THERETO WITHIN (1) YEAR FROM THE DATE HEREOF.

DATED AT WATERFORD, WI THIS 20th DAY OF MAY 20, 05

RECERTIFIED

REV 6/24/05
Gary B. Foat

MJIS-2

118-2675