

MAR 8


ABELL SURVEYING & MAPPING

1140 SEQUOIA STREET • DELAVAN, WISCONSIN 53115
262-728-6737

PLAT OF SURVEY OF

LOT 13, LAKE GROVE SUBDIVISION, LOCATED
IN T1N, R18E, W31W, WISCONSIN.

ORDERED BY: QUENTIN & SUSAN HEISLER
529 CEDAR STREET
WINNETKA, IL 60093

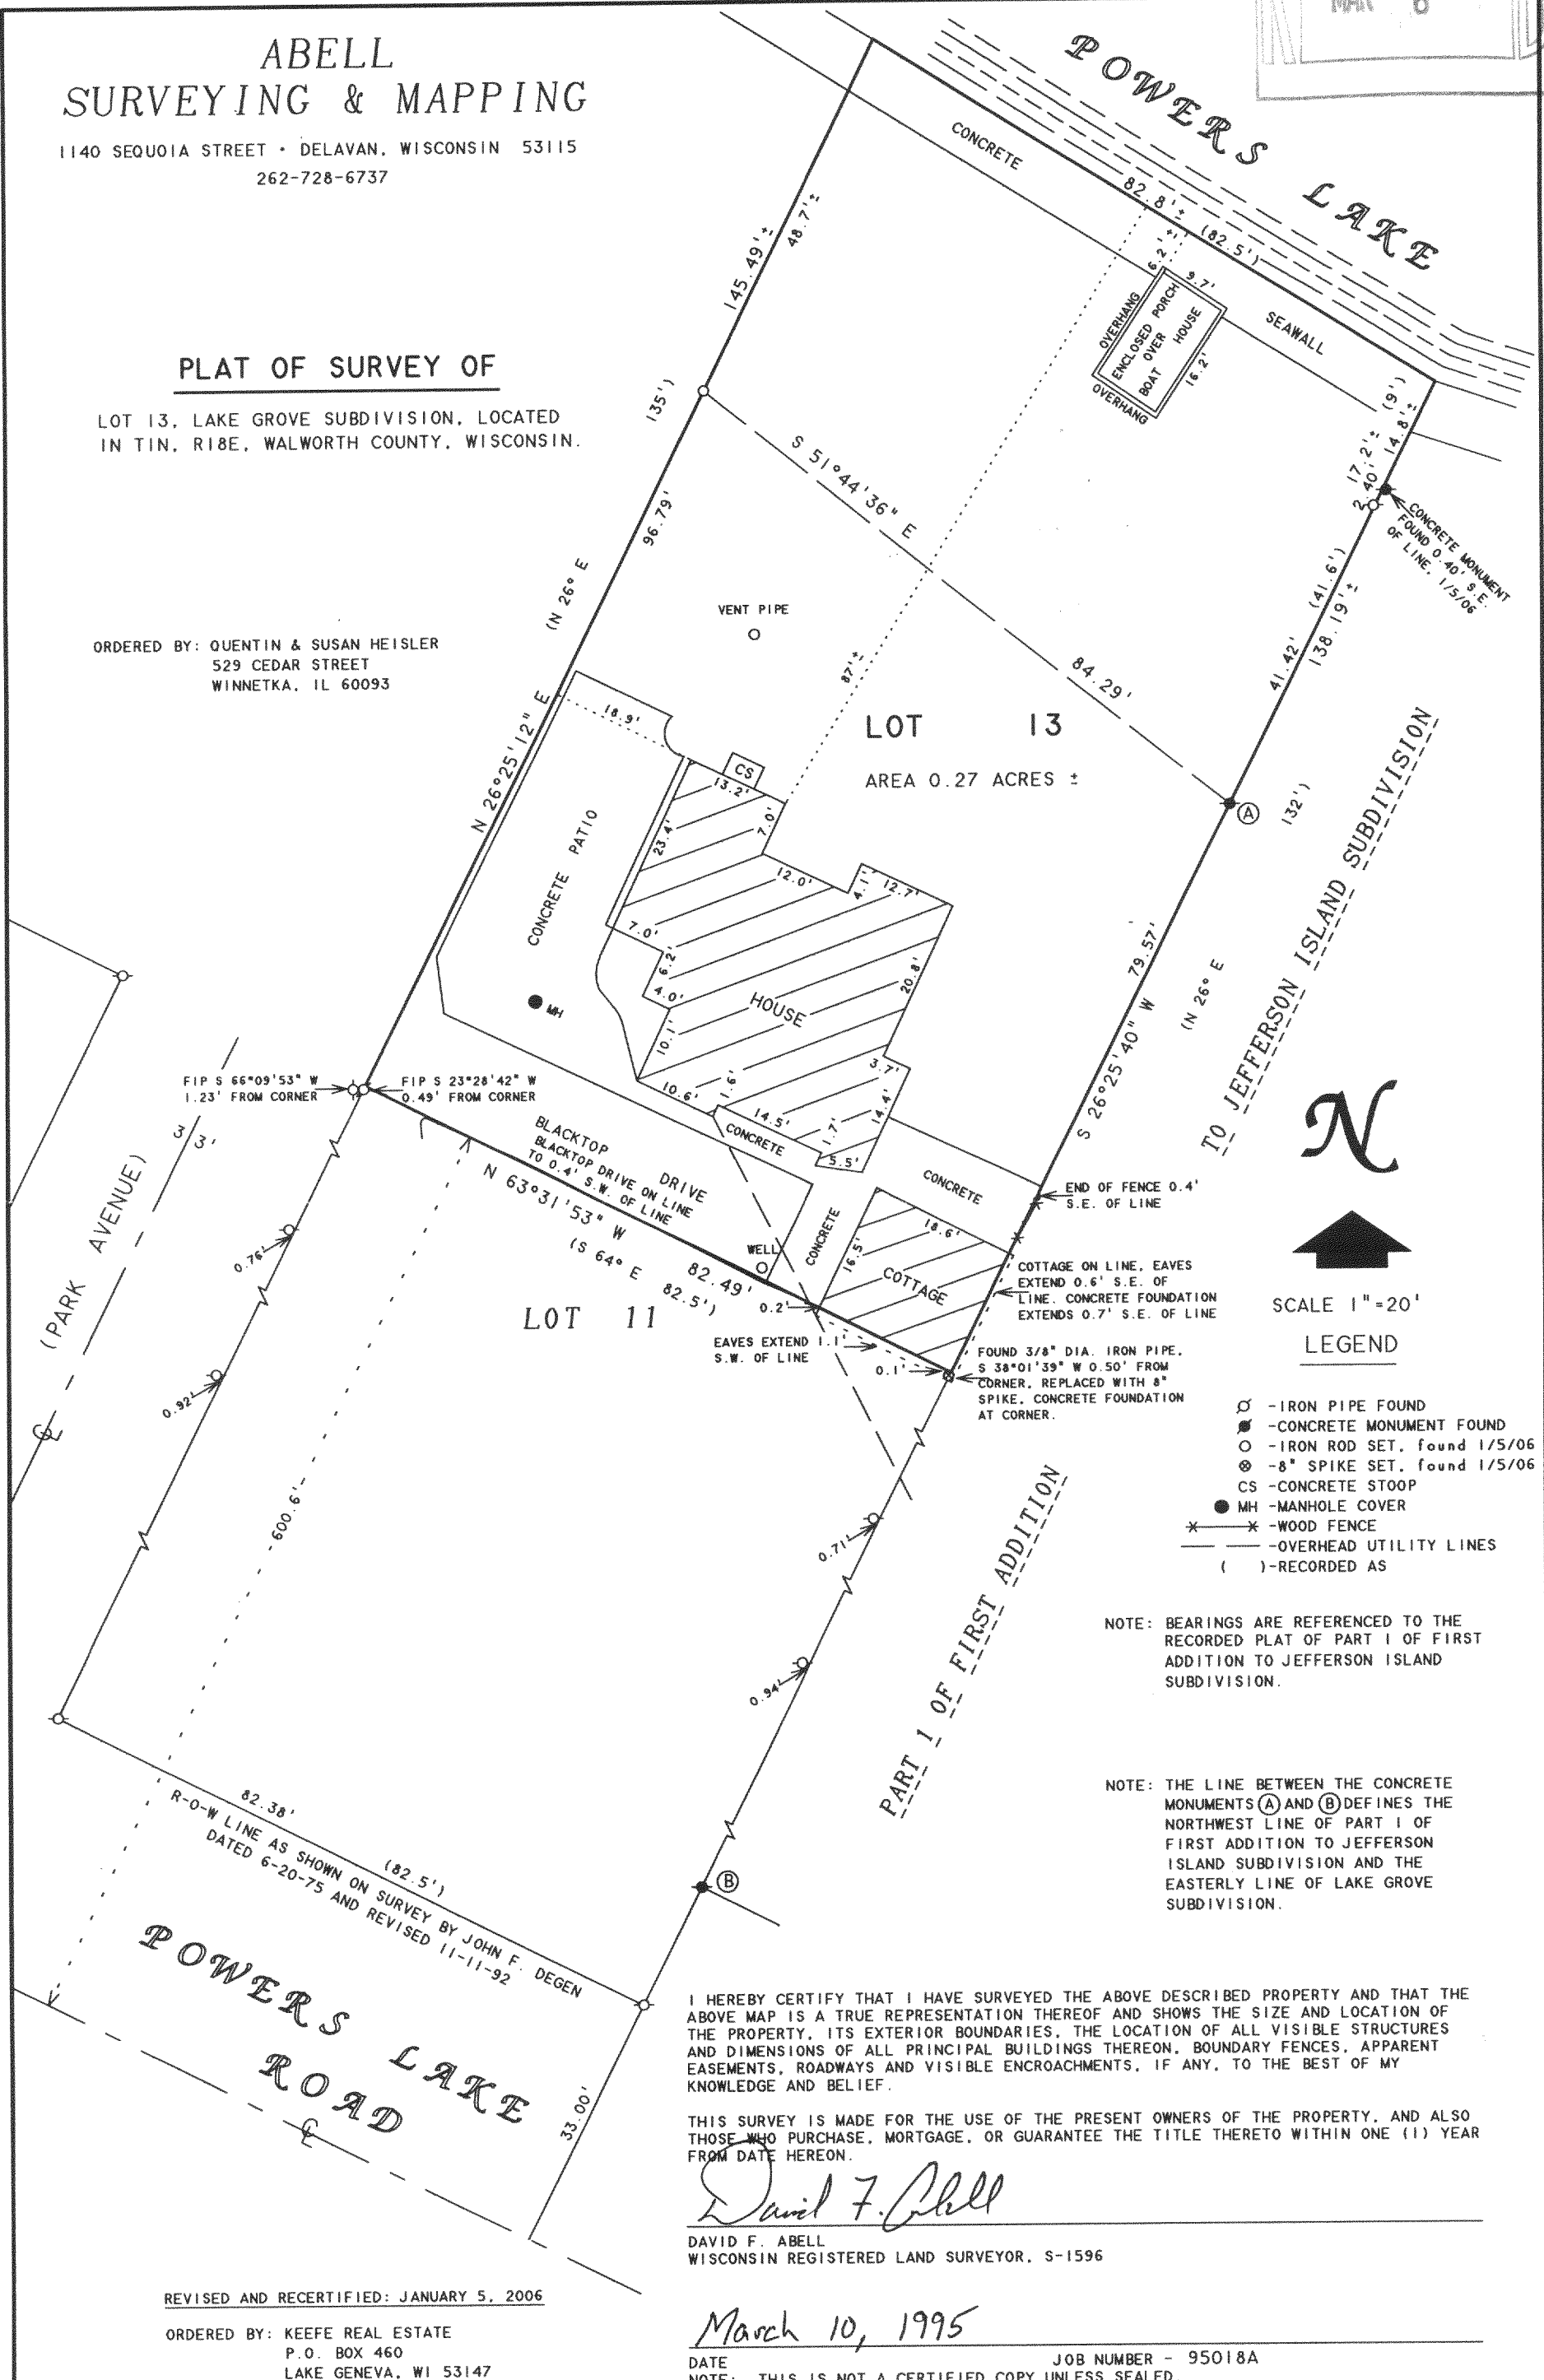

MLG-15

118-2708