



PREPARED FOR CAROL & EDWARD ERWIN  
W848 EAU CLAIRE RD.  
GENOA CITY WI. 53128

# PLAT OF SURVEY

- OF -

PATHFINDER SURVEYING INC.  
N3705 WILLOW BEND LANE  
LAKE GENEVA WI. 53147

LOTS 680-684 OF BLOCK 12 OF PELL LAKE ADDITION,  
A SUBDIVISION LOCATED IN T1N, R18E, WAL WORTH COUNTY, WISCONSIN.

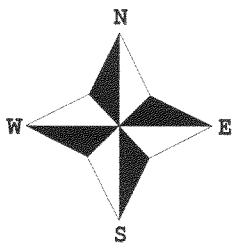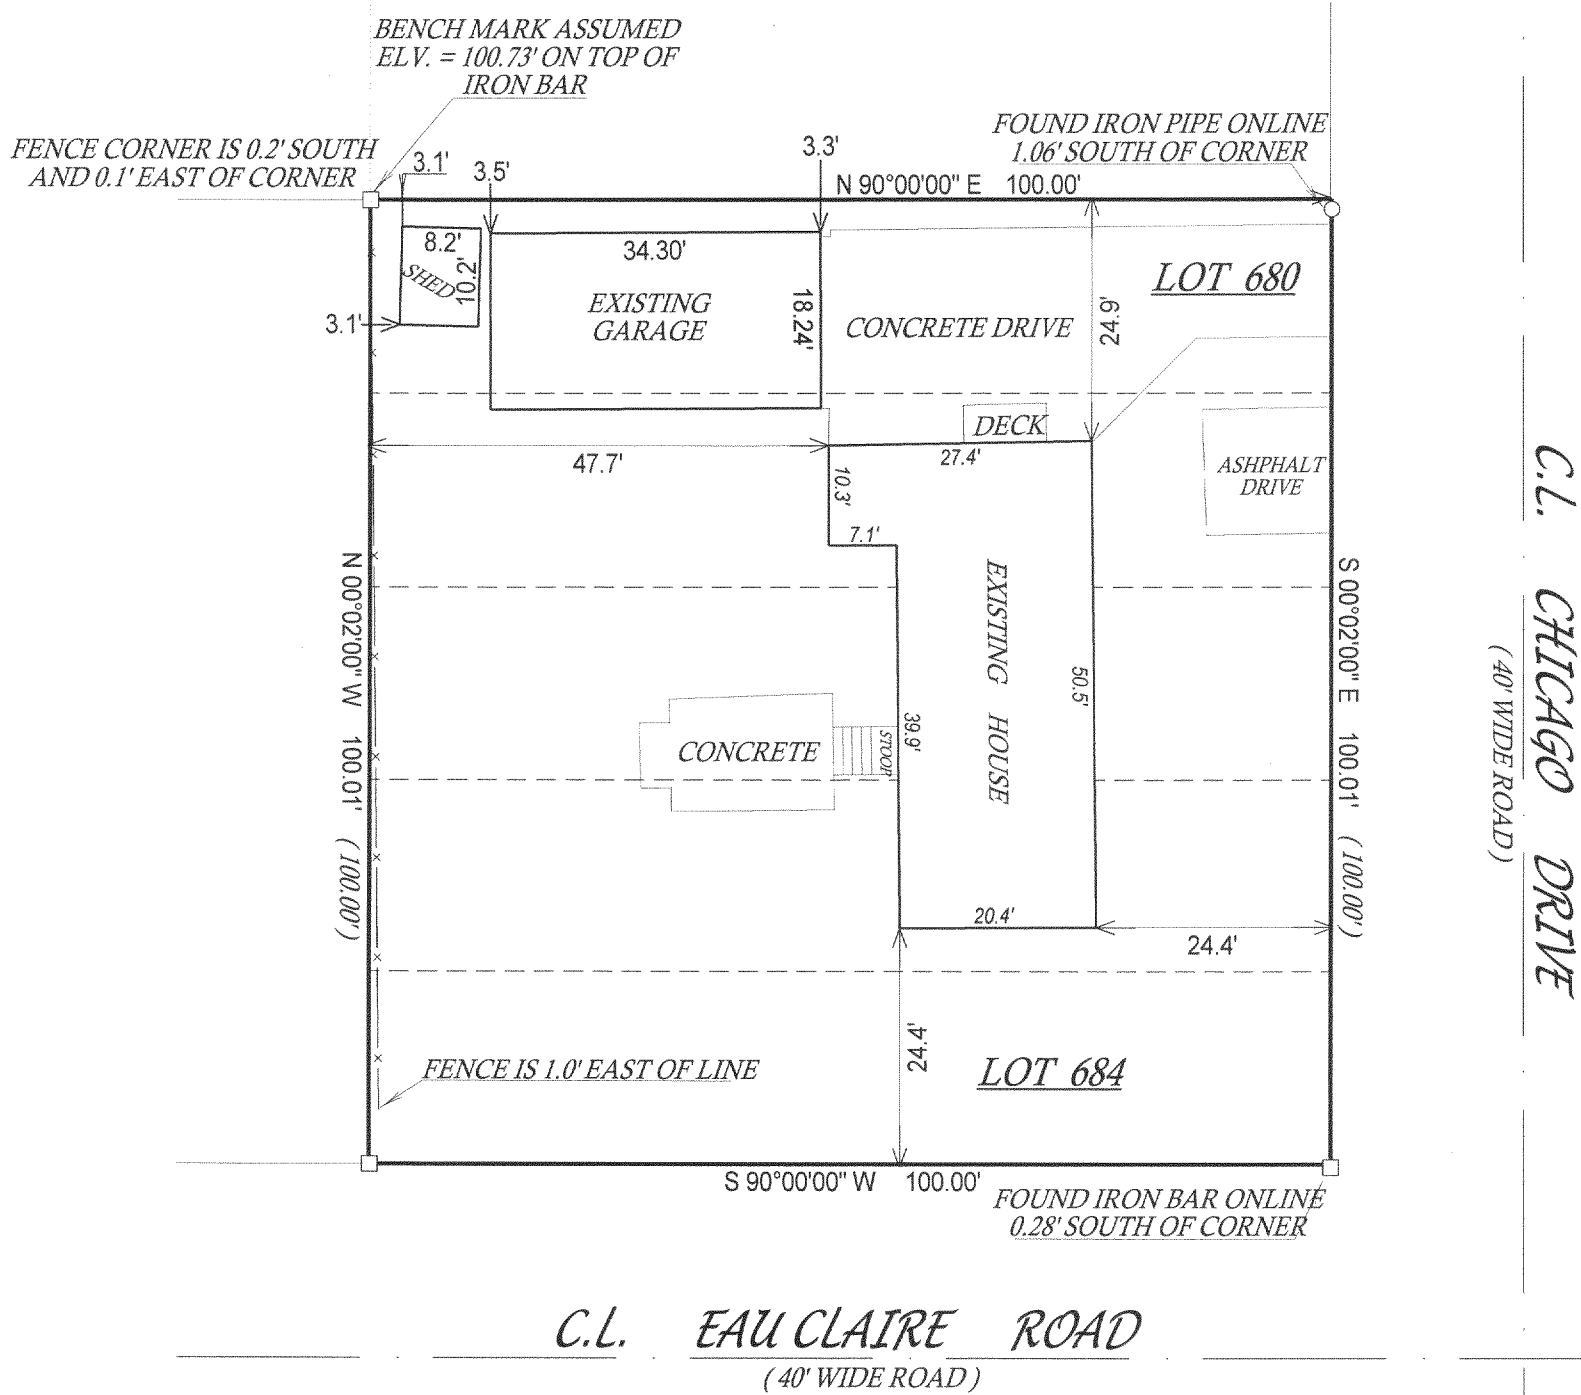

( ) = recorded as

□ = found iron bar

○ = found iron pipe



● = set iron pipe

■ = set iron bar

SCALE 1" = 20'

JOB # 05-329AB

TAX ID # MPLA00138

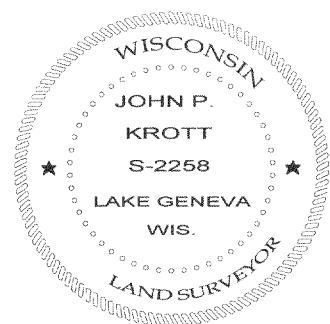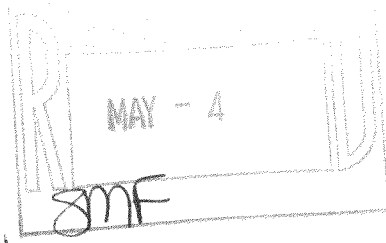

COMPARE LEGAL DESCRIPTION ABOVE AND DRAWING WITH DEED. FOR BUILDING RESTRICTIONS AND EASEMENTS NOT SHOWN, REFER TO DEED, ABSTRACT SOURCES AND LOCAL MUNICIPAL CODES. NOTIFY THE SURVEYOR IMMEDIATELY OF ANY DISCREPANCY.

"I hereby certify that I have surveyed the above described property and that the above map, to the best of my knowledge and belief, is a true representation thereof and shows the size and location of all visible structures, apparent easements and encroachments if any."

This survey is made for the present owners of the property, and those who purchase, mortgage, or guarantee the title thereto, within one year from the date hereof.

*John P. Krott*  
JOHN KROTT S - 2258  
Wisconsin Registered Land Surveyor  
(original if signed in red)

REVISED 4/3/2006, GARAGE AS BUILT  
DATED THIS THE 13th DAY OF JULY 2005.

MPLA-138

118-2716