

DEGEN-FOAT SURVEYING LLC


100 SOUTH SECOND STREET  
WATERFORD, WISCONSIN  
(262)534-5404 (FAX)534-2022

059353  
059353S1.DWG

PLAT OF SURVEY

LOT 29, NIPPERSINK HIGHLANDS, LOCATED IN THE NORTHEAST 1/4 OF THE NORTHEAST 1/4 AND  
IN THE NORTHWEST 1/4 OF THE NORTHEAST 1/4 OF SECTION 24, TOWN 1 NORTH, RANGE 18  
EAST, TOWN OF BLOOMFIELD, WALWORTH COUNTY, WISCONSIN.

SURVEY PREPARED FOR: RE/MAX - SOUTHERN LAKES  
DEBBIE SARNA  
112 ELIZABETH LANE  
GENOA CITY, WI 53128

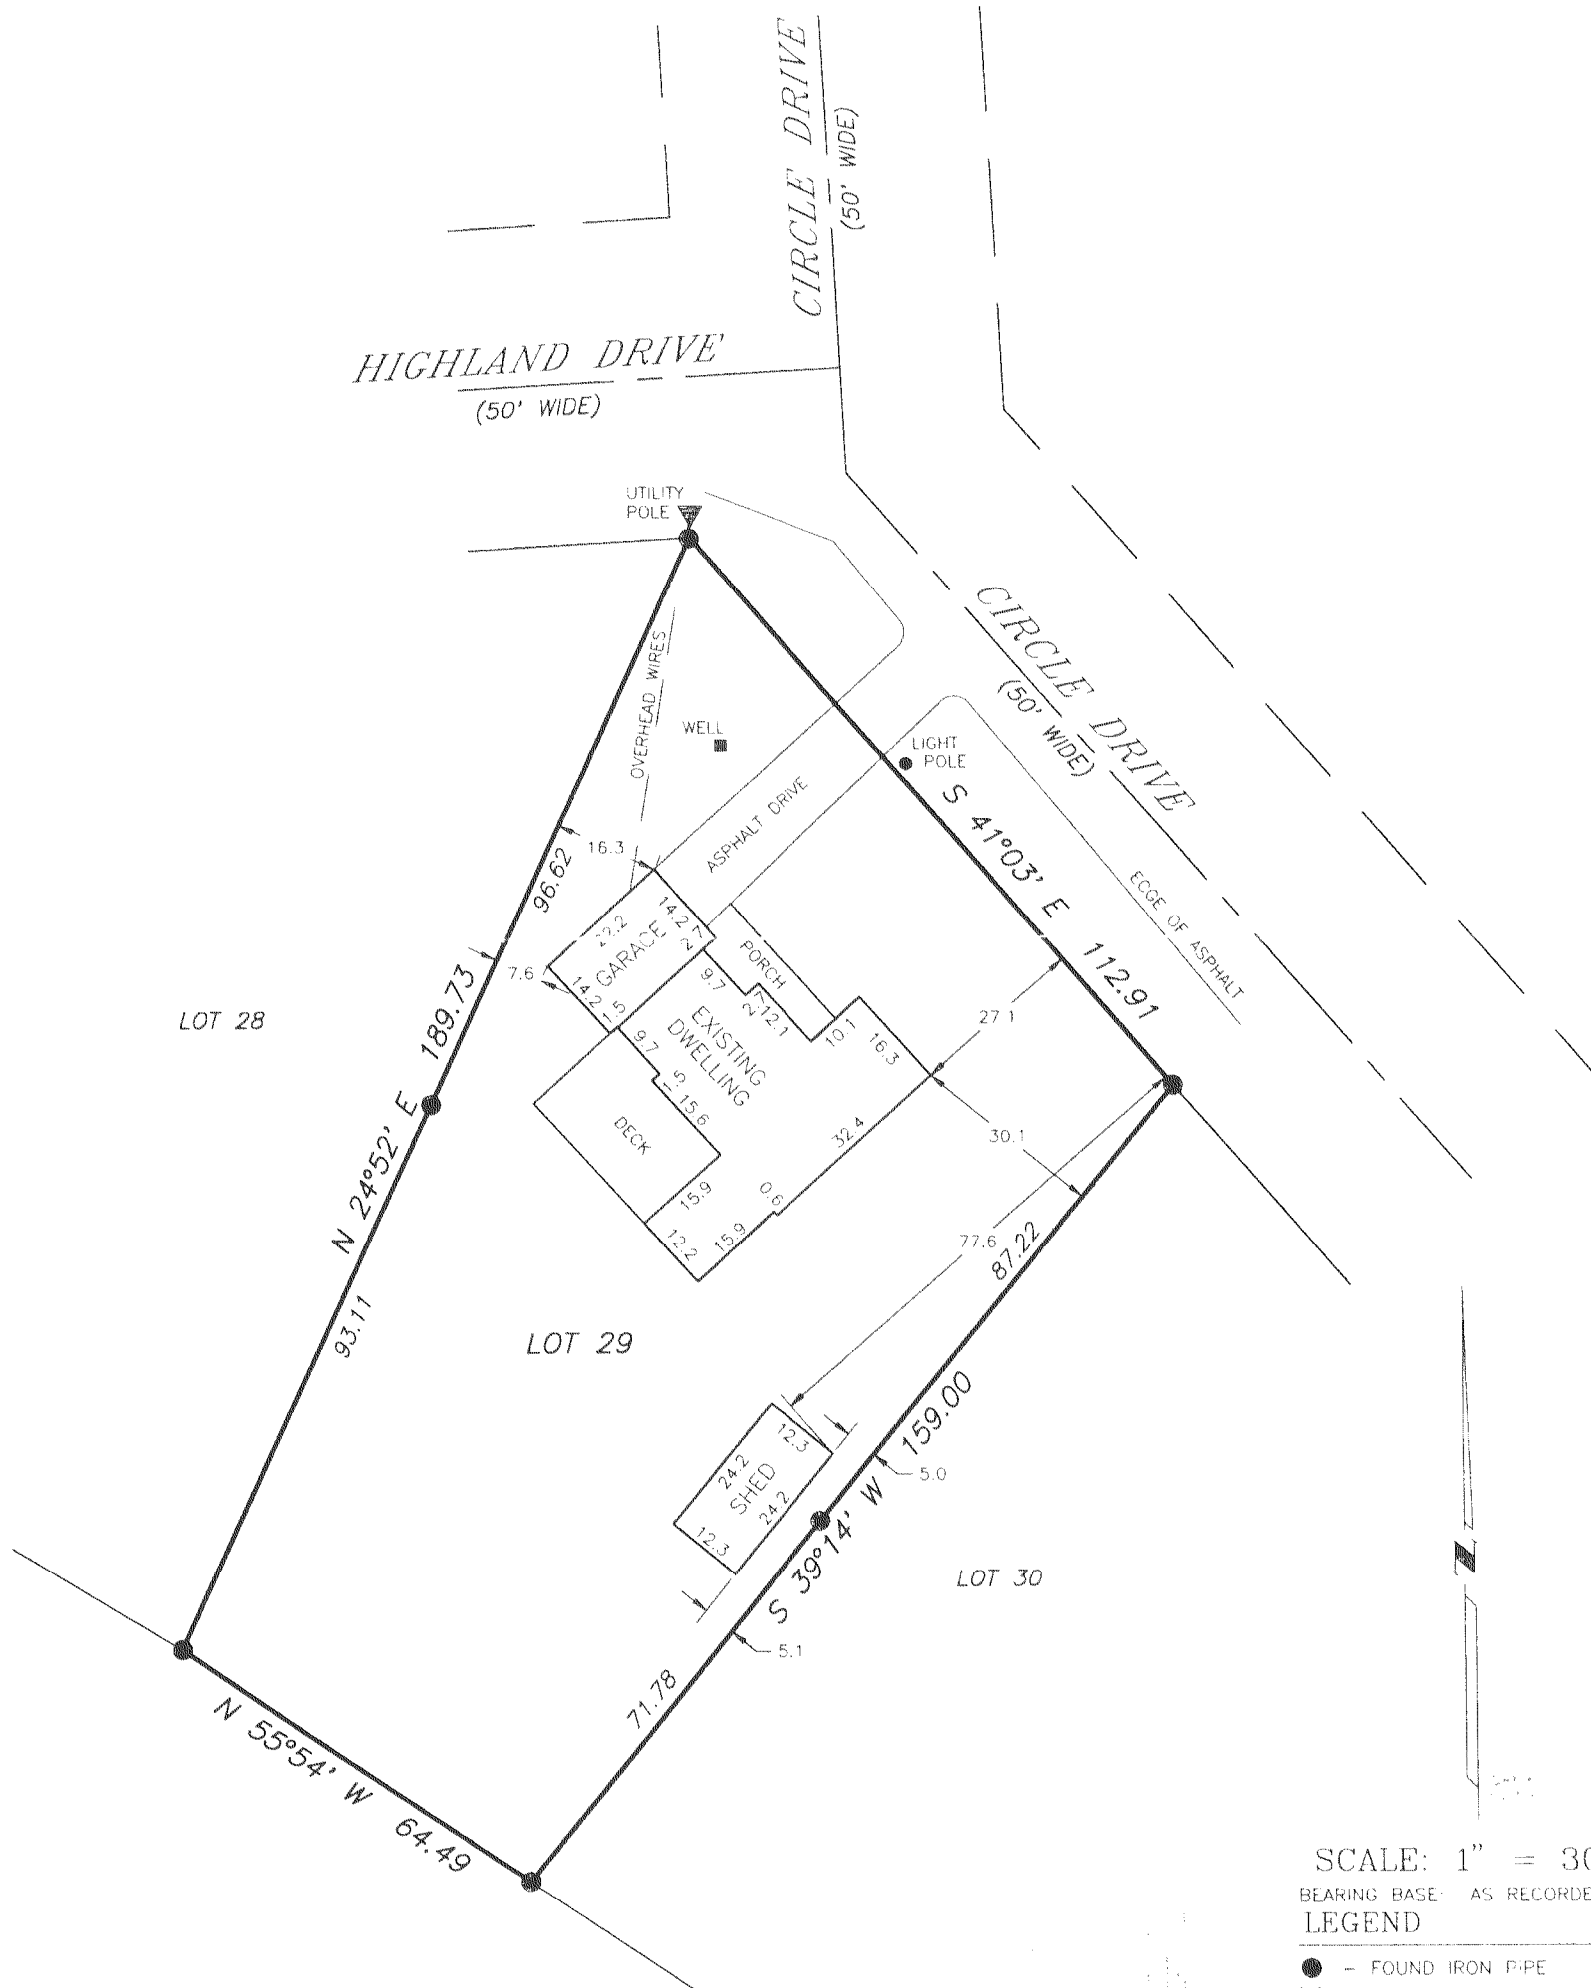

SCALE: 1" = 30'  
BEARING BASE: AS RECORDED AS.  
LEGEND

- - FOUND IRON PIPE
- ( ) - RECORDED AS

JUN 21 2008

SMF



I HEREBY CERTIFY THAT I HAVE SURVEYED THE ABOVE DESCRIBED PROPERTY AND THE ABOVE MAP IS A TRUE REPRESENTATION THEREOF  
AND SHOWS THE SIZE AND LOCATION OF THE PROPERTY, THE LOCATION OF ALL VISIBLE STRUCTURES AND DIMENSIONS OF ALL PRINCIPAL  
BUILDINGS THEREON, BOUNDARY FENCES, APPARENT EASEMENTS, ROADWAY AND VISIBLE ENCROACHMENTS, IF ANY.

THIS SURVEY IS MADE FOR THE PRESENT OWNERS OF THE PROPERTY, AND ALSO THOSE WHO PURCHASE, OR GUARANTEE THE TITLE THERETO  
WITHIN (1) YEAR FROM THE DATE HEREOF

DATED AT WATERFORD, WI THIS 29th DAY OF NOVEMBER 20 05

RECEIVED

Gary B. Foat

MNH-29

118-2729