


LOTS 6577 THRU 6581, BLOCK 143, PELL LAKE SECTION
4 SUBDIVISION, ACCORDING TO THE RECORDED PLAT
THEREOF. SAID LAND BEING IN THE TOWN OF
BLOOMFIELD, COUNTY OF WALWORTH, STATE OF
WISCONSIN.


SURVEY FOR: ADAM MAYER REAL ESTATE CO. INC.

SURVEY ADDRESS: N1639 ORCHID DR.

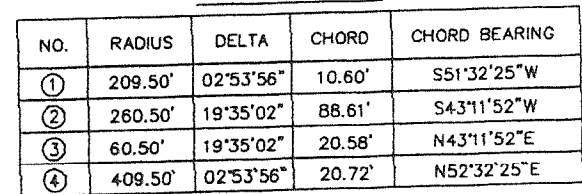

"I hereby certify that I have surveyed the above described property and that the above map is a correct representation thereof and shows the size and location of the property, its exterior boundaries, the location of all visible structures and dimensions of all principal buildings thereon, boundary fences, apparent easements, roadways and encroachments, if any."


"This survey is made for the use of the present owners of the property, and those who purchase, mortgage, or guarantee the title thereto within one year from date hereof."

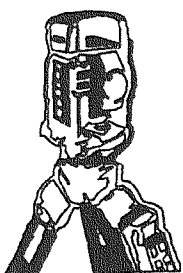

B.W. SURVEYING, INC.

LAND SURVEYS
MAPPING AND PLANNING
412 N. PINE STREET
BURLINGTON, WI 53105
(262)-767-0225

SCALE:
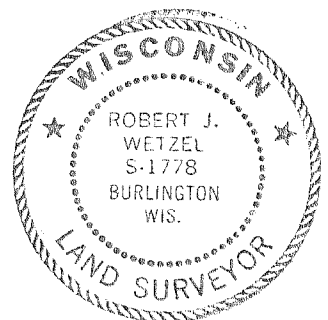
$$1'' = 30'$$


THIS IS NOT AN ORIGINAL PRINT
UNLESS THIS SEAL IS RED.

ROBERT J. WETZEL

REV: MARCH 23, 2006
MARCH 21, 2006

DATE _____

0 S-1778

7205
JOB NUMBER

MPL-1437

118-2745