



PREPARED FOR:
TOM MARTIN
KEEFE REALTY
1040 N WISCONSIN ST.
ELKHORN, WI 53121

PLAT OF SURVEY

-OF-

LOTS 492 THRU 498, BLOCK 117, OF PELL LAKE HIGHLANDS, LOCATED
IN SECTION 16, TOWN 1 NORTH, RANGE 18 EAST, WALWORTH COUNTY,
WISCONSIN.

PATHFINDER SURVEYING INC.
W2888 KRUEGER ROAD, UNIT "D"
LAKE GENEVA, WI, 53147
262-248-3697

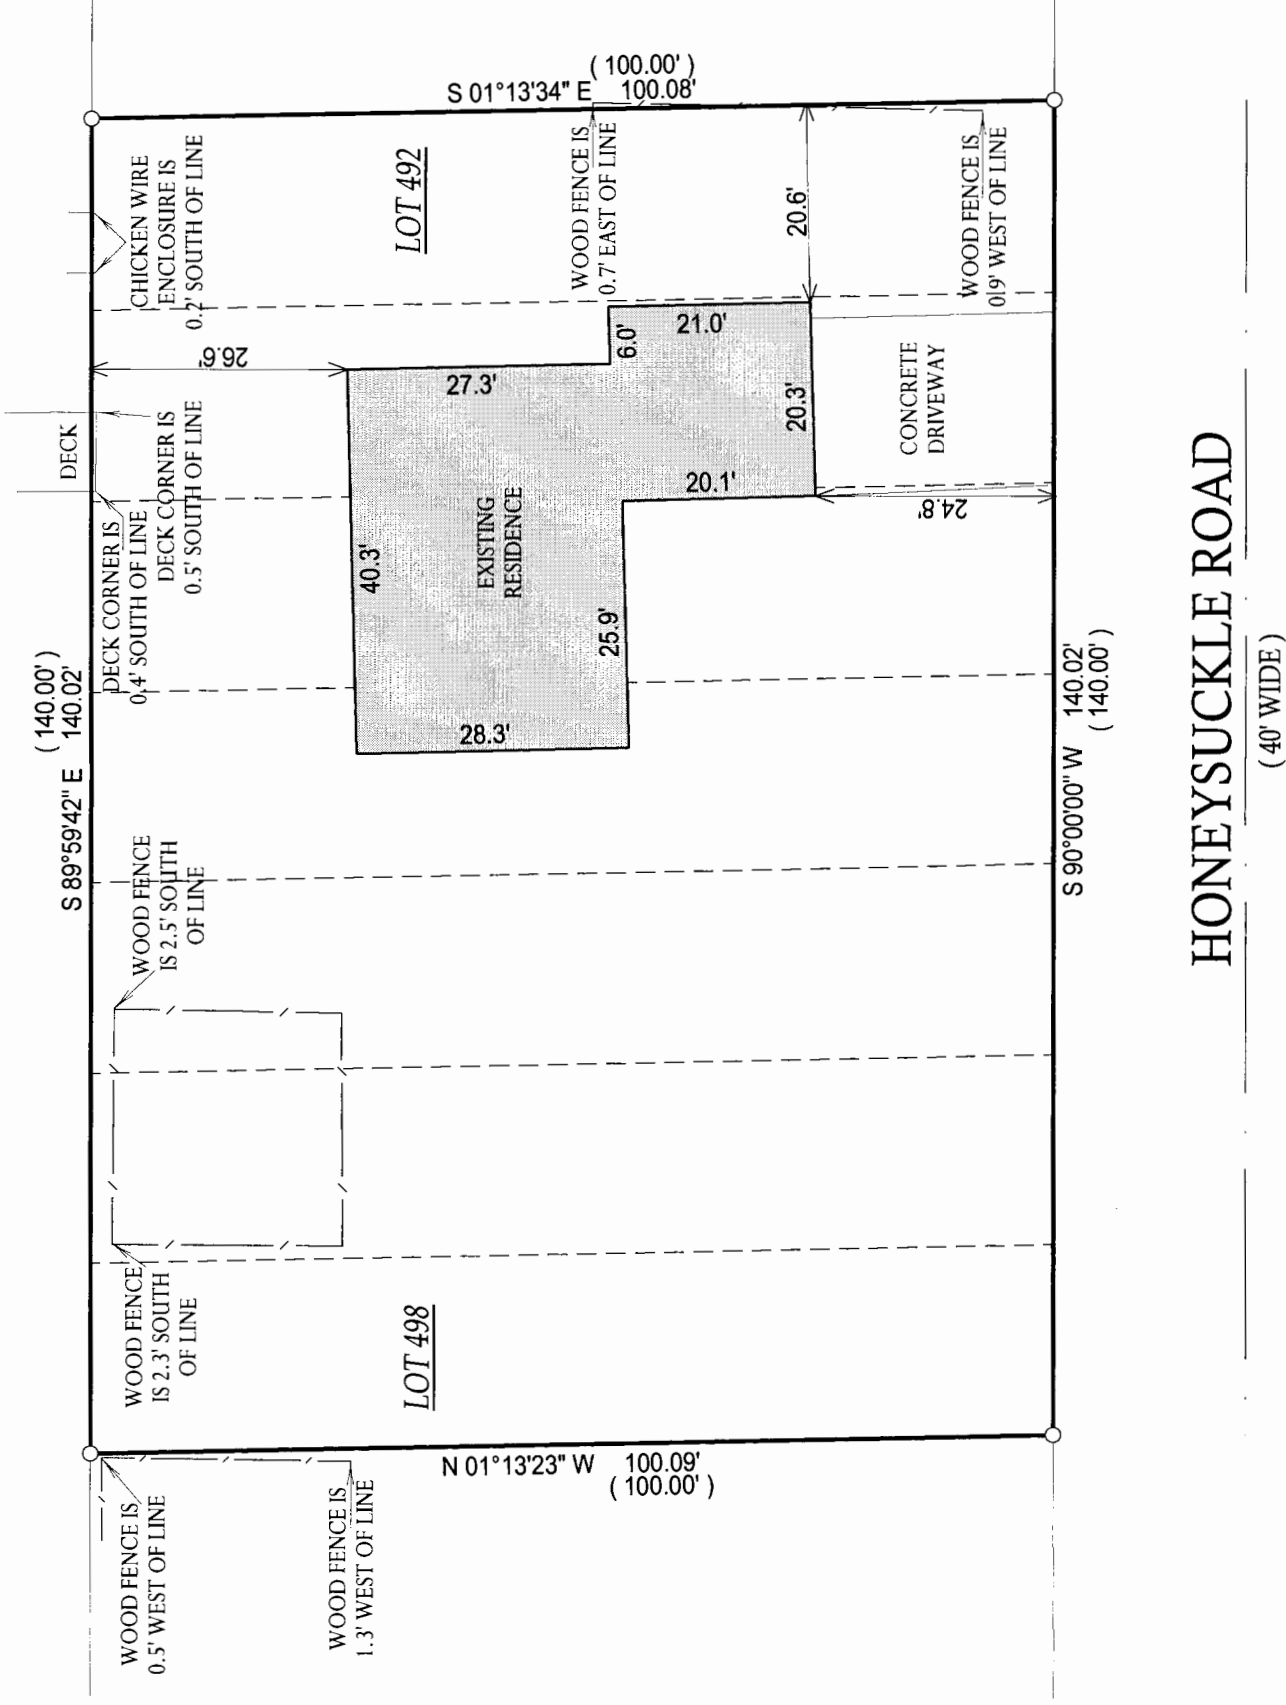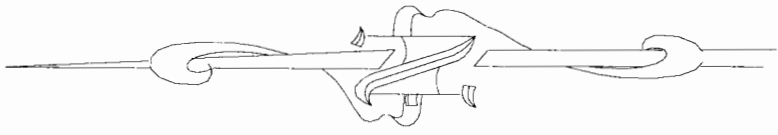

JUL 28 2006

8MF

() = RECORDED AS

□ = FOUND IRON BAR

○ = FOUND IRON PIPE

● = SET IRON PIPE

■ = SET IRON BAR

SCALE: 1" = 20'

JOB #: 06-308


TAX ID #: MPLH 00117

COMPARE LEGAL DESCRIPTION ABOVE AND DRAWING WITH DEED. FOR BUILDING RESTRICTIONS AND EASEMENTS NOT SHOWN REFER TO DEED. ABSTRACT SOURCES AND LOCAL MUNICIPAL CODES. NOTIFY THE SURVEYOR IMMEDIATELY OF ANY DISCREPANCY.

"I hereby certify that the above described property was surveyed under my supervision and that the above map, to the best of my knowledge and belief, is a true representation thereof and shows the size and location of all visible structures, apparent easements and encroachments if any." This survey is made for the present owners of the property, and those who purchase, mortgage, or guarantee the title thereto, within one year from the date hereof.

NOTE: BASIS OF BEARING IS HONEYSUCKLE
ROAD ASSUMED EAST-WEST.

DATED THE 16th DAY OF JUNE, 2006.

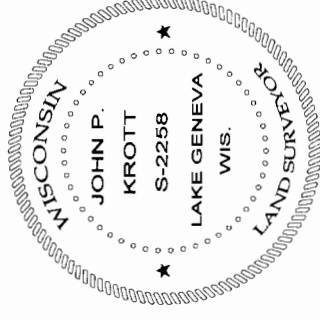

John P. Krott

JOHN KROTT S - 2258
Wisconsin Registered Land Surveyor
(original if signed in red)

118-2747