

LAND-MARK SURVEYING

Mark L. Miritz

Wisconsin Registered Land Surveyor S-2582

N9330 Knuteson Drive
Whitewater, WI 53190
Phone: (262) 495-3284
FAX: (262) 495-8421
LAND-MARKSURVEYING.COM

PLAT OF SURVEY

LOTS 3170 THRU 3174 AND LOTS 3180
THRU 3182, BLOCK 48, PELL LAKE
SUBDIVISION, LOCATED IN SECTION 22,
TOWN 1 NORTH, RANGE 18 EAST,
BLOOMFIELD TOWNSHIP, WALWORTH
COUNTY, WISCONSIN.

ORDERED BY:
TOM ROSS
HOMESTEAD REALTY
520 BROAD STREET
LAKE GENEVA, WI 53147

AUG 11 2006


DETAIL
NOT TO SCALE

FOUND IRON PIPE IS
N 18° 26' 00" W 0.84'
OF CORNER

FOUND IRON PIPE IS
ON THE SOUTH LINE
1.0' WEST OF CORNER

IRIS ROAD

(40' WIDE)

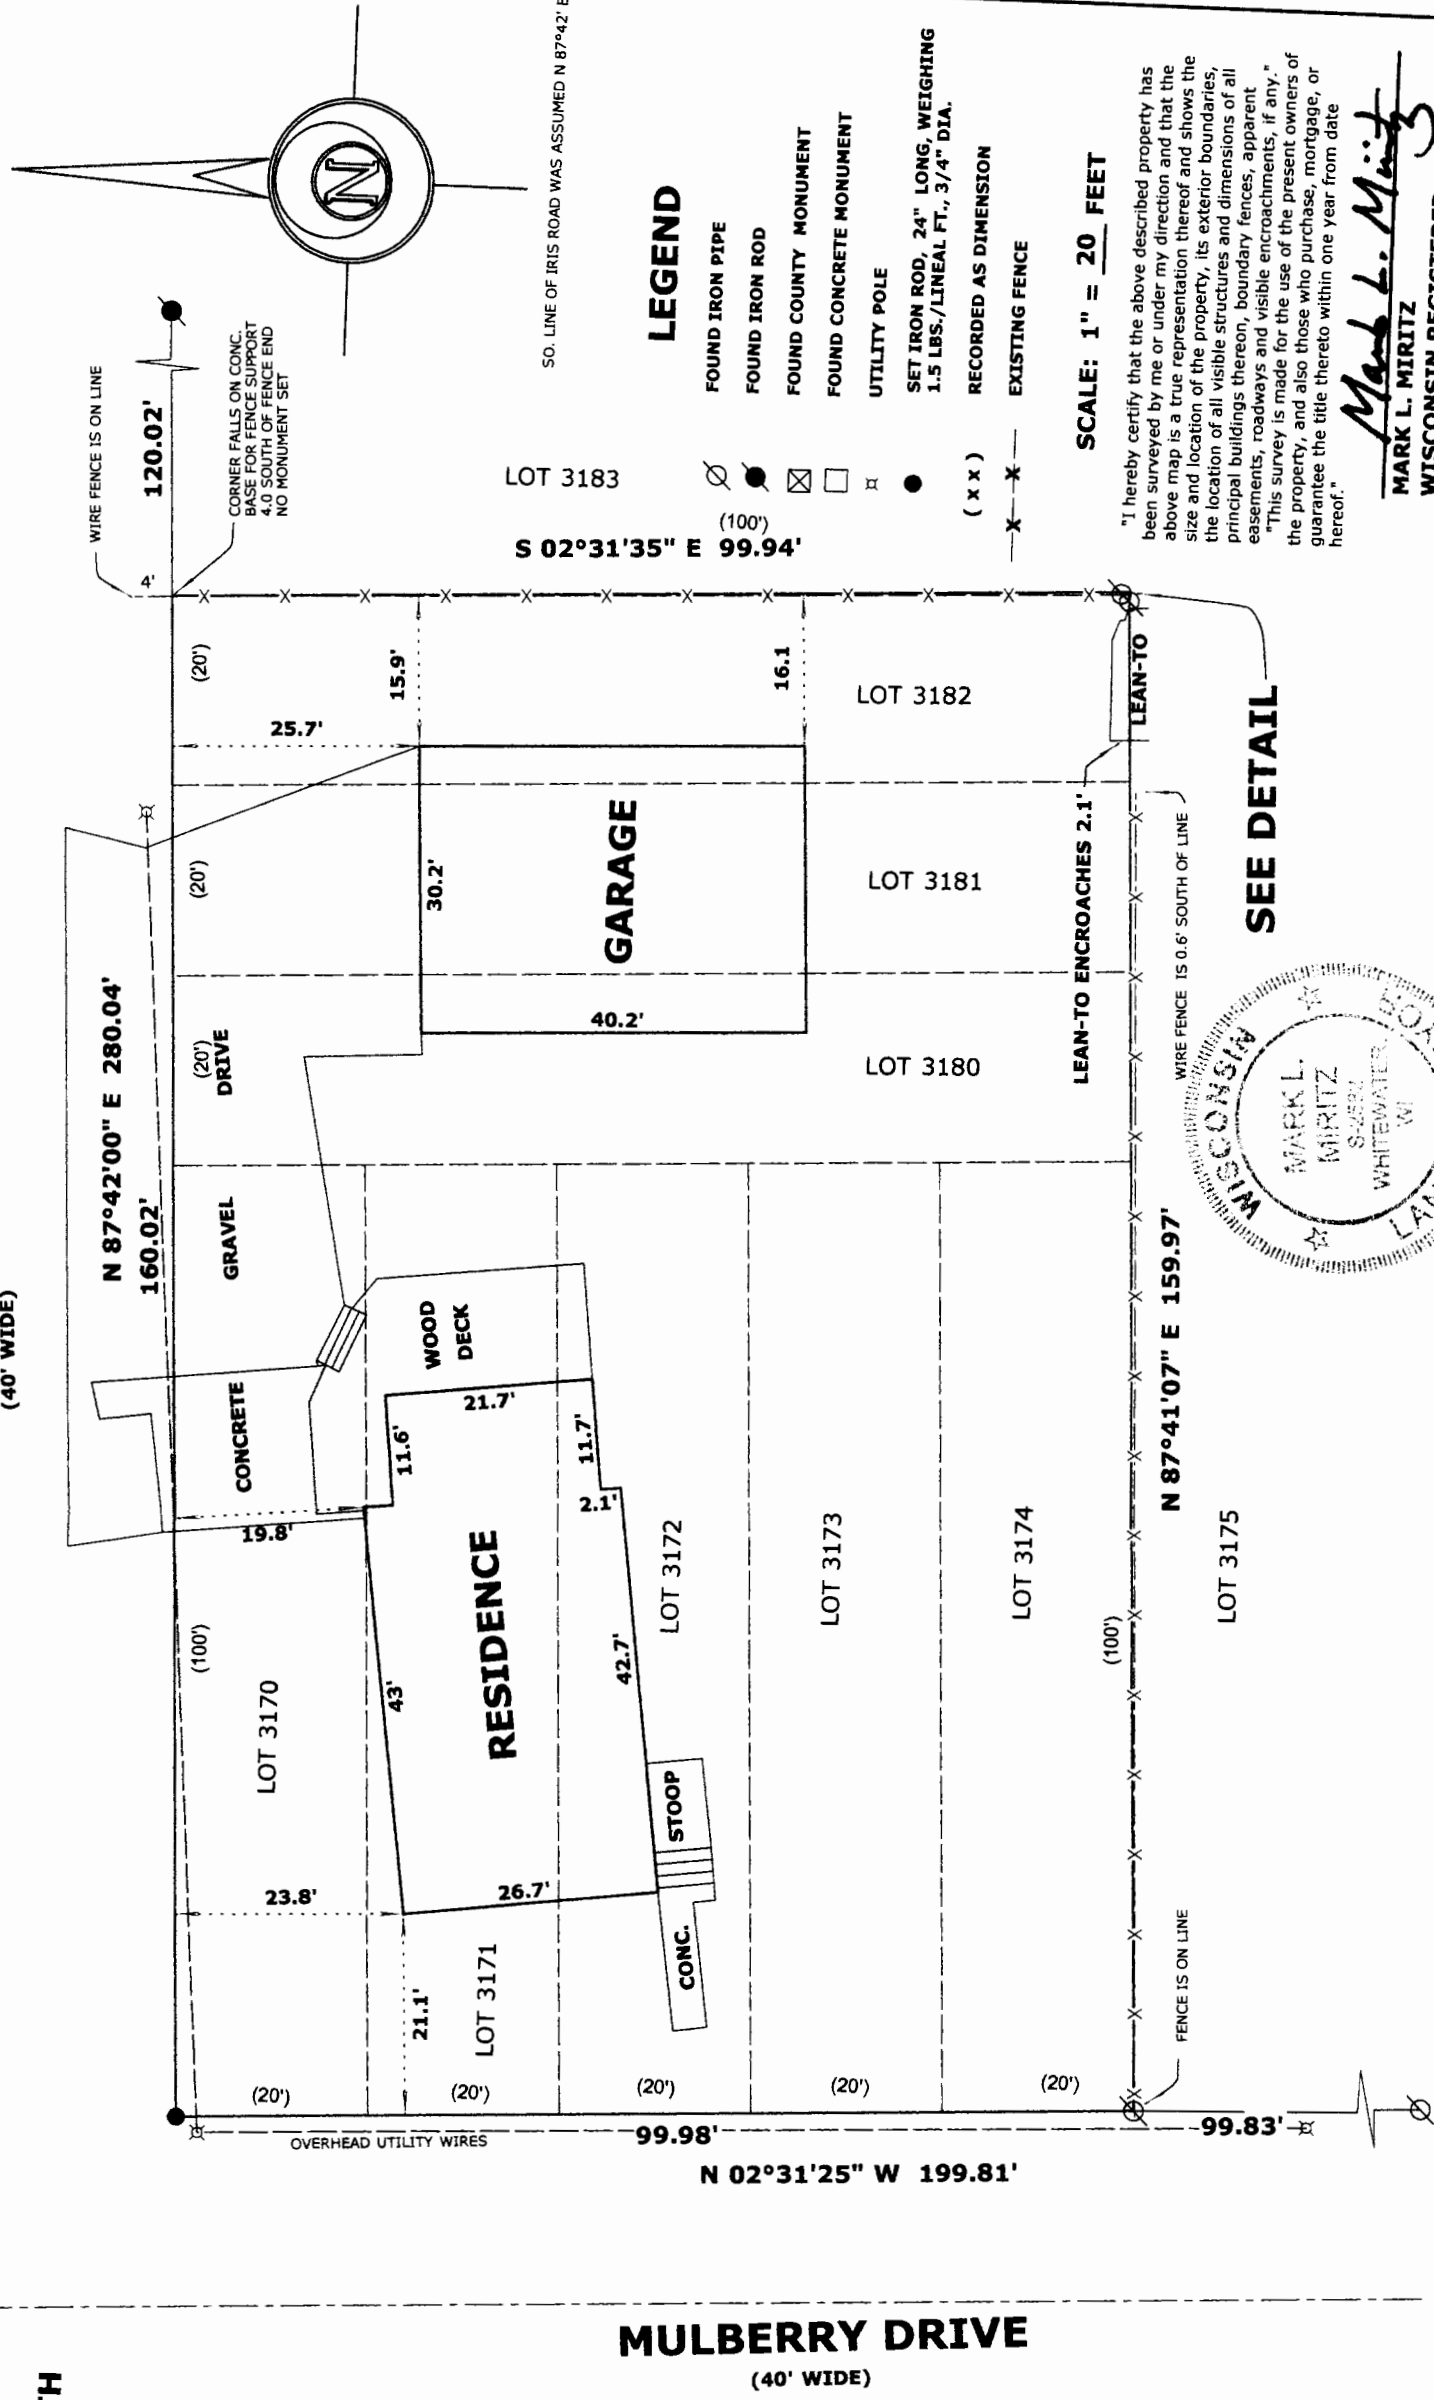

"I hereby certify that the above described property has been surveyed by me or under my direction and that the above map is a true representation thereof and shows the size and location of the property, its exterior boundaries, the location of all visible structures and dimensions of all principal buildings thereon, boundary fences, apparent easements, roadways and visible encroachments, if any." "This survey is made for the use of the present owners of the property, and also those who purchase, mortgage, or guarantee the title thereto within one year from date hereof."

Mark L. Miritz
MARK L. MIRITZ
WISCONSIN REGISTERED
LAND SURVEYOR S-2582

DATE: MARCH 2, 2006 JOB NO. 06.210

118-2751

MPL-661