


HAROLD H. KOLB

REGISTERED PROFESSIONAL LAND SURVEYOR
LAKE GENEVA, WISCONSIN

HYACINTH ROAD

MOSS DRIVE

JASMINE DRIVE

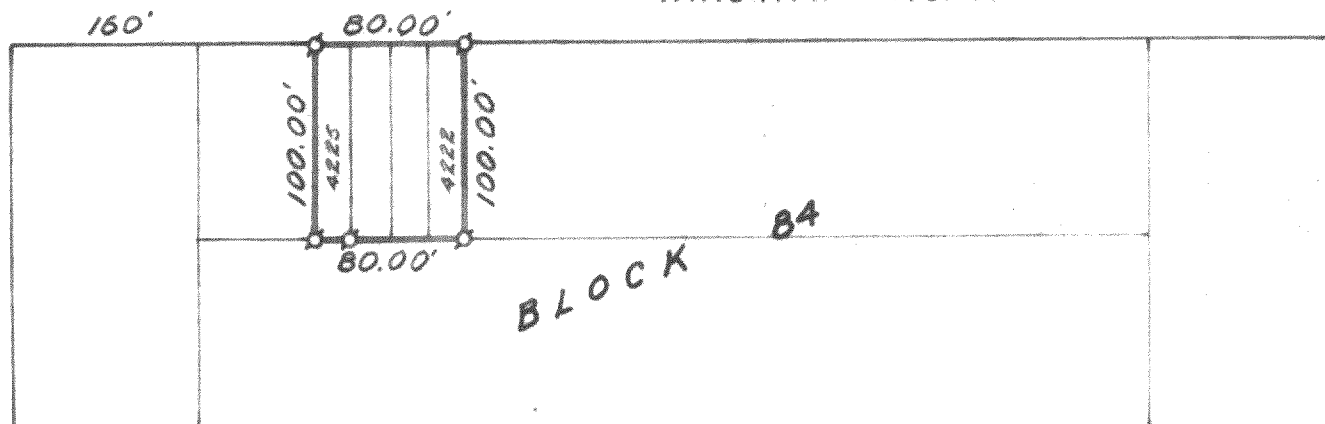

JUNEAU ROAD


Plat of Survey of
Lots 4222-4225, Block 84, Bell Lake, Walworth County, Wisconsin.



SCALE: 1" = 100'

LEGEND

- ⌘ — IRON PIPE FOUND
- — IRON PIPE PLACED
- — CONCRETE MONUMENT
- x — SPIKE

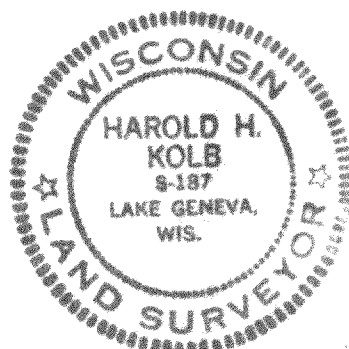

I, HAROLD H. KOLB, DO HEREBY CERTIFY THAT I HAVE
SURVEYED THE PROPERTY HEREON DESCRIBED ACCORDING
TO THE OFFICIAL RECORDS, AND THAT THE PLAT HEREON
IS A CORRECT REPRESENTATION OF THE LOT LINES.

Harold H. Kolb

HAROLD H. KOLB

WISCONSIN REGISTERED LAND SURVEYOR, S-187

DATE August 22, 1969

MPL-892

118-277

1-18-77